
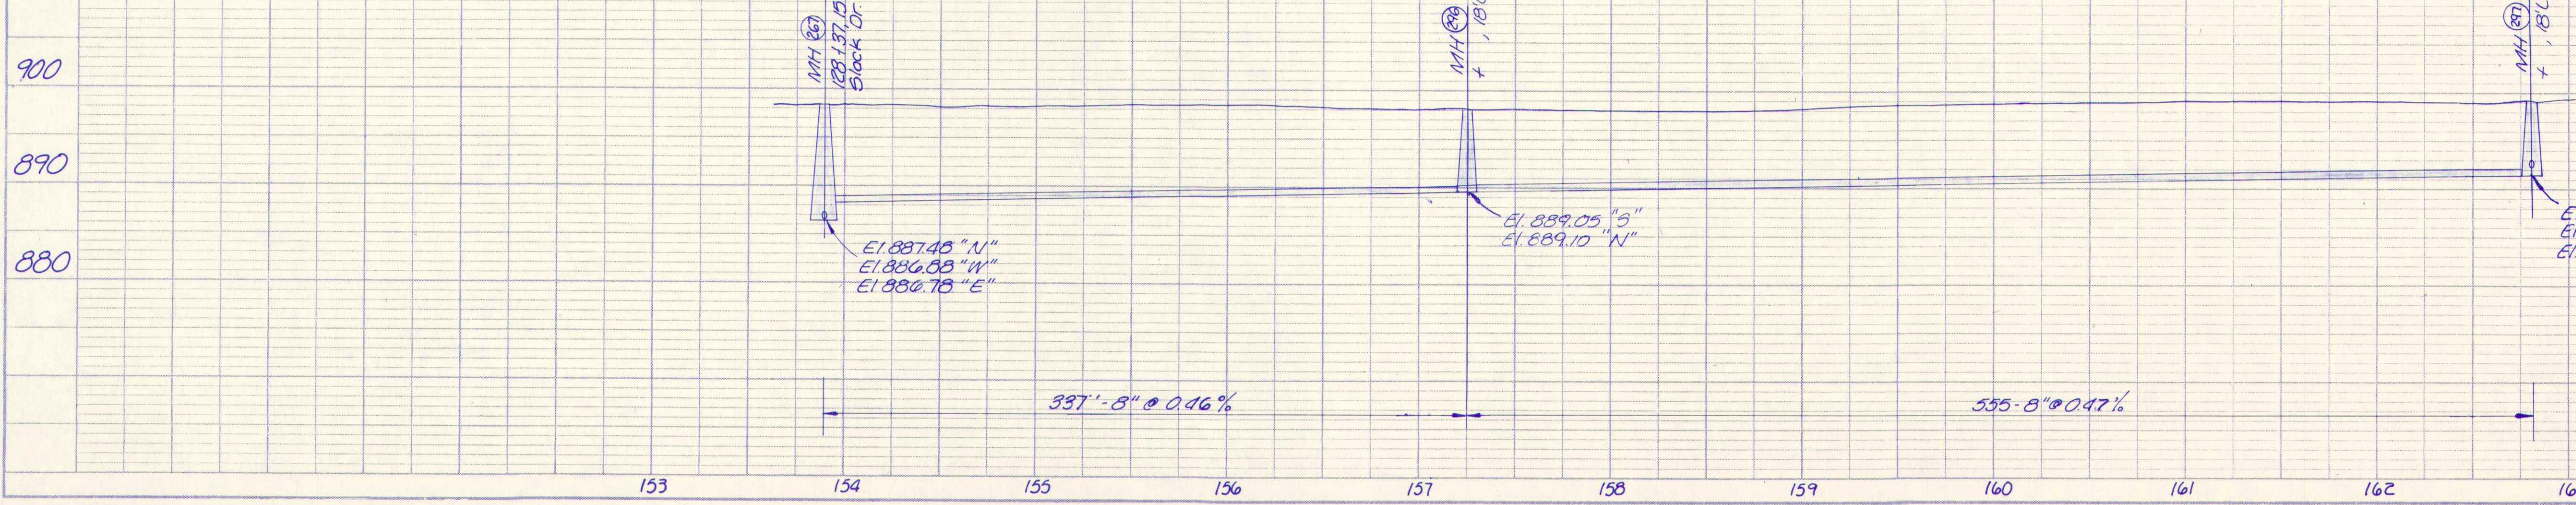
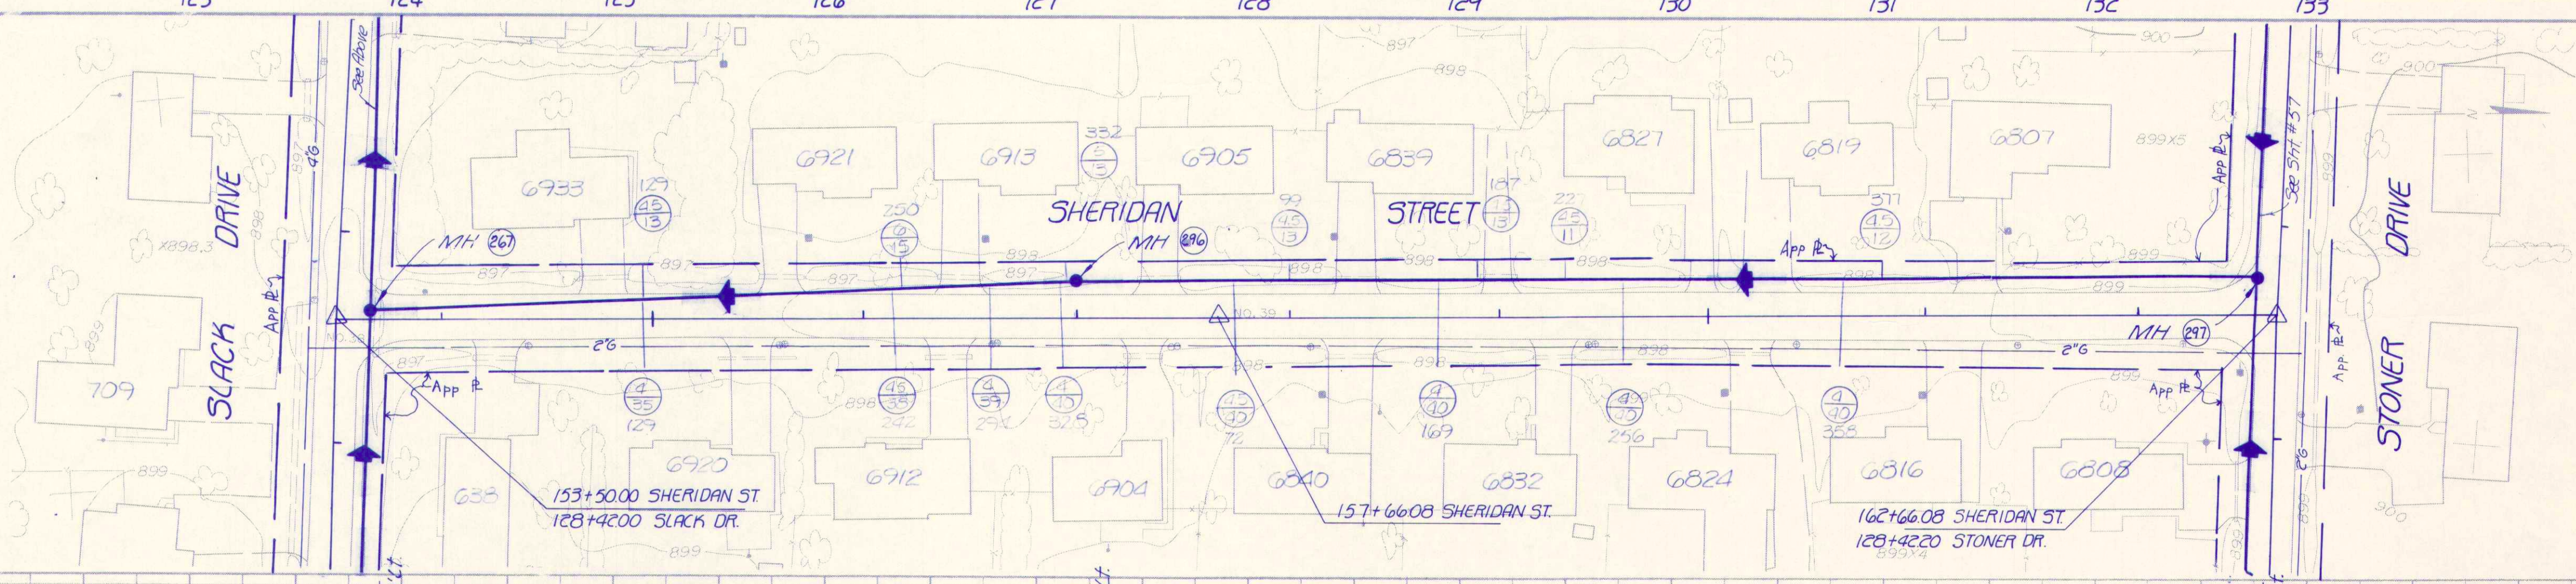
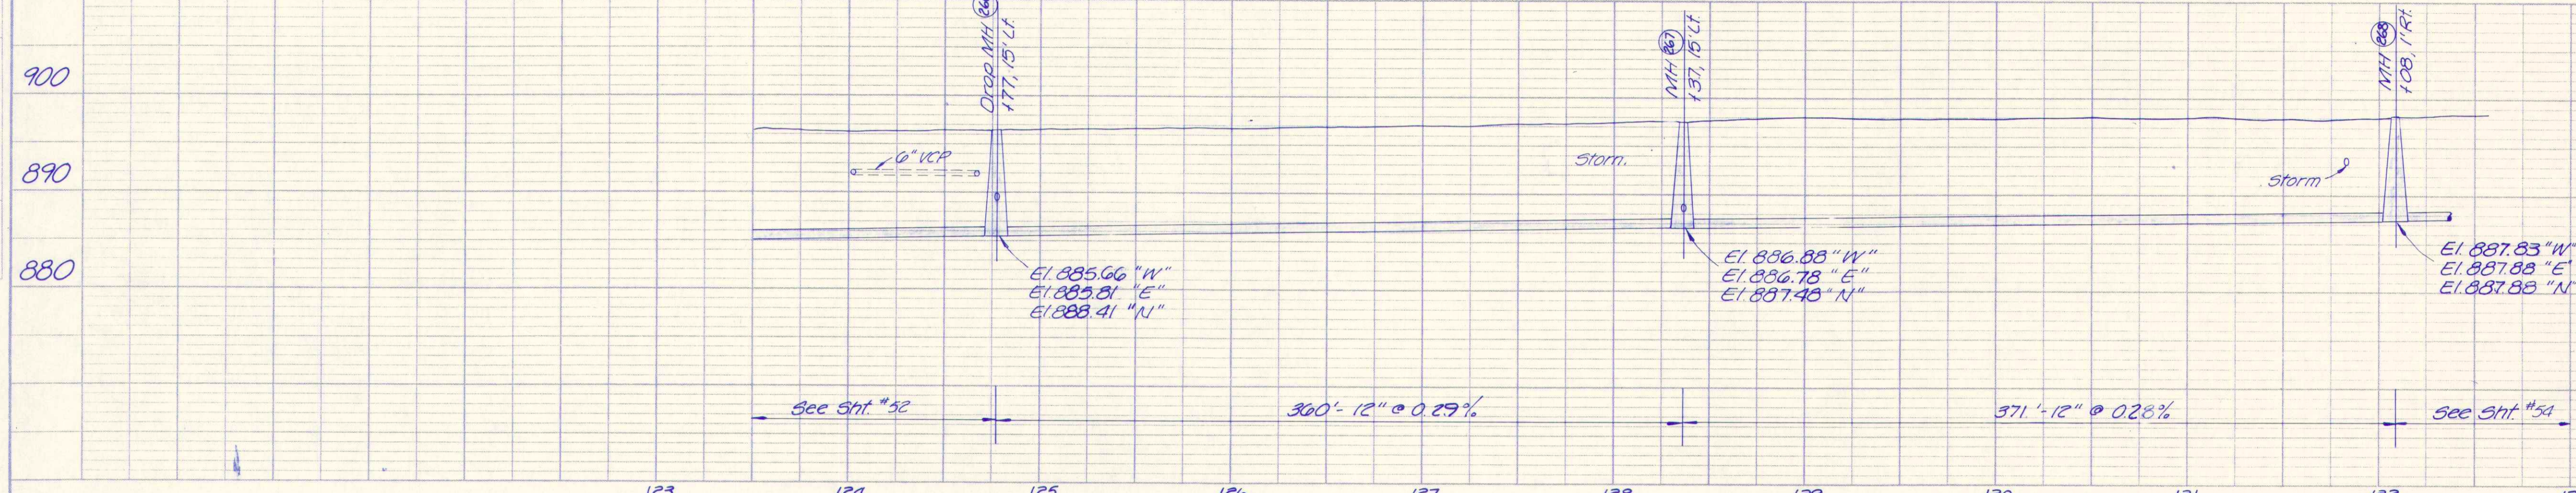


PLAN	DATE	
	BY	
	NO.	
	REVISION	

PROFILE	DATE	
	BY	
	NO.	
	REVISION	

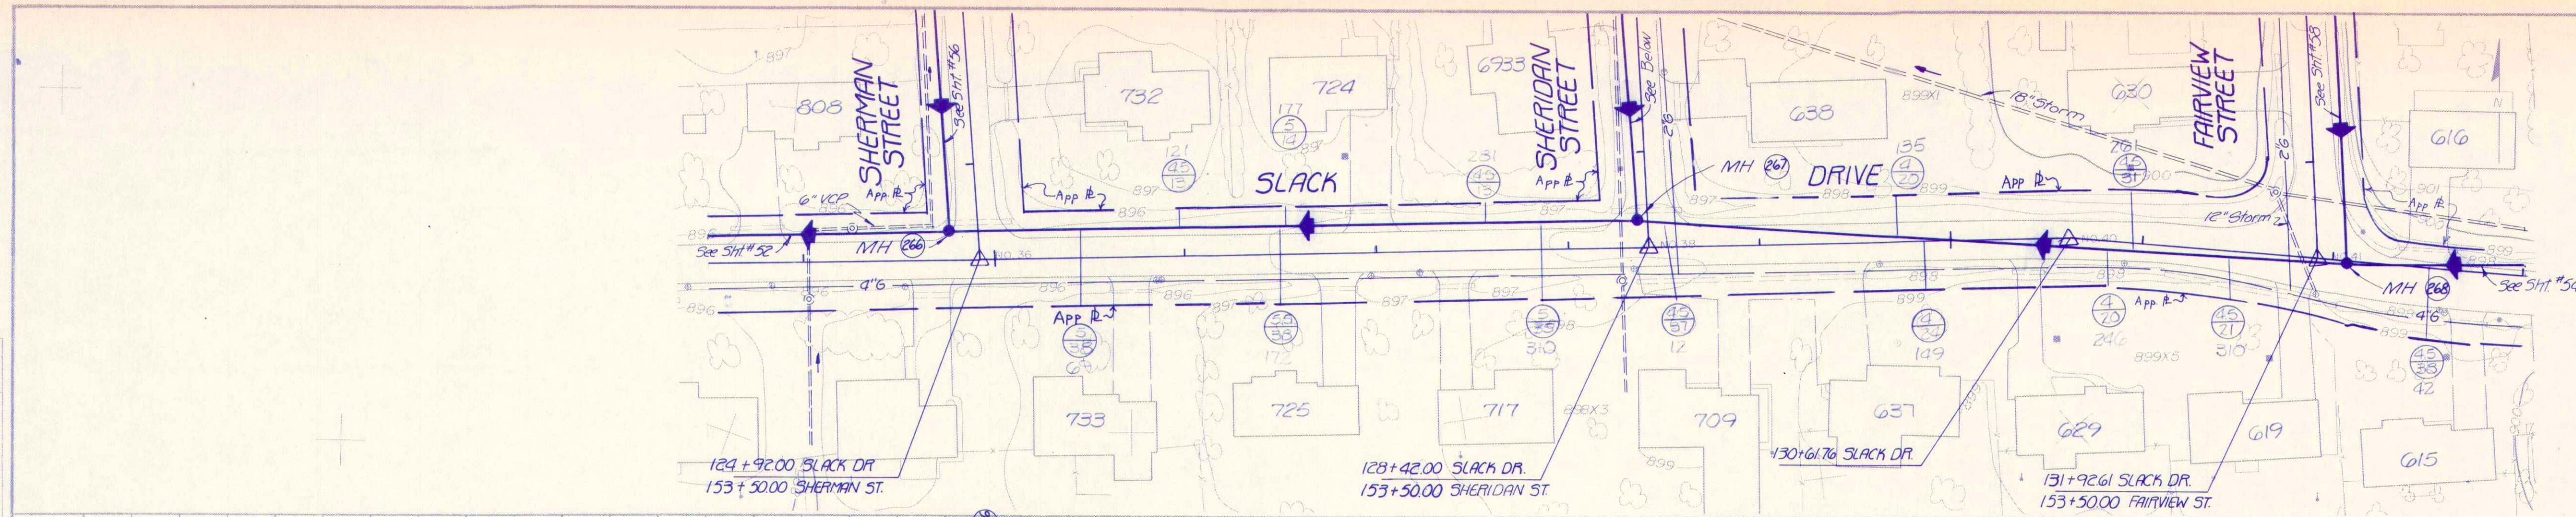

RECORD DRAWING