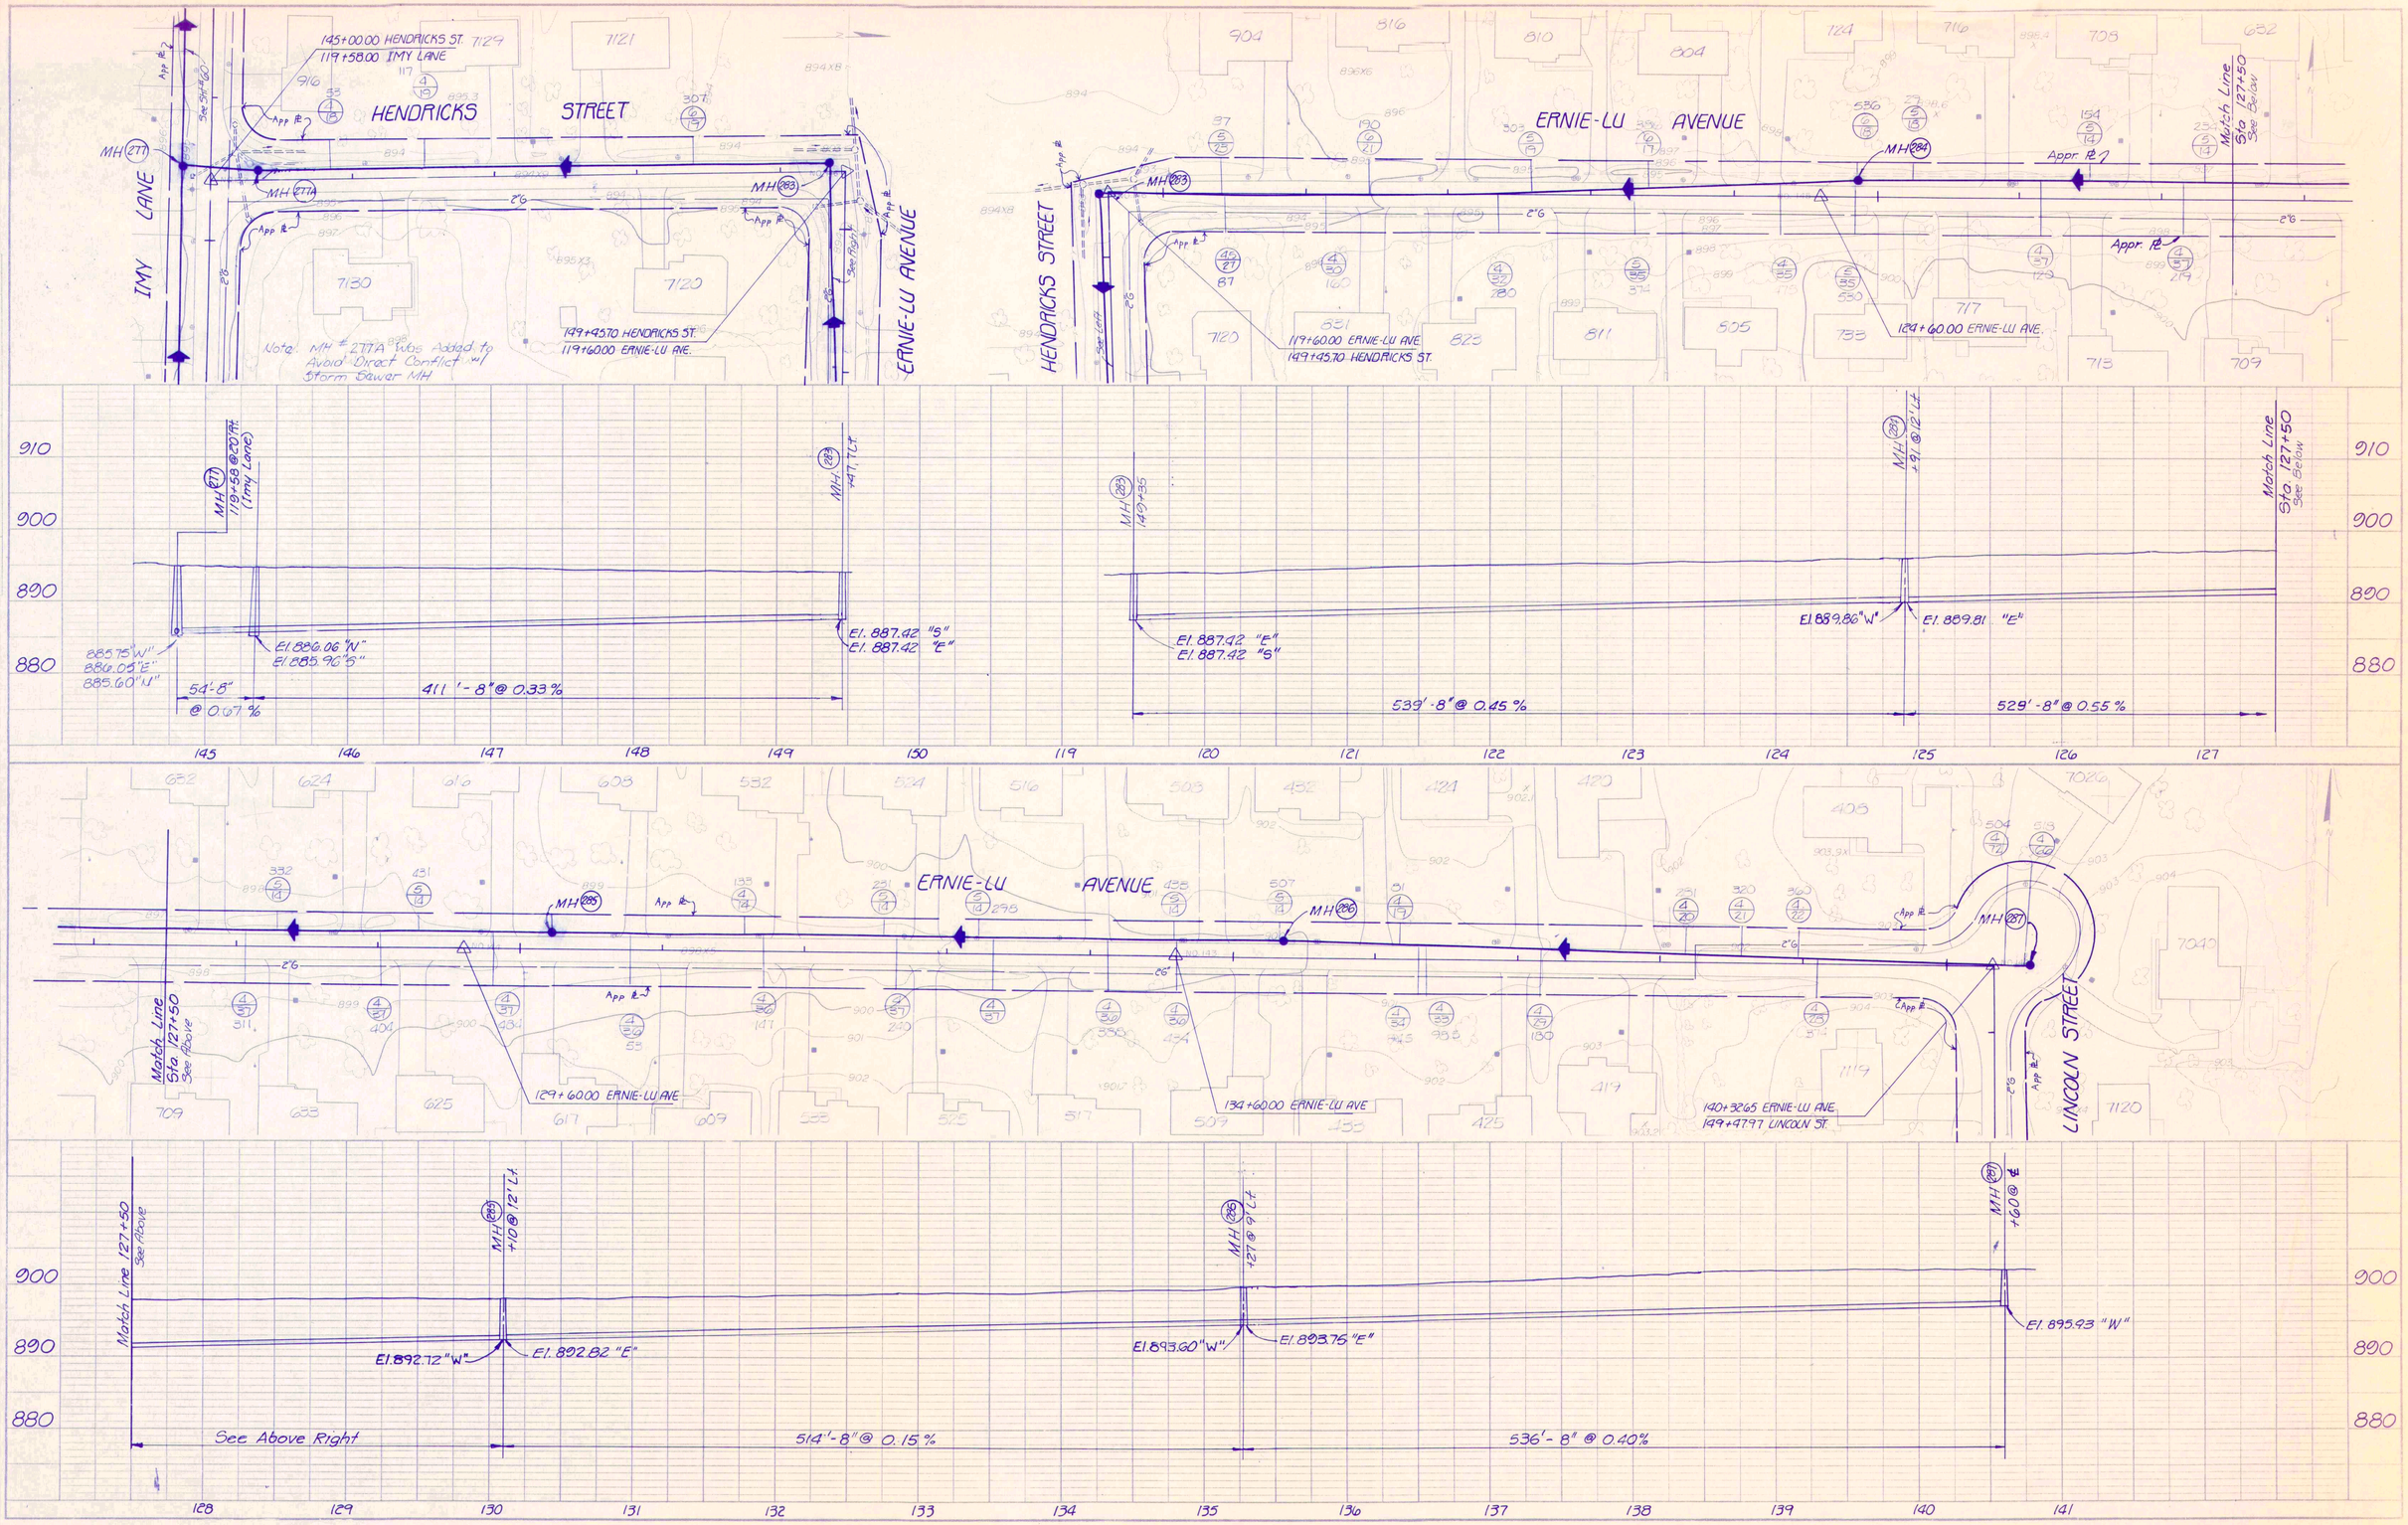

RECORD DRAWING

HENDRICKS ST./ERNIE-LU AVE.		
FALL CREEK R.W.D. PLAN & PROFILE		SHEET
HORIZ. 1"=50'	BEAM, LONGEST & NEFF, INC. CONSULTING ENGINEERS INDIANAPOLIS, INDIANA	61
VERT. 1"=10'		