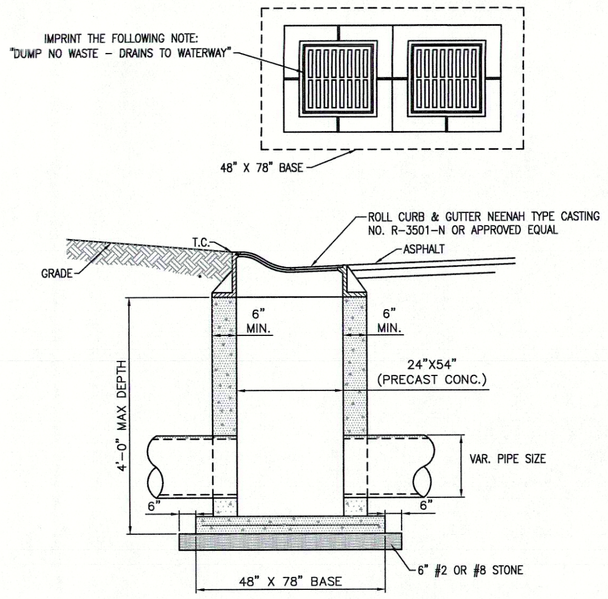

DOUBLE ROLL CURB INLET

NOT TO SCALE

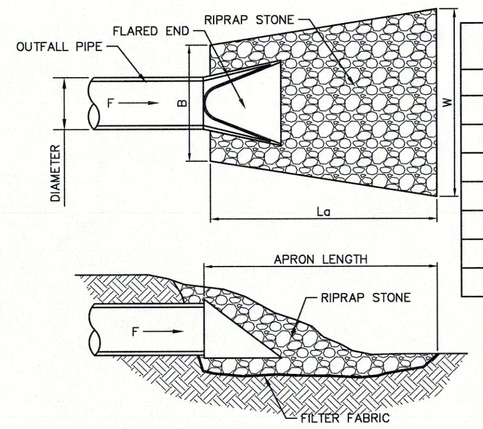

SIZE	B(ft)	La(ft)	W(ft)	Thickness(in)
12"	3	6	9	12"
15"	3.75	8	11.75	12"
18"	4.5	10	14.5	12"
24"	6	13	19	12"
27"	6.75	14	20.75	15"
30"	7.5	16	18.5	18"
36"	9	20	23	18"
42"	10.5	22	25.5	18"

RIP-RAP PLACEMENT

NOT TO SCALE

STANDARD DETAIL – MADISON COUNTY, INDIANA

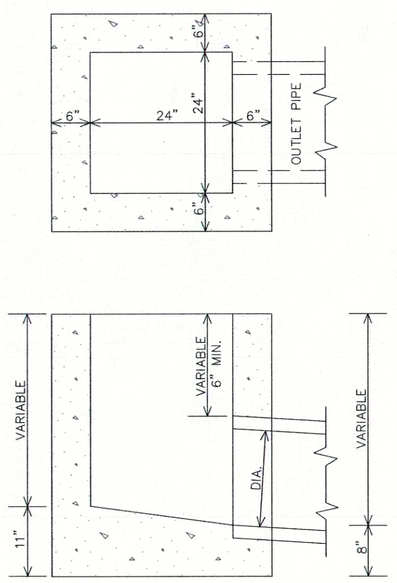

TYPE "A" INLET (MODIFIED)
(12" TO 18" PIPES)

DRAWING NOT TO SCALE

MADISON COUNTY HIGHWAY ENGINEER'S OFFICE

APPROVED: MADISON COUNTY ENGINEER DATE
APPROVED: MADISON COUNTY BOARD OF COMMISSIONERS DATE
REVISED:
STANDARD DETAIL

A-INLET-MODIFIED.DWG

E-8

GENERAL NOTE FOR ALL STORM STRUCTURES:
BENCH WALLS SHALL BE SHAPED AND FORMED FOR A CLEAN TRANSITION WITH PROPER HYDRAULICS TO ALLOW THE SMOOTH TRANSITION OF FLOWS THROUGH THE MANHOLE OR BOX INLET. THE BENCH WALL SHALL FORM A DEFINED CHANNEL TO A MINIMUM HEIGHT OF 80-PERCENT OF THE INSIDE DIAMETER OF THE INLET AND OUTLET PIPES TO FORM A "U" SHAPED CHANNEL, CONSTRUCTED AT A MINIMUM ½ INCH PER FOOT SLOPE TO THE MANHOLE WALL.

STANDARD DETAIL – MADISON COUNTY, INDIANA

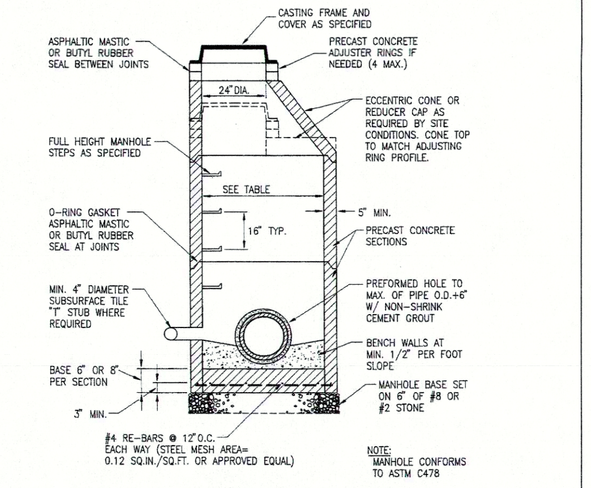

Pipe Size	Pipes entering or leaving at a 0-45 degree angle	Pipes entering or leaving at a 46-90 degree angle
12"-21"	48"	48"
24"	48"	60"
27" - 30"	60"	60"
33" - 36"	60"	72"

STORM MANHOLE FOR 12" THRU 24" PIPES

DRAWING NOT TO SCALE

MADISON COUNTY HIGHWAY ENGINEER'S OFFICE

APPROVED: MADISON COUNTY ENGINEER DATE
APPROVED: MADISON COUNTY BOARD OF COMMISSIONERS DATE
REVISED:
STANDARD DETAIL

12-24STORM-MH.DWG

E-1

STANDARD DETAIL – MADISON COUNTY, INDIANA

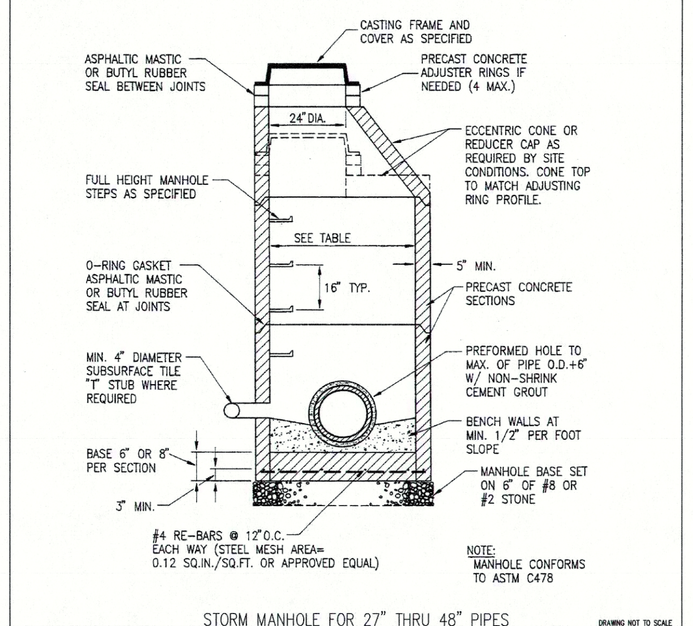

STORM MANHOLE FOR 27" THRU 48" PIPES

DRAWING NOT TO SCALE

MADISON COUNTY HIGHWAY ENGINEER'S OFFICE

APPROVED: MADISON COUNTY ENGINEER DATE
APPROVED: MADISON COUNTY BOARD OF COMMISSIONERS DATE
REVISED:
STANDARD DETAIL

27-48STORM-MH.DWG

E-2

STANDARD DETAIL – MADISON COUNTY, INDIANA

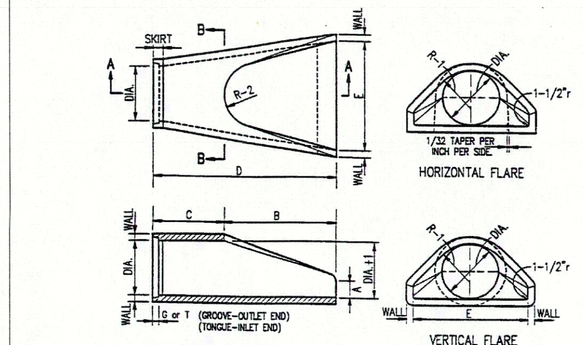

SECTION AA

SECTION BB

DIA.	WALL	C or T	WT.	SEC.	A	B	C	D	E	DIA.x.5	R-1	R-2	SKIRT

NOTES: 1. MANUFACTURE OF END SECTION IS IN ACCORDANCE WITH APPLICABLE PORTIONS OF A.S.T.M. SPECIFICATION C76.

CONCRETE END SECTION

DRAWING NOT TO SCALE

MADISON COUNTY HIGHWAY ENGINEER'S OFFICE

APPROVED: MADISON COUNTY ENGINEER DATE
APPROVED: MADISON COUNTY BOARD OF COMMISSIONERS DATE
REVISED:
STANDARD DETAIL

CONCRETEENDSECTION.DWG

E-24

STANDARD DETAIL – MADISON COUNTY, INDIANA

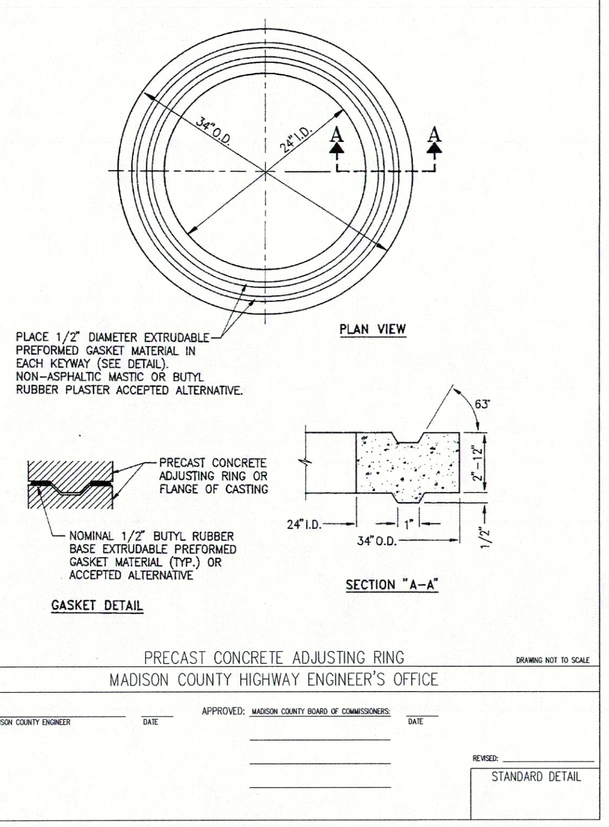

PRECAST CONCRETE ADJUSTING RING

DRAWING NOT TO SCALE

MADISON COUNTY HIGHWAY ENGINEER'S OFFICE

APPROVED: MADISON COUNTY ENGINEER DATE
APPROVED: MADISON COUNTY BOARD OF COMMISSIONERS DATE
REVISED:
STANDARD DETAIL

ADJ-RING.DWG

E-6

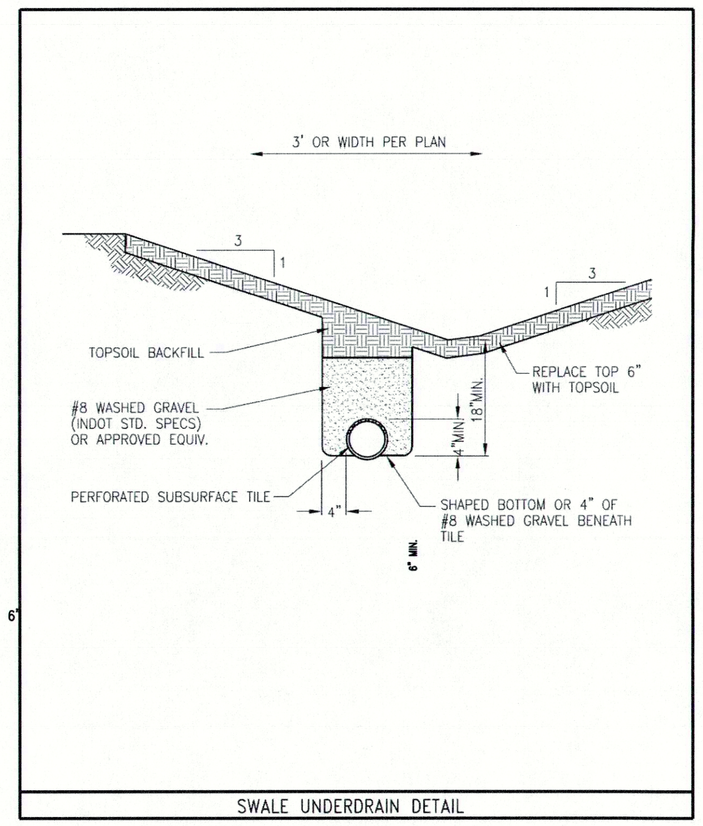

SWALE UNDERDRAIN DETAIL

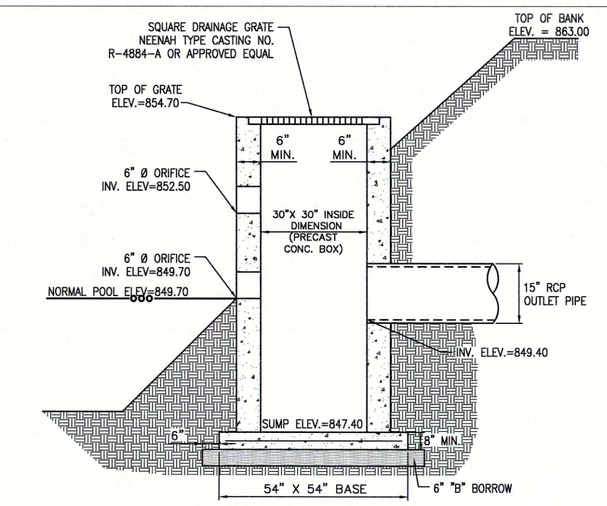

LAKE #1 OUTLET CONTROL STRUCTURE (STR.#108)

NOT TO SCALE

REVISIONS		
DATE	DESCRIPTION	BY
02/05/19	REVISIONS PER CLIENT AND COUNTY COMMENTS	HWC

HWC ENGINEERING
INDIANAPOLIS - TERRE HAUTE
LAFAYETTE - MUNICE - NEW ALBANY
www.hwcengineering.com

SPRINGBROOK SECTION 1A CONSTRUCTION DETAILS

SEAN M. DOWNEY REGISTERED No. 10200309 STATE OF INDIANA PROFESSIONAL ENGINEER

DRAWN BY TD	JOB NUMBER 2017-271-A
CHECKED BY SD	
DATE NOVEMBER 8, 2018	
SCALE AS SHOWN	
SHEET C8.2 CONSTRUCTION DETAILS	

© 2018

Plot Date: Feb 06, 2019 Plot Time: 7:24am File Name: W:\CoIAtlantic Homes\2017-271-A CoIAtlantic- Springbrook Sect 1\Design\CAD\17271-A.Construction Details.dwg, Layout: C8.2 By: sdowney