

REVISIONS		
DATE	DESCRIPTION	BY
01/16/19	REV. PER FORWARD & IDEM	JEF
	COMMENTS	





SIMS-DURKIN ASSOCIATES
ENGINEERING COMPANY
1548 COUNTRY CLUB ROAD INDIANAPOLIS, INDIANA 46234
PHONE: (317) 261-4035 WEBSITE: WWW.SIMS-DURKIN.COM

SPRINGBROOK PRELIMINARY PLAN
MADISON COUNTY, INDIANA
LIFT STATION
PUMP CONTROL PANEL WIRING DIAGRAM CONTD.

DRAWN BY: I.A. SOH
CHECKED BY: JEF
DATE: NOVEMBER 30, 2018
SCALE: AS SHOWN
JOB NUMBER: 2017-271



C5.11
PUMP CONTROL PANEL
WIRING DIAGRAM
CONTINUED

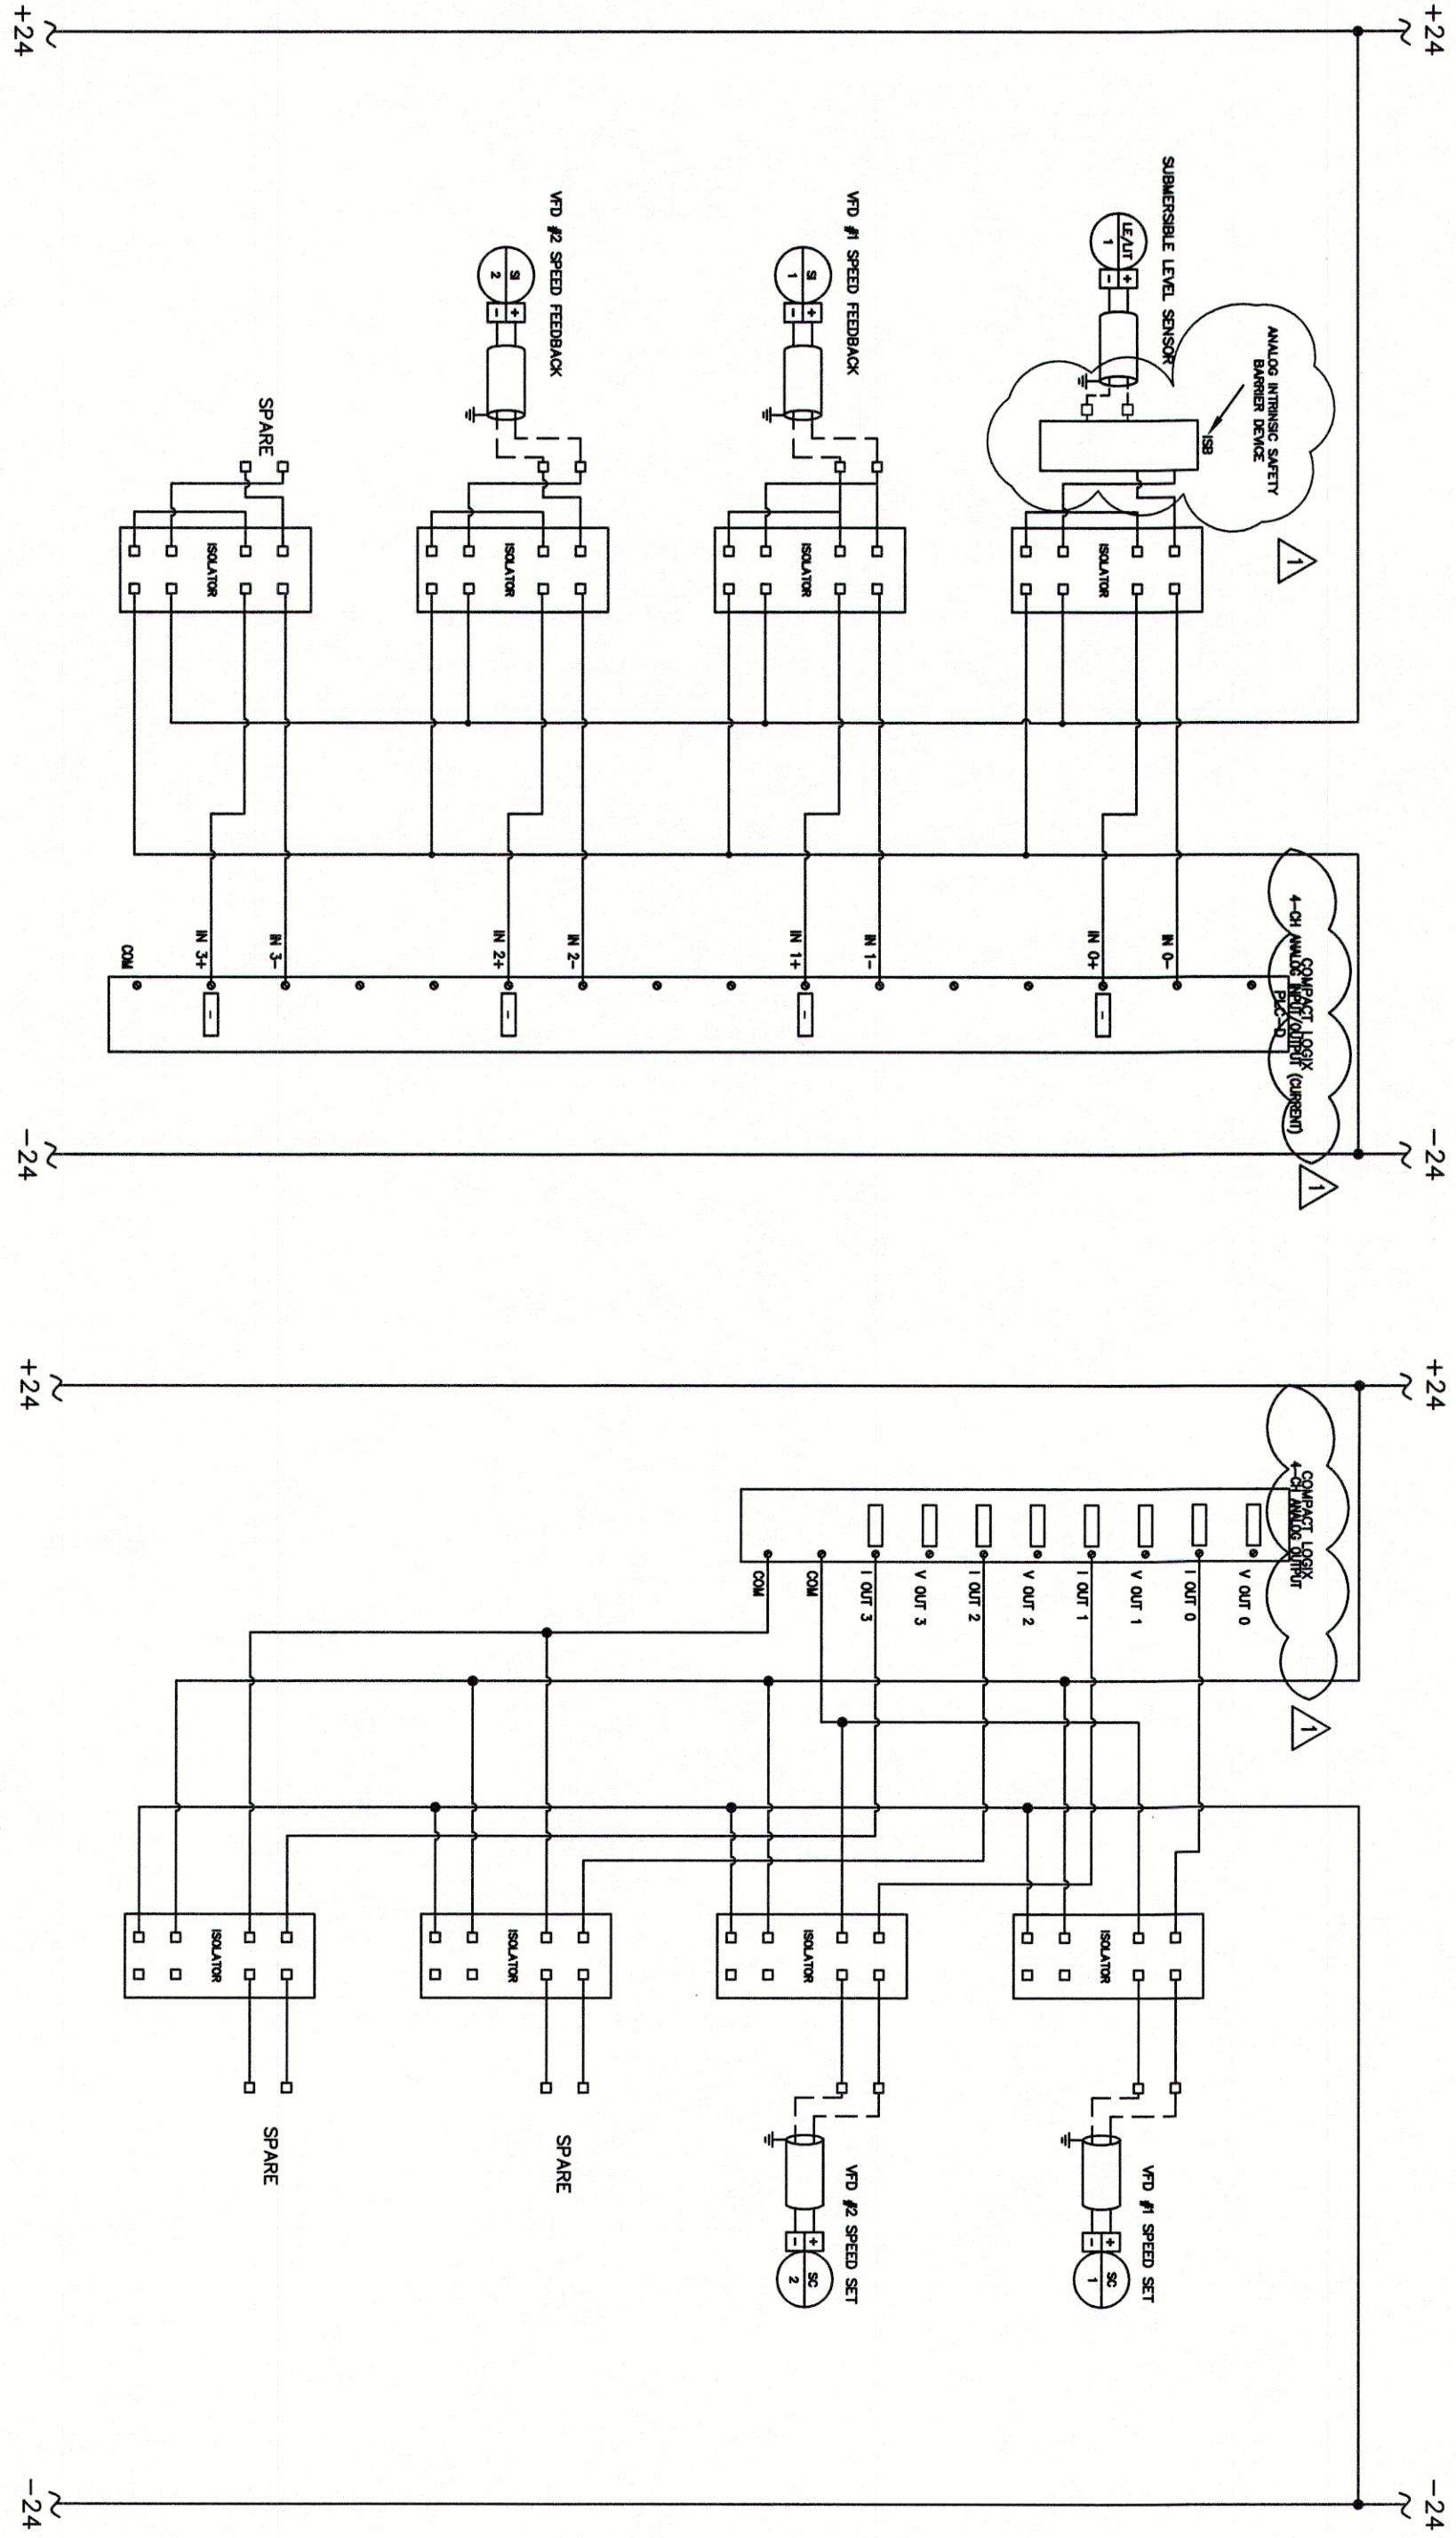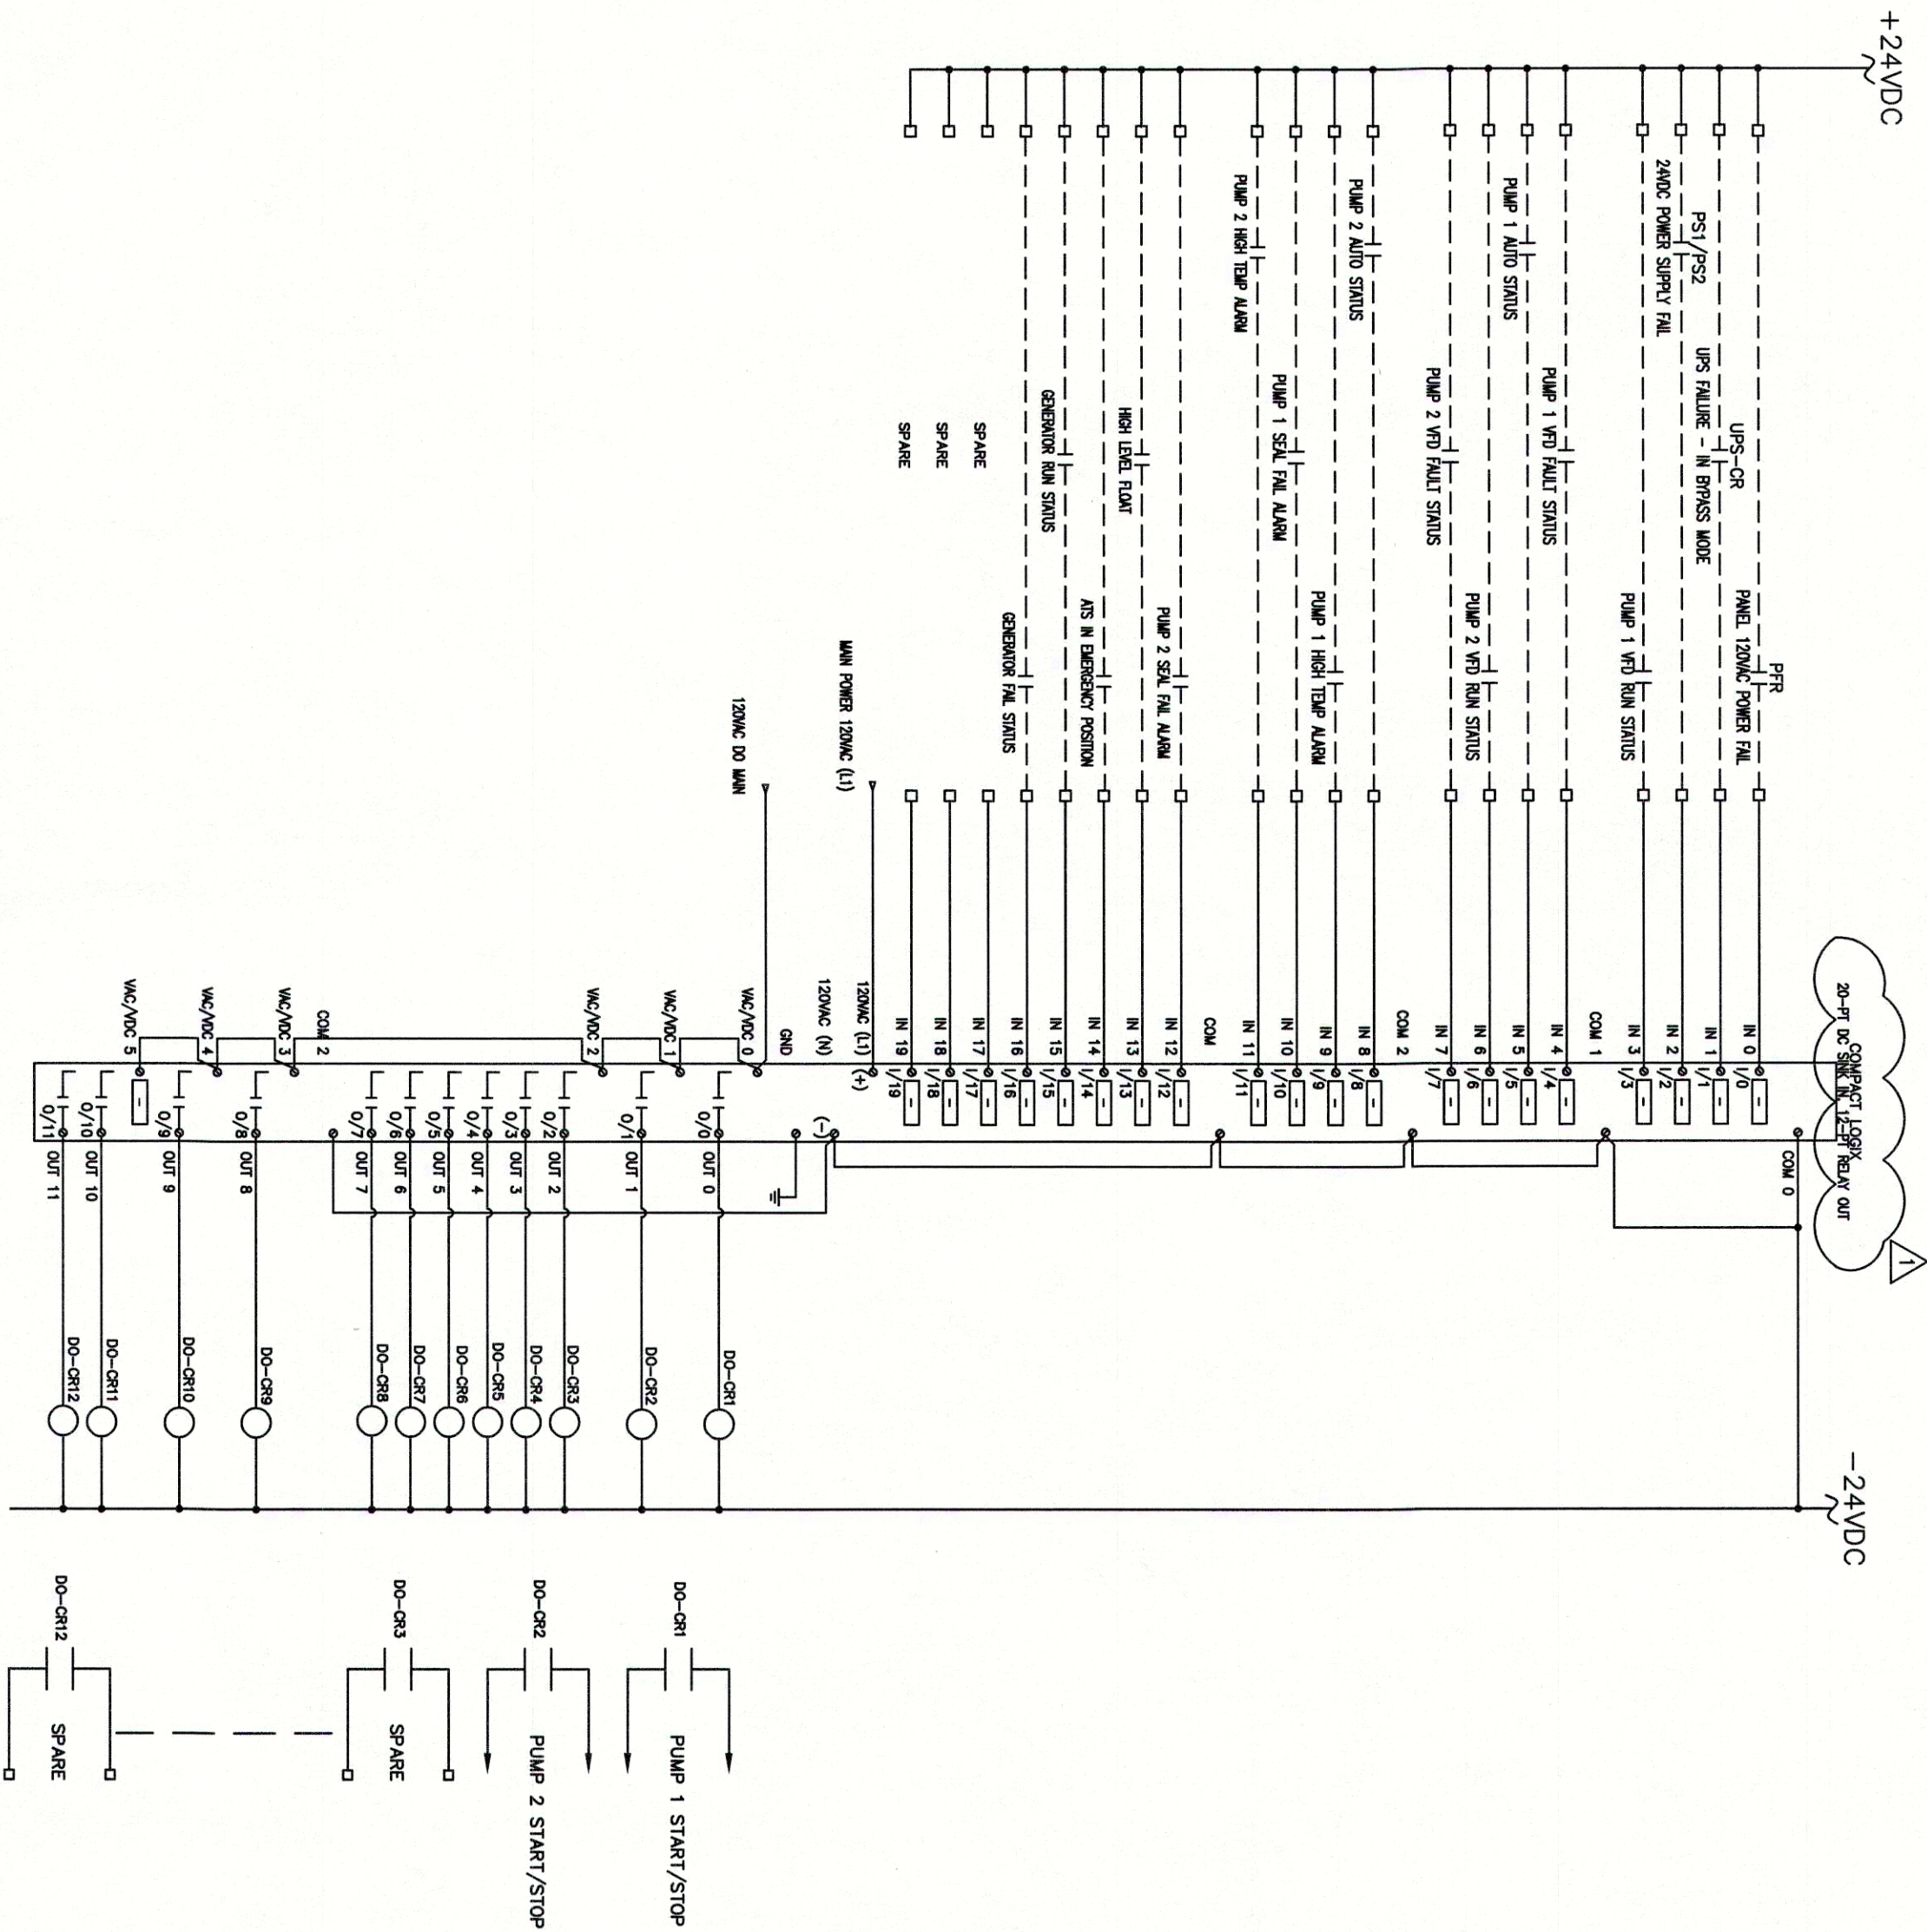

NOTE:
THE CONTRACTOR/PANEL FABRICATOR SHALL BE RESPONSIBLE FOR THE FINAL SELECTION OF COMPONENTS, LAYOUT, FABRICATION, WIRING AND PROGRAMMING. ALL SUBJECT TO SHOP DRAWING REVIEW AND APPROVAL BY THE ENGINEER. THE CONTRACTOR SHALL BE RESPONSIBLE FOR MEETING ALL QUALITY REQUIREMENTS, AND EXPECTATIONS.

CONTROL PANEL WIRING DIAGRAM (CONTINUED)

SCALE: NONE