


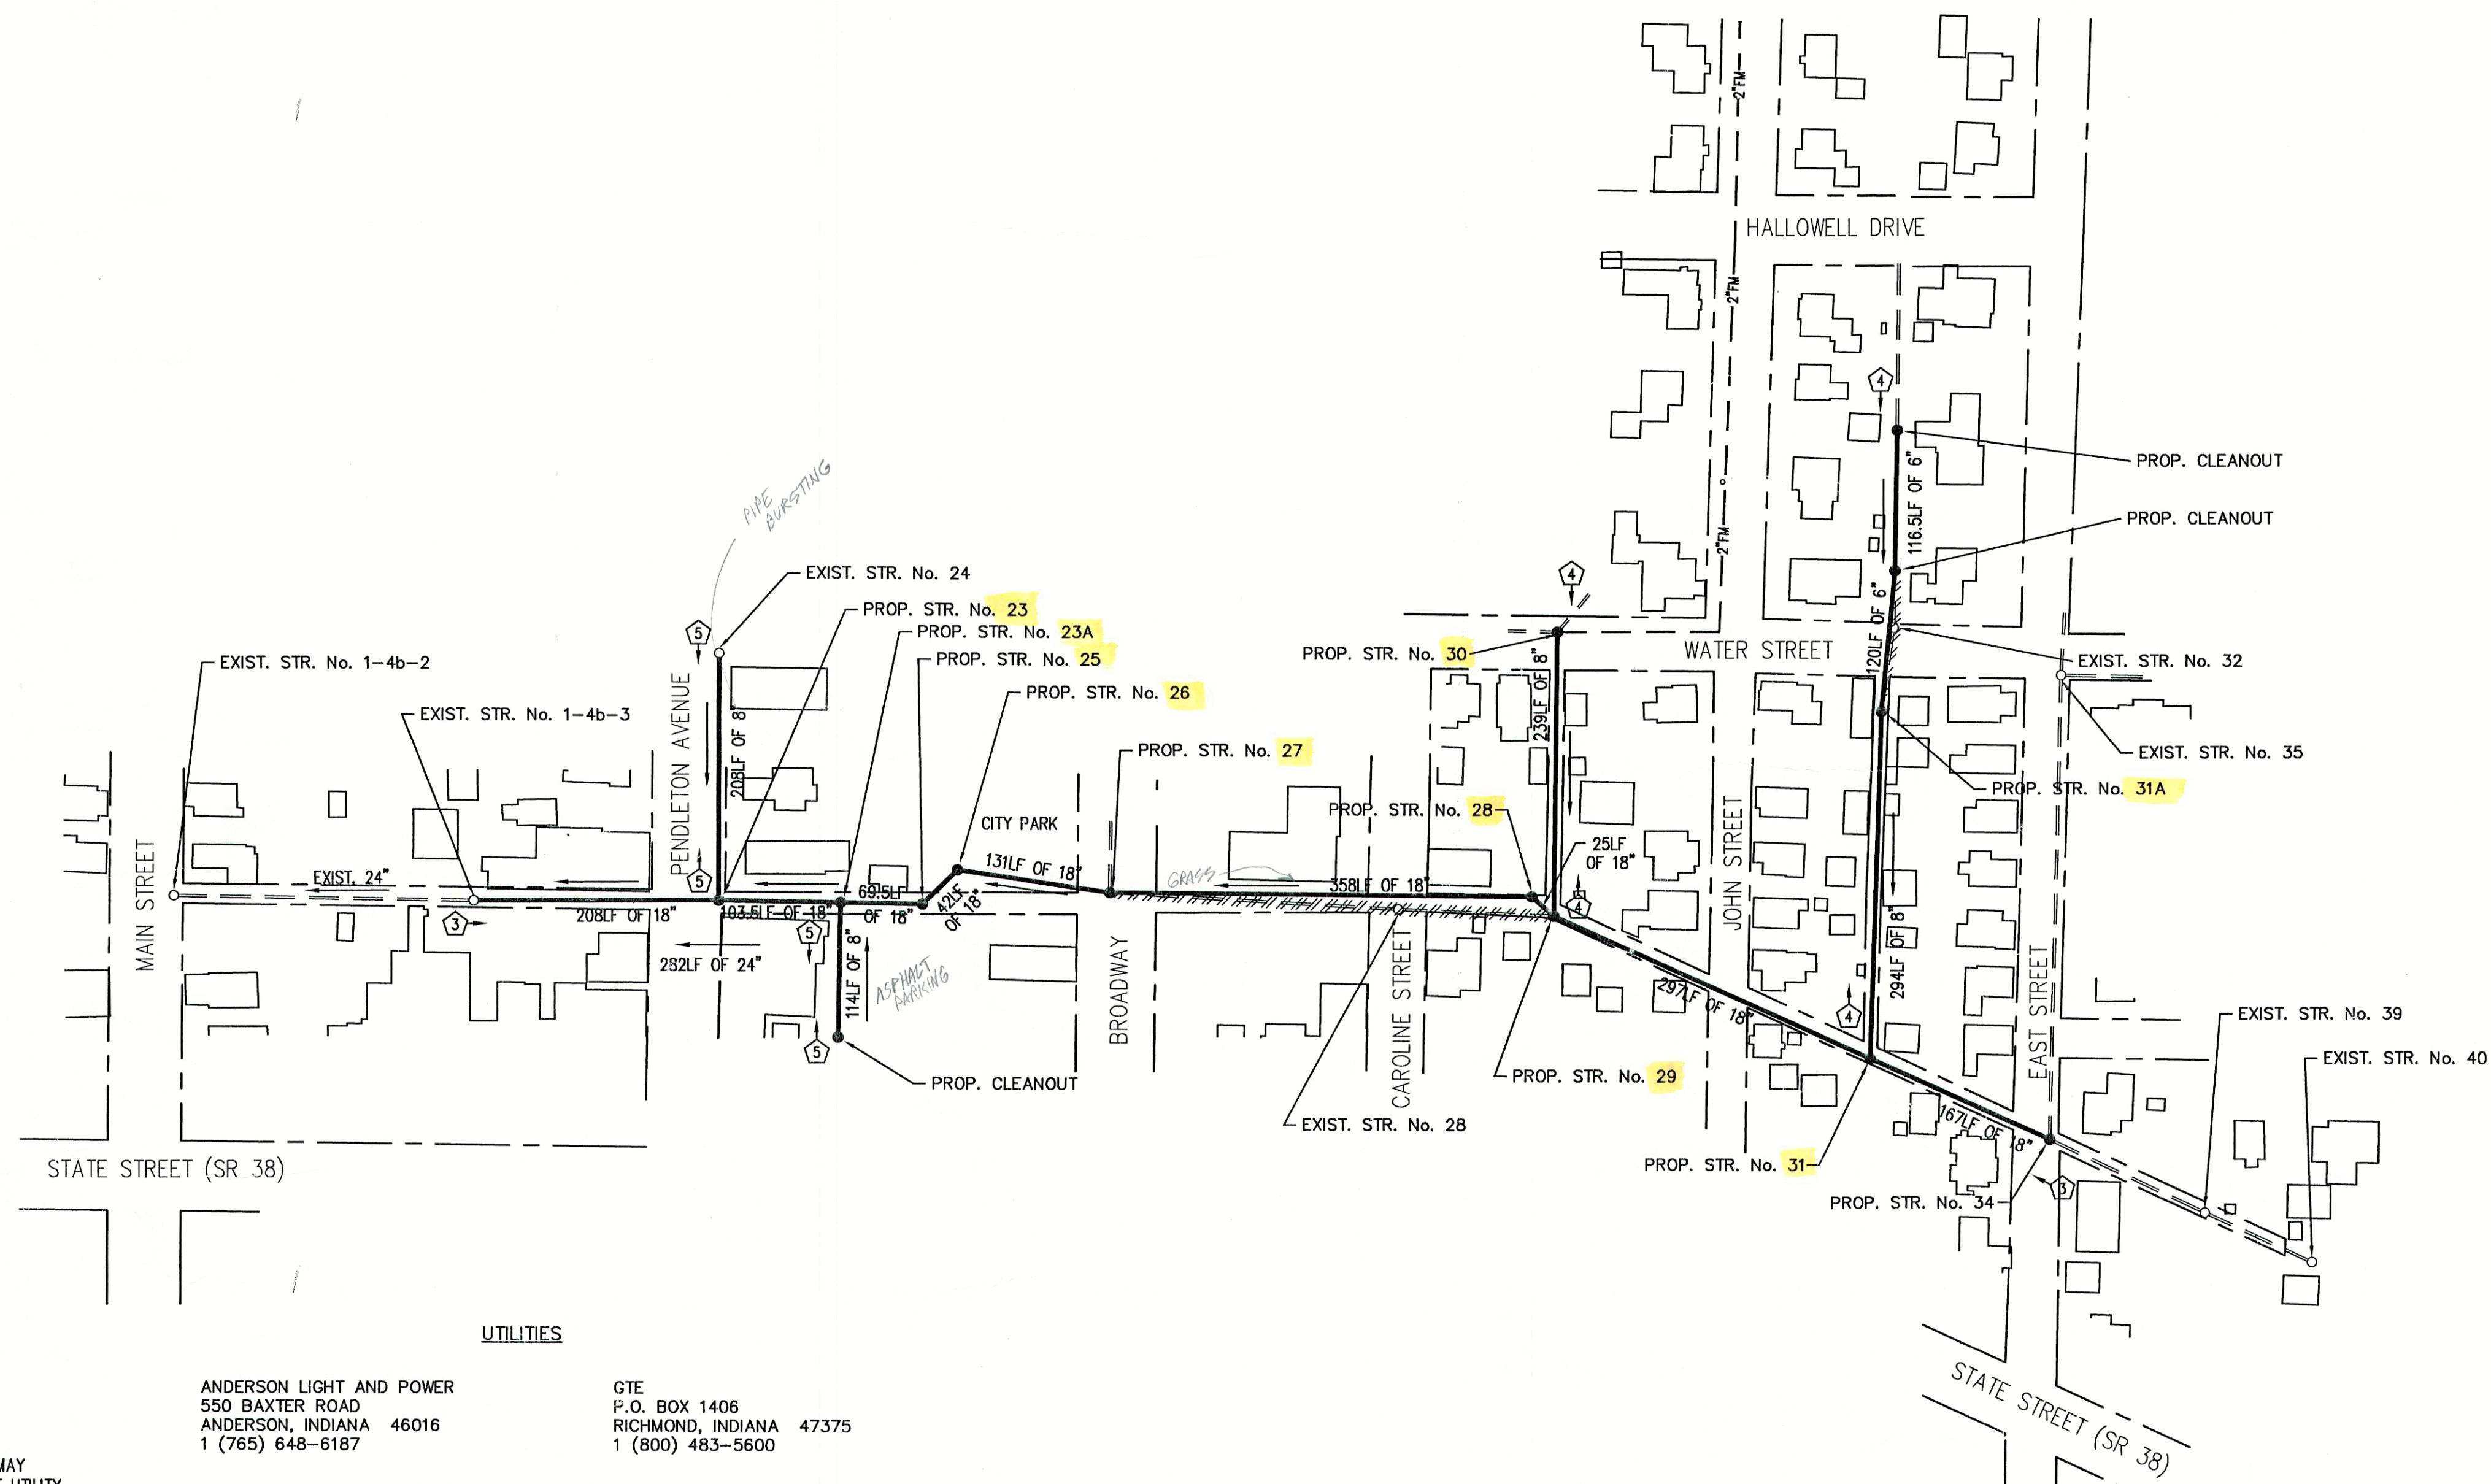

NOTE:
ADDITIONAL RIGHT-OF-WAY OR EASEMENTS MAY
NEED TO BE ACQUIRED FOR INSTALLATION OF UTILITY.



PER INDIANA STATE LAW 15-69-1991, IT IS
AGAINST THE LAW TO EXCAVATE WITHOUT
NOTIFYING THE UNDERGROUND LOCATION SERVICE
TWO (2) WORKING DAYS BEFORE COMMENCING WORK.

ANDERSON LIGHT AND POWER
550 BAXTER ROAD
ANDERSON, INDIANA 46016
1 (765) 648-6187

PENDLETON MUNICIPAL ELECTRIC UTILITY
P.O. BOX 230
PENDLETON, INDIANA 46064
1 (765) 778-2173

PENDLETON MUNICIPAL WATER UTILITY
P.O. BOX 230
PENDLETON, INDIANA 46064
1 (765) 778-2173

GTE
P.O. BOX 1406
RICHMOND, INDIANA 47375
1 (800) 483-5600

INDIANA GAS COMPANY, INC.
2001 LOUISE STREET
ANDERSON, INDIANA 46016
1 (800) 777-2060

TCI OF CENTRAL INDIANA
335 E. 10th STREET
ANDERSON, INDIANA 46016
1 (765) 649-0407

LEGEND:

- 4" — EXISTING SANITARY FORCE MAIN
- — — EXISTING SANITARY SEWER AND MANHOLE TO REMAIN
- /---/--- EXISTING SANITARY SEWER AND MANHOLE TO BE REMOVED AND/OR ABANDONED
- — — PROPOSED SANITARY SEWER AND MANHOLE
- DIRECTION OF FLOW
- ③ SHEET PAGE REFERENCE
- ◆ SOIL BORING - SEE SPECIFICATIONS FOR BORING LOGS

SANITARY SEWER BASE MAP

PENDLETON, INDIANA

NOTE:
ALL PIPE LENGTHS ON THIS SHEET
ARE FOR INFORMATIONAL USE ONLY.

PHASE III: SCOPE OF WORK

SANITARY SEWER FROM 1-4b-3 TO 23, 23 TO 24, 23 TO 23A, 23A TO C/O,
23A TO 25, 25 TO 26, 26 TO 27, 28 TO 29, 29 TO 30, 29 TO 31,
31 TO 31A, 31A TO C/O, 31 TO 34.


BM #66 - STATE HIGHWAY MARKER, SOUTHWEST HEADWALL ON
MAIN STREET BRIDGE OVER FALL CREEK. EL. 840.35

CONSULTANT:

REVISIONS:

DATE	DESCRIPTION	BY

APPROVED BY:

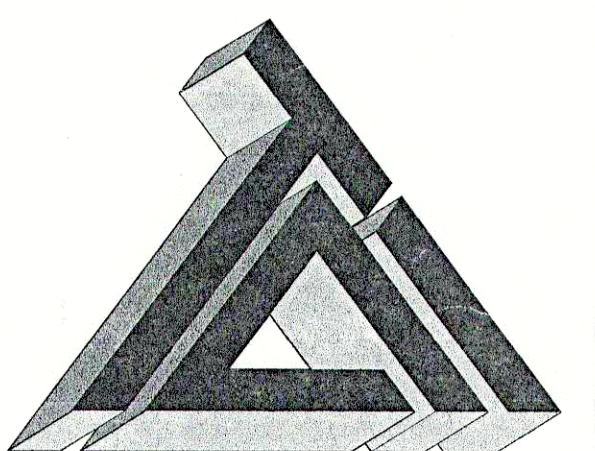

TRIAD ASSOCIATES INC.
5835 LAWTON LOOP EAST DRIVE
INDIANAPOLIS, INDIANA 46216
PHONE: 317-377-5230 FAX: 317-377-5241

DESIGNED FOR:

STATE STREET SANITARY SEWER
PROJECT - PHASE III

SHEET TITLE:

PROPOSED SANITARY
SEWER BASE MAP

JOB NUMBER: 200302G

SCALE: AS NOTED

PLOT SCALE: 1" = 100'

DRAWN BY: J.E.C.

DESIGNED BY: J.E.C.

DRAWING NAME: 200302G-BMAP

CHECKED BY: T.M.S.

PLOT DATE: 09/23/03

DATE: 09/22/03

SHEET No.

2

OF 6