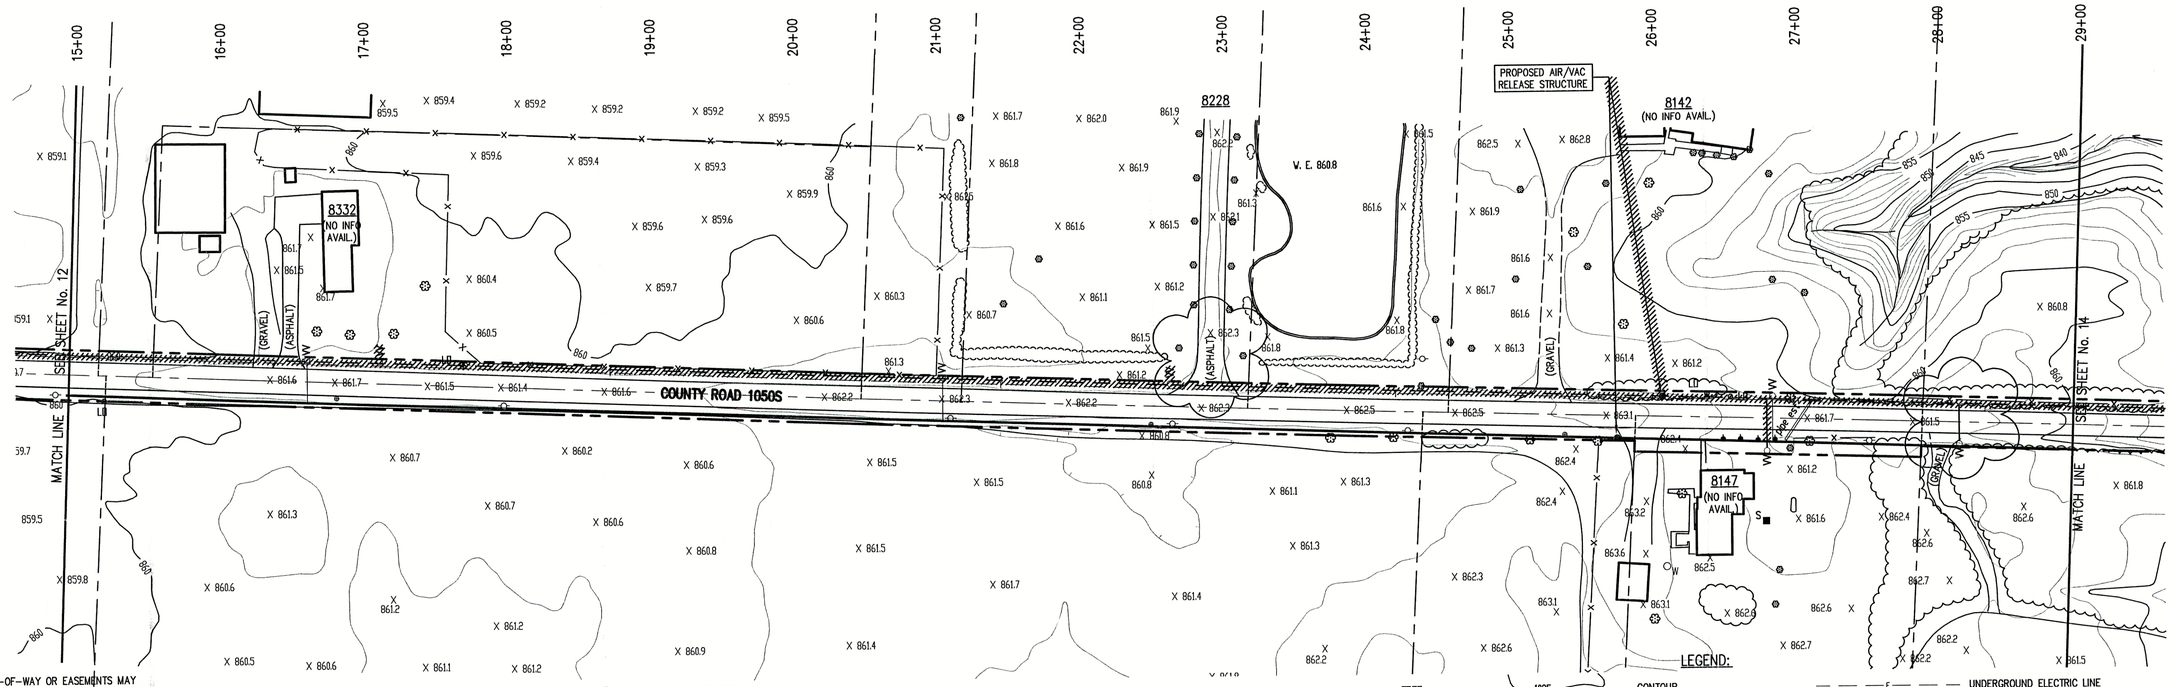

NOTE:
ADDITIONAL RIGHT-OF-WAY OR EASEMENTS MAY NEED TO BE ACQUIRED FOR INSTALLATION OF SEWER.

DON'T DIG BLIND
CALL BEFORE YOU DIG
WITHIN INDIANA
1-800-382-5544
OUTSIDE INDIANA
1-800-428-5200

PER INDIANA STATE LAW IS-69-1991, IT IS AGAINST THE LAW TO EXCAVATE WITHOUT NOTIFYING THE UNDERGROUND LOCATION SERVICE TWO (2) WORKING DAYS BEFORE COMMENCING WORK.

NOTE: CONTRACTOR TO VERIFY ALL UTILITY LOCATIONS PRIOR TO THE START OF CONSTRUCTION

GENERAL NOTES:

1. ALL UTILITY LOCATIONS ARE APPROXIMATE. THE CONTRACTOR SHALL HAVE ALL UTILITIES FIELD VERIFIED AND MARKED PRIOR TO CONTRUCTION.
2. CONTRACTOR SHALL MAINTAIN A MINIMUM 10'-0" HORIZONTAL AND 18" VERTICAL SEPARATION BETWEEN SEWER AND WATER MAINS.
3. ALL PROPOSED TOP OF CASTING ELEVATIONS ARE APPROXIMATE. THE CONTRACTOR SHALL ADJUST FINAL ELEVATIONS AS REQUIRED TO BE FLUSH WITH PAVEMENT.
4. ALL SEWER TRENCHES SHALL BE BACKFILLED WITH FULL DEPTH COMPACTED GRANULAR BACKFILL ("B" BORROW) UNDER OR WITHIN 5' OF EDGE OF PAVEMENT.
5. THE CONTRACTOR SHALL VISIT THE SITE PRIOR TO BID TO BECOME FAMILIAR WITH ALL SITE CONDITIONS.
6. THE CONTRACTOR SHALL PROVIDE THE REQUIRED MEANS FOR MAINTAINING SAFE TRAFFIC AT ALL TIMES.
7. CONTRACTOR SHALL RESTORE ALL DISTURBED LAWN AREAS, STREETS, WALKS, DRIVES, ETC. AS SHOWN ON DRAWINGS, IN THE SPECIFICATIONS, OR TO AT LEAST PRE-EXISTING CONDITIONS.
8. ALL UTILITY CROSSINGS SHALL BE PROTECTED AND SUPPORTED WITH GRANULAR FILL OR CONCRETE AS REQUIRED PER THE DETAIL SHEET.

LEGEND:

TREE	1085 CONTOUR		UNDERGROUND ELECTRIC LINE
POWER POLE	FENCE		UNDERGROUND TELEPHONE LINE
GUY WIRE	EXIST. SANITARY SEWER w/ MANHOLE		APPROX. RIGHT-OF-WAY
FIRE HYDRANT	NEW SANITARY SEWER w/ MANHOLE		APPROX. CORPORATE LIMITS
MB MAILBOX	SC NEW SANITARY SERVICE CONNECTION		APPROX. PROPERTY LINE
FP FLAGPOLE	4" W WATER LINE	W	EXISTING WATER WELL
X 1085.2 SPOT SHOT	2" G GAS LINE	S	EXISTING SEPTIC TANK
		VV	NEW GRINDER PUMP VALVE VAULT

NORTH

SCALE:
HORIZONTAL 1" = 50'
VERTICAL 1" = 5'

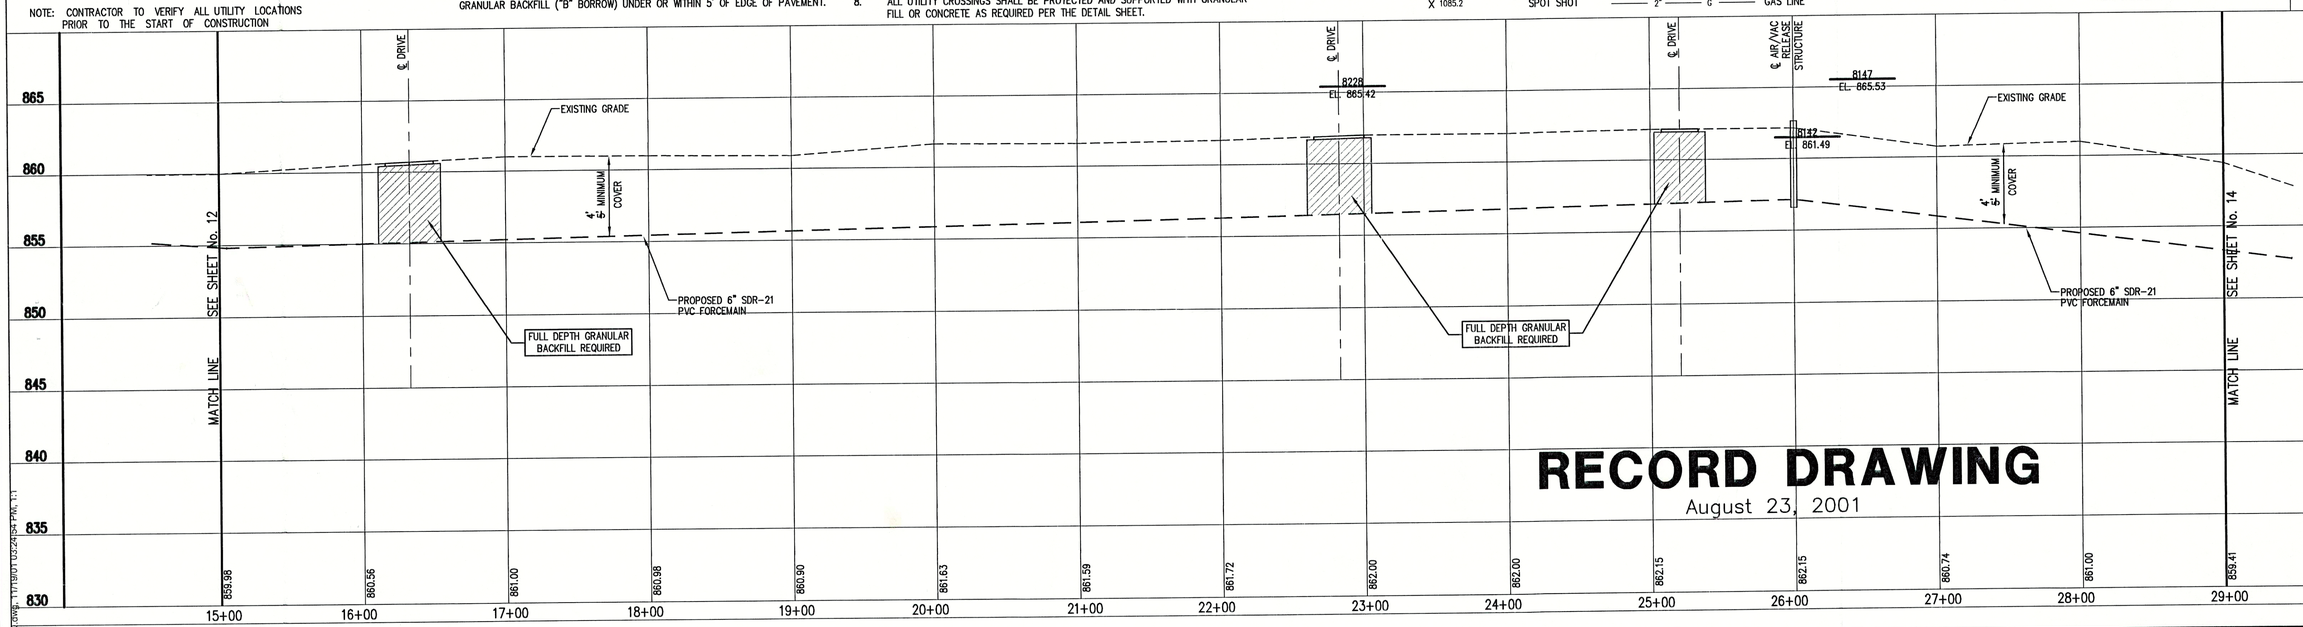

RECORD DRAWING

August 23, 2001

FILE NAME: RCP02001-RD	PLOT SCALE: 1=1	PLOT DATE: 11/19	
NO.	DATE	DESCRIPTION	BY

TRIAD ASSOCIATES INC.
INDIANAPOLIS, INDIANA

APPROVED BY: THOMAS M. SCHUBERT REGISTERED No. 15614 STATE OF INDIANA PROFESSIONAL ENGINEER
Thomas M. Schubert, P.E.

SUNVIEW, ALFONT, REFORMATORY ROAD
FALL CREEK REGIONAL WASTE DISTRICT

PLAN AND PROFILE

DRAWN BY: DAP	DATE 04/12/98	PROJECT No. 98008A	SHEET No. 13 OF 33
	SCALE AS NOTED		
DESIGNED BY: D.A. Pauling			
CHECKED BY: James W. Frazell, P.E.			

C:\DWG\SUNVIEW\RegOrdr\rcp02001-RD.dwg, 1:1/1/8\07:03:29\24 PM, 1:1