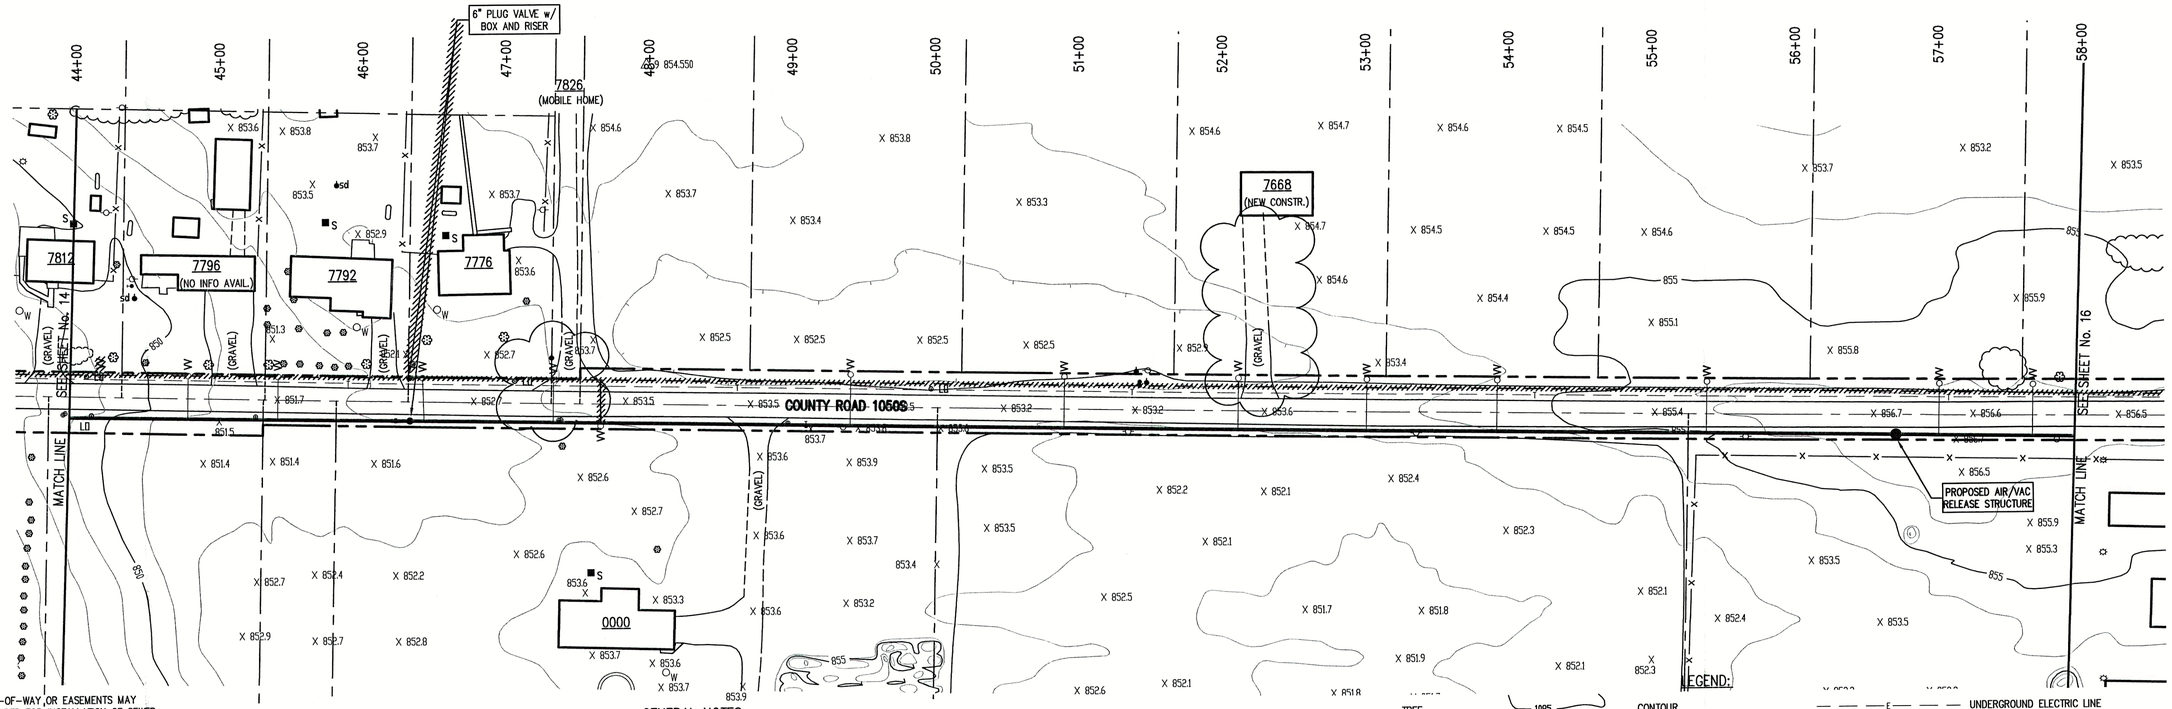

NOTE:
ADDITIONAL RIGHT-OF-WAY, OR EASEMENTS MAY NEED TO BE ACQUIRED FOR INSTALLATION OF SEWER.

DON'T DIG BLIND
CALL BEFORE YOU DIG
within indiana
1-800-382-5544
outside indiana
1-800-428-5200

"MOLLY MOLEY"

PER INDIANA STATE LAW IS-69-1991, IT IS AGAINST THE LAW TO EXCAVATE WITHOUT NOTIFYING THE UNDERGROUND LOCATION SERVICE TWO (2) WORKING DAYS BEFORE COMMENCING WORK.

NOTE: CONTRACTOR TO VERIFY ALL UTILITY LOCATIONS PRIOR TO THE START OF CONSTRUCTION

GENERAL NOTES:

1. ALL UTILITY LOCATIONS ARE APPROXIMATE. THE CONTRACTOR SHALL HAVE ALL UTILITIES FIELD VERIFIED AND MARKED PRIOR TO CONTRUCTION.
2. CONTRACTOR SHALL MAINTAIN A MINIMUM 10'-0" HORIZONTAL AND 18" VERTICAL SEPARATION BETWEEN SEWER AND WATER MAINS.
3. ALL PROPOSED TOP OF CASTING ELEVATIONS ARE APPROXIMATE. THE CONTRACTOR SHALL ADJUST FINAL ELEVATIONS AS REQUIRED TO BE FLUSH WITH PAVEMENT.
4. ALL SEWER TRENCHES SHALL BE BACKFILLED WITH FULL DEPTH COMPACTED GRANULAR BACKFILL ("B" BORROW) UNDER OR WITHIN 5' OF EDGE OF PAVEMENT.
5. THE CONTRACTOR SHALL VISIT THE SITE PRIOR TO BID TO BECOME FAMILIAR WITH ALL SITE CONDITIONS.
6. THE CONTRACTOR SHALL PROVIDE THE REQUIRED MEANS FOR MAINTAINING SAFE TRAFFIC AT ALL TIMES.
7. CONTRACTOR SHALL RESTORE ALL DISTURBED LAWN AREAS, STREETS, WALKS, DRIVES, ETC. AS SHOWN ON DRAWINGS, IN THE SPECIFICATIONS, OR TO AT LEAST PRE-EXISTING CONDITIONS.
8. ALL UTILITY CROSSINGS SHALL BE PROTECTED AND SUPPORTED WITH GRANULAR FILL OR CONCRETE AS REQUIRED PER THE DETAIL SHEET.

LEGEND:

	TREE	1085	CONTOUR
	POWER POLE	X X	FENCE
	GUY WIRE	MH	EXIST. SANITARY SEWER w/ MANHOLE
	FIRE HYDRANT		NEW SANITARY SEWER w/ MANHOLE
MB	MAILBOX	SC	NEW SANITARY SERVICE CONNECTION
FP	FLAGPOLE	4" W	WATER LINE
X 1085.2	SPOT SHOT	2" G	GAS LINE
E	UNDERGROUND ELECTRIC LINE		
T	UNDERGROUND TELEPHONE LINE		
	APPROX. RIGHT-OF-WAY		
	APPROX. CORPORATE LIMITS		
	APPROX. PROPERTY LINE		
W	EXISTING WATER WELL		
S	EXISTING SEPTIC TANK		
VV	NEW GRINDER PUMP VALVE VAULT		

NORTH

SCALE:
HORIZONTAL 1" = 50'
VERTICAL 1" = 5'

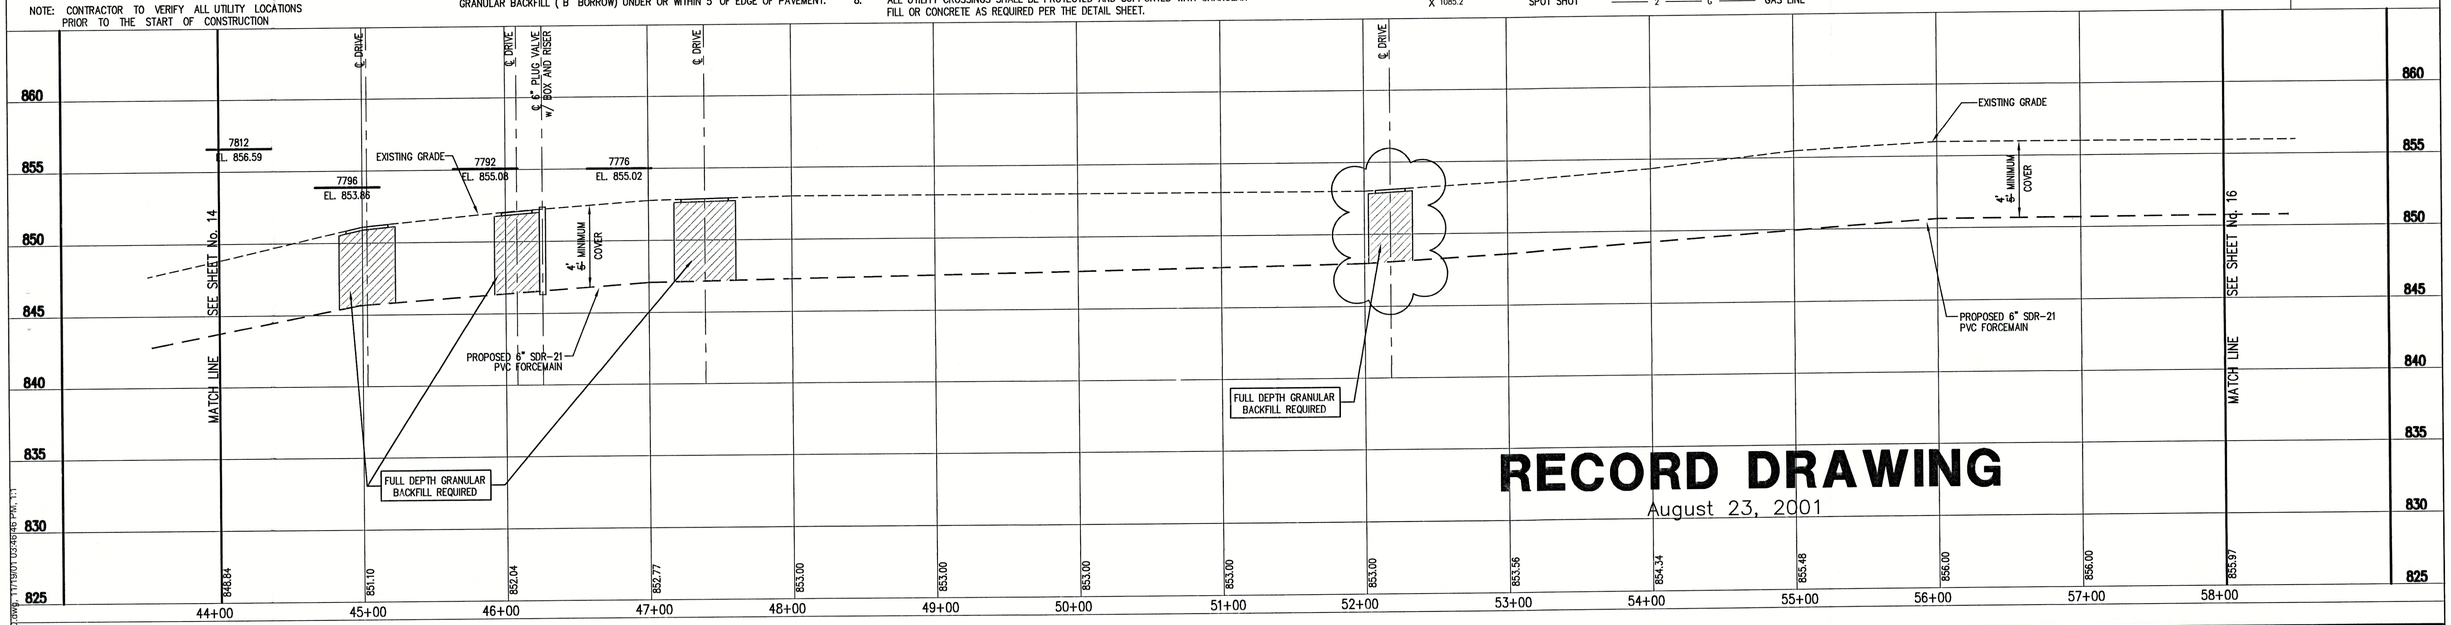

RECORD DRAWING

August 23, 2001

NO.	DATE	DESCRIPTION	BY

FILE NAME: RCP04001-RD | PLOT SCALE: 1=1 | PLOT DATE: 11/06

TRIAD ASSOCIATES INC.
INDIANAPOLIS, INDIANA

APPROVED BY: THOMAS M. SCHUBERT REGISTERED No. 15614 STATE OF INDIANA PROFESSIONAL ENGINEER
Thomas M. Schubert, P.E.

SUNVIEW, ALFONT, REFORMATORY ROAD
FALL CREEK REGIONAL WASTE DISTRICT

PLAN AND PROFILE

DRAWN BY:	DATE 04/12/98	PROJECT No.	SHEET No.
DAP	SCALE AS NOTED	98008A	15 OF 33
DESIGNED BY:	D.A. Pauling		
CHECKED BY:	James W. Frazell, P.E.		

C:\DWG\SUNVIEW\RWG\RCP04001-RD.dwg, 11/13/01 10:49:45 PM, 1:1