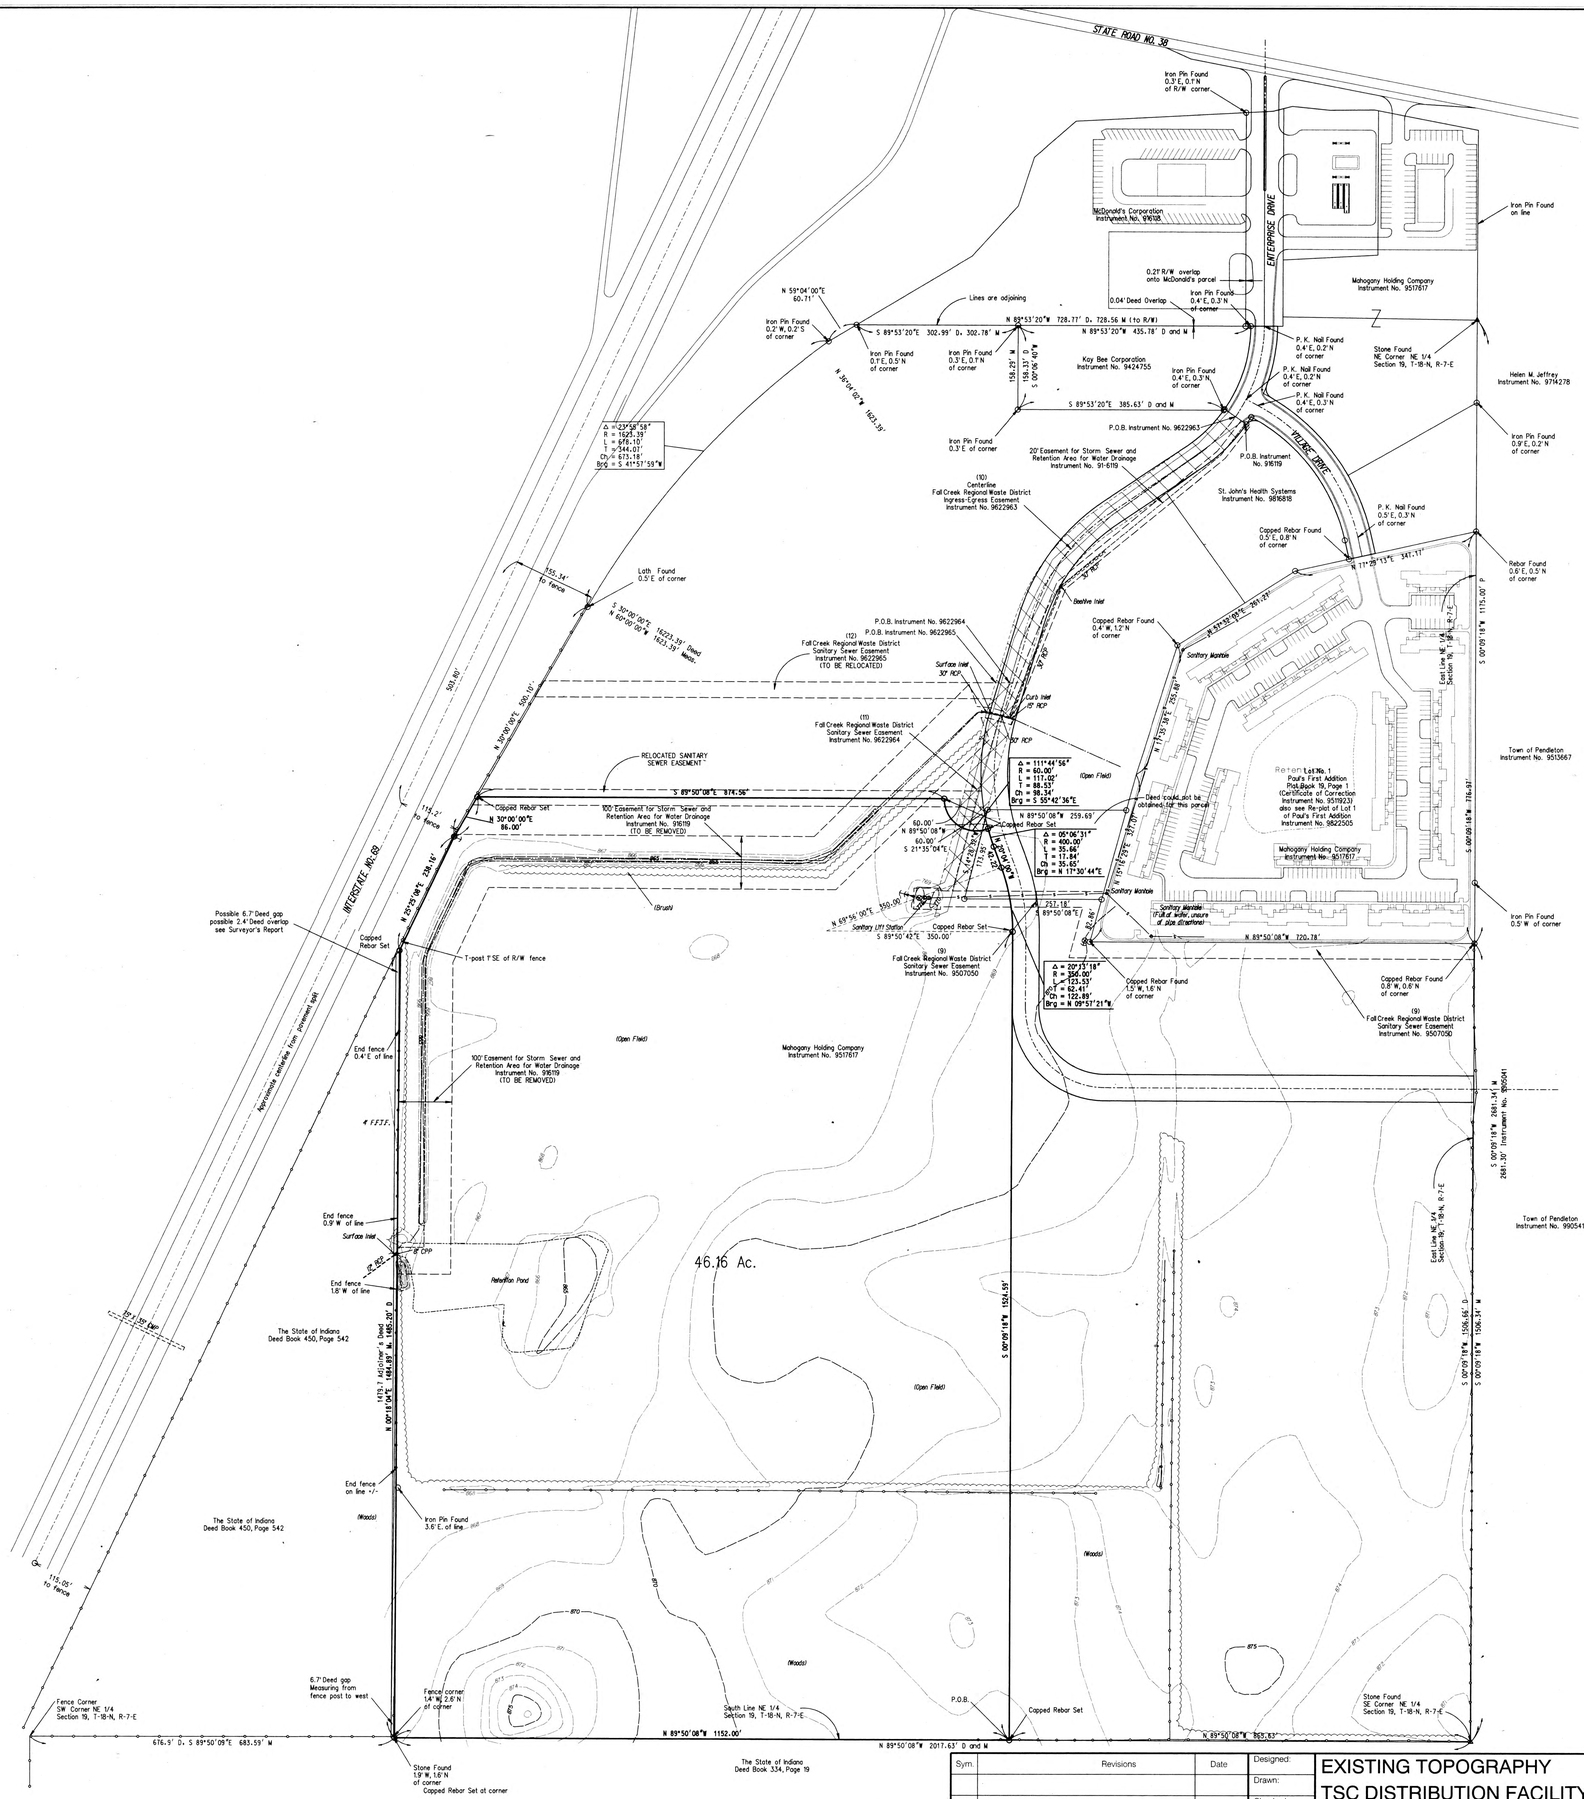

Sym.	Revisions	Date

Designed:
Drawn:
Checked:
Scale: 1"=100'
Date: 7-12-99

EXISTING TOPOGRAPHY
TSC DISTRIBUTION FACILITY
FALL CREEK T'SHIP, MADISON COUNTY
PENDLETON, INDIANA

HENRY W. PEARSON — REGISTERED — No. 60010517 — STATE OF INDIANA — PROFESSIONAL ENGINEER

BANNING ENGINEERING, P.C.
CIVIL ENGINEERING ~ LAND SURVEYING
698 TOWER ROAD SUITE #100, PLAINFIELD, INDIANA 46168
BUS. (317) -839 - 2581, FAX (317) - 838 - 9171, E-MAIL banning@banning-eng.com

Project No: 99-207

Sheet No: 2 of 10