


PLAN

US 36 FORCEMAIN REPLACEMENT
TOWN OF PENDLETON, INDIANA

DATE:		MARCH 2019	
SCALE:		$\eta = 30'$	
SHEET NO.		C-16	
NO.	REVISIONS DESCRIPTION	BY	GWL
			DOWN
			JRD
			REVIEWED
			GWL
			APPROVED
			GWI




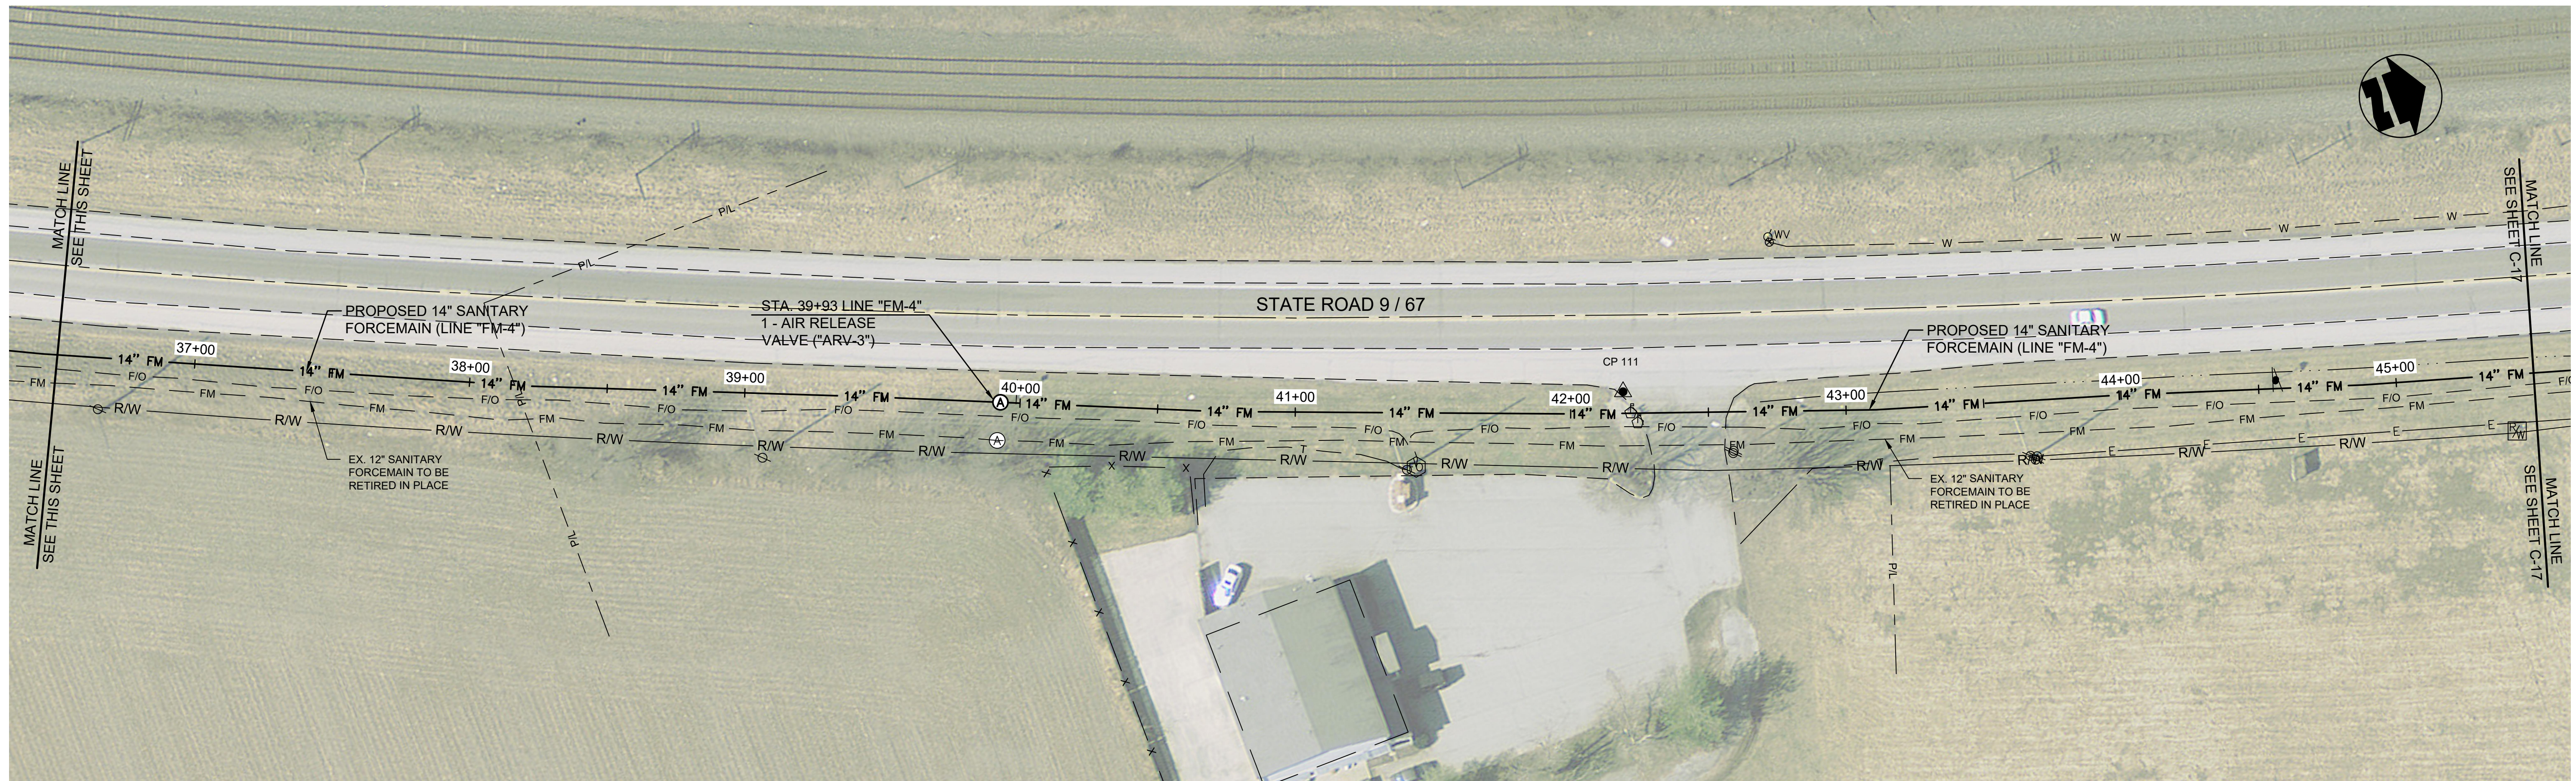

PROFILE - STA. 36+50 TO STA. 45+50 LINE "FM-4"

THIS RECORD DOCUMENT HAS BEEN PREPARED BASED ON INFORMATION PROVIDED BY THE CONSTRUCTION CONTRACTOR. GRW ENGINEERS, INC. HAS ATTEMPTED TO VERIFY THE ACCURACY AND/OR COMPLETENESS OF THIS INFORMATION BUT SHALL NOT BE RESPONSIBLE FOR ANY ERRORS OR OMISSIONS WHICH MAY BE INCORPORATED HEREIN AS A RESULT.

ENGINEER/ARCHITECT: GEORGE LEWIS

CONSTRUCTION COMPANY: S.C.CASE EXCAVATING

DATE: 12/2019