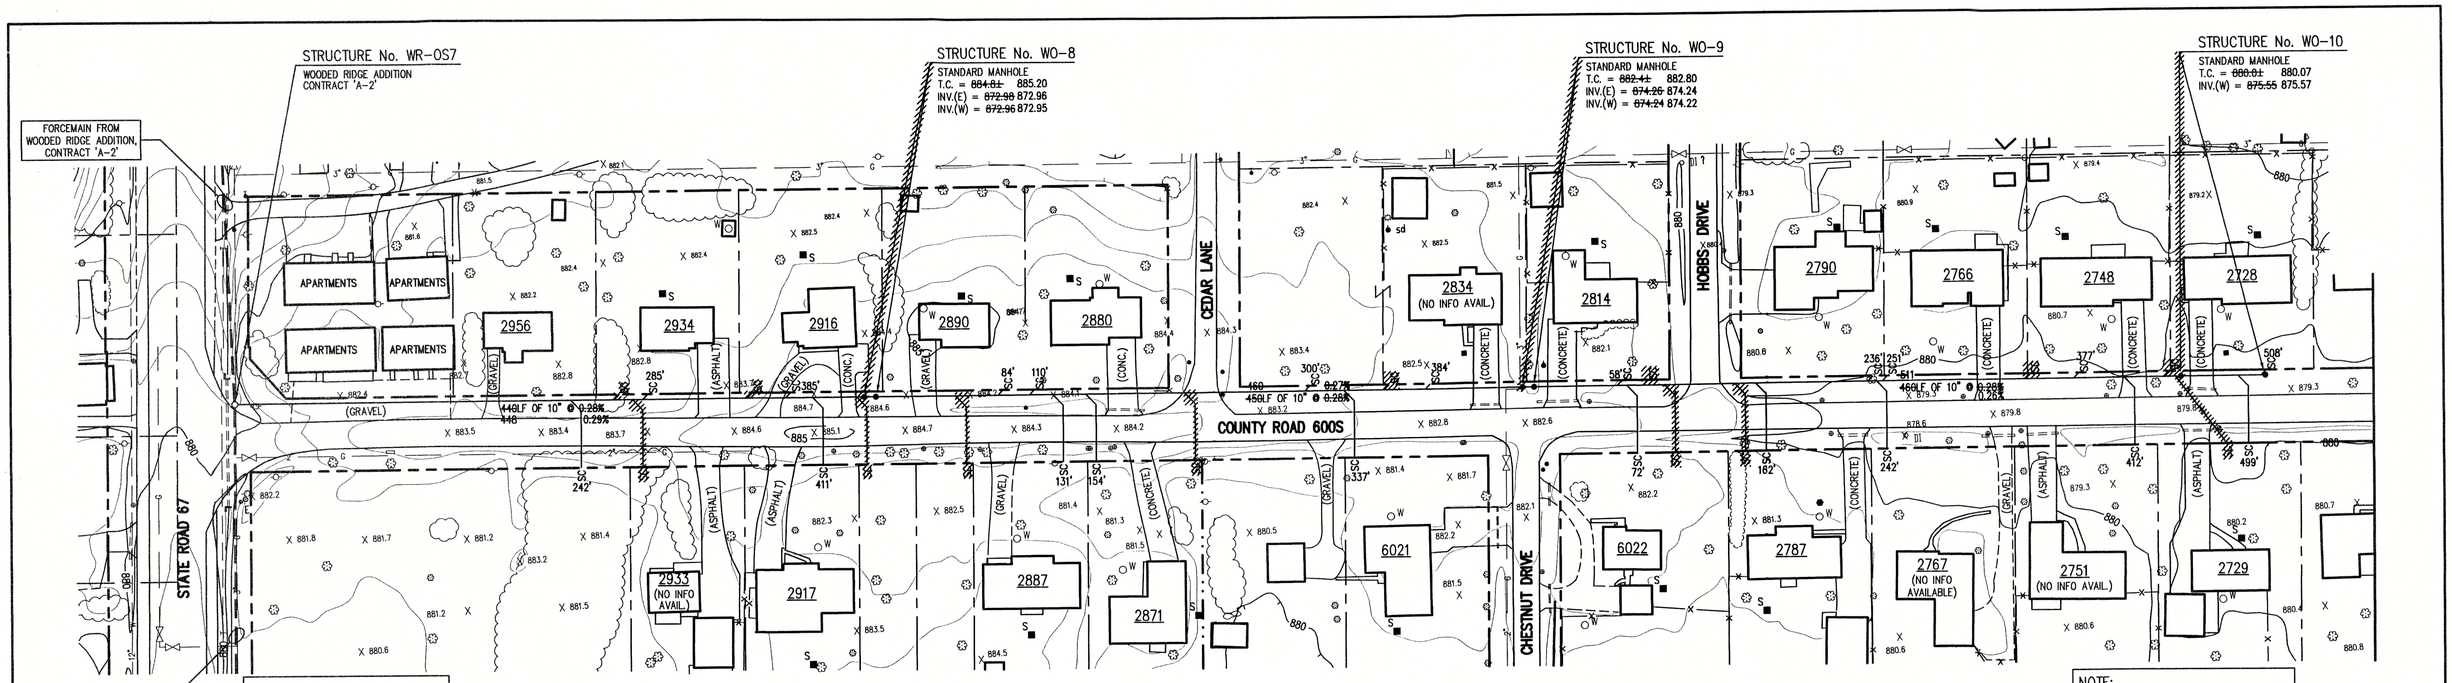

NOTE:
CONTRACTORS FOR BOTH CONTRACT 'A-1' AND CONTRACT 'A-2' SHALL COORDINATE THE SANITARY SEWER CONNECTION AT THE INTERSECTION OF STATE ROAD 67 AND COUNTY ROAD 600S.

NOTE:
CONTRACTORS FOR BOTH CONTRACT 'A-1' AND CONTRACT 'A-2' SHALL COORDINATE ALL SERVICE CONNECTIONS ALONG COUNTY ROAD 600S. SEWER LINES IN THIS AREA SERVE RESIDENCE IN BOTH CONTRACTS.

NOTE:
ADDITIONAL RIGHT-OF-WAY OR EASEMENTS MAY NEED TO BE ACQUIRED FOR INSTALLATION OF SEWER.

DON'T DIG BLIND
CALL BEFORE YOU DIG
WITHIN INDIANA
1-800-382-5544
OUTSIDE INDIANA
1-800-428-5200

PER INDIANA STATE LAW IS-69-1991, IT IS AGAINST THE LAW TO EXCAVATE WITHOUT NOTIFYING THE UNDERGROUND LOCATION SERVICE TWO (2) WORKING DAYS BEFORE COMMENCING WORK.

NOTE: CONTRACTOR TO VERIFY ALL UTILITY LOCATIONS PRIOR TO THE START OF CONSTRUCTION

GENERAL NOTES:

1. ALL UTILITY LOCATIONS ARE APPROXIMATE. THE CONTRACTOR SHALL HAVE ALL UTILITIES FIELD VERIFIED AND MARKED PRIOR TO CONTRUCTION.
2. CONTRACTOR SHALL MAINTAIN A MINIMUM 10'-0" HORIZONTAL AND 18" VERTICAL SEPARATION BETWEEN SEWER AND WATER MAINS.
3. ALL PROPOSED TOP OF CASTING ELEVATIONS ARE APPROXIMATE. THE CONTRACTOR SHALL ADJUST FINAL ELEVATIONS AS REQUIRED TO BE FLUSH WITH PAVEMENT.
4. ALL SEWER TRENCHES SHALL BE BACKFILLED WITH FULL DEPTH COMPACTED GRANULAR BACKFILL ("B" BORROW) UNDER OR WITHIN 5' OF EDGE OF PAVEMENT.
5. THE CONTRACTOR SHALL VISIT THE SITE PRIOR TO BID TO BECOME FAMILIAR WITH ALL SITE CONDITIONS.
6. THE CONTRACTOR SHALL PROVIDE THE REQUIRED MEANS FOR MAINTAINING SAFE TRAFFIC AT ALL TIMES.
7. CONTRACTOR SHALL RESTORE ALL DISTURBED LAWN AREAS, STREETS, WALKS, DRIVES, ETC. AS SHOWN ON DRAWINGS, IN THE SPECIFICATIONS, OR TO AT LEAST PRE-EXISTING CONDITIONS.
8. ALL UTILITY CROSSINGS SHALL BE PROTECTED AND SUPPORTED WITH GRANULAR FILL OR CONCRETE AS REQUIRED PER THE DETAIL SHEET.

LEGEND:

TREE	1085 CONTOUR	E UNDERGROUND ELECTRIC LINE	
POWER POLE	X FENCE	T UNDERGROUND TELEPHONE LINE	
GUY WIRE	MH EXIST. SANITARY SEWER w/ MANHOLE	APPROX. RIGHT-OF-WAY	
FIRE HYDRANT	NEW SANITARY SEWER w/ MANHOLE	APPROX. CORPORATE LIMITS	
MB MAILBOX	SC NEW SANITARY SERVICE CONNECTION	W EXISTING WATER WELL	
FP FLAGPOLE	4" W WATER LINE	S EXISTING SEPTIC TANK	
X 1085.2 SPOT SHOT	2" G GAS LINE		

NORTH

SCALE:
HORIZONTAL 1" = 50'
VERTICAL 1" = 5'

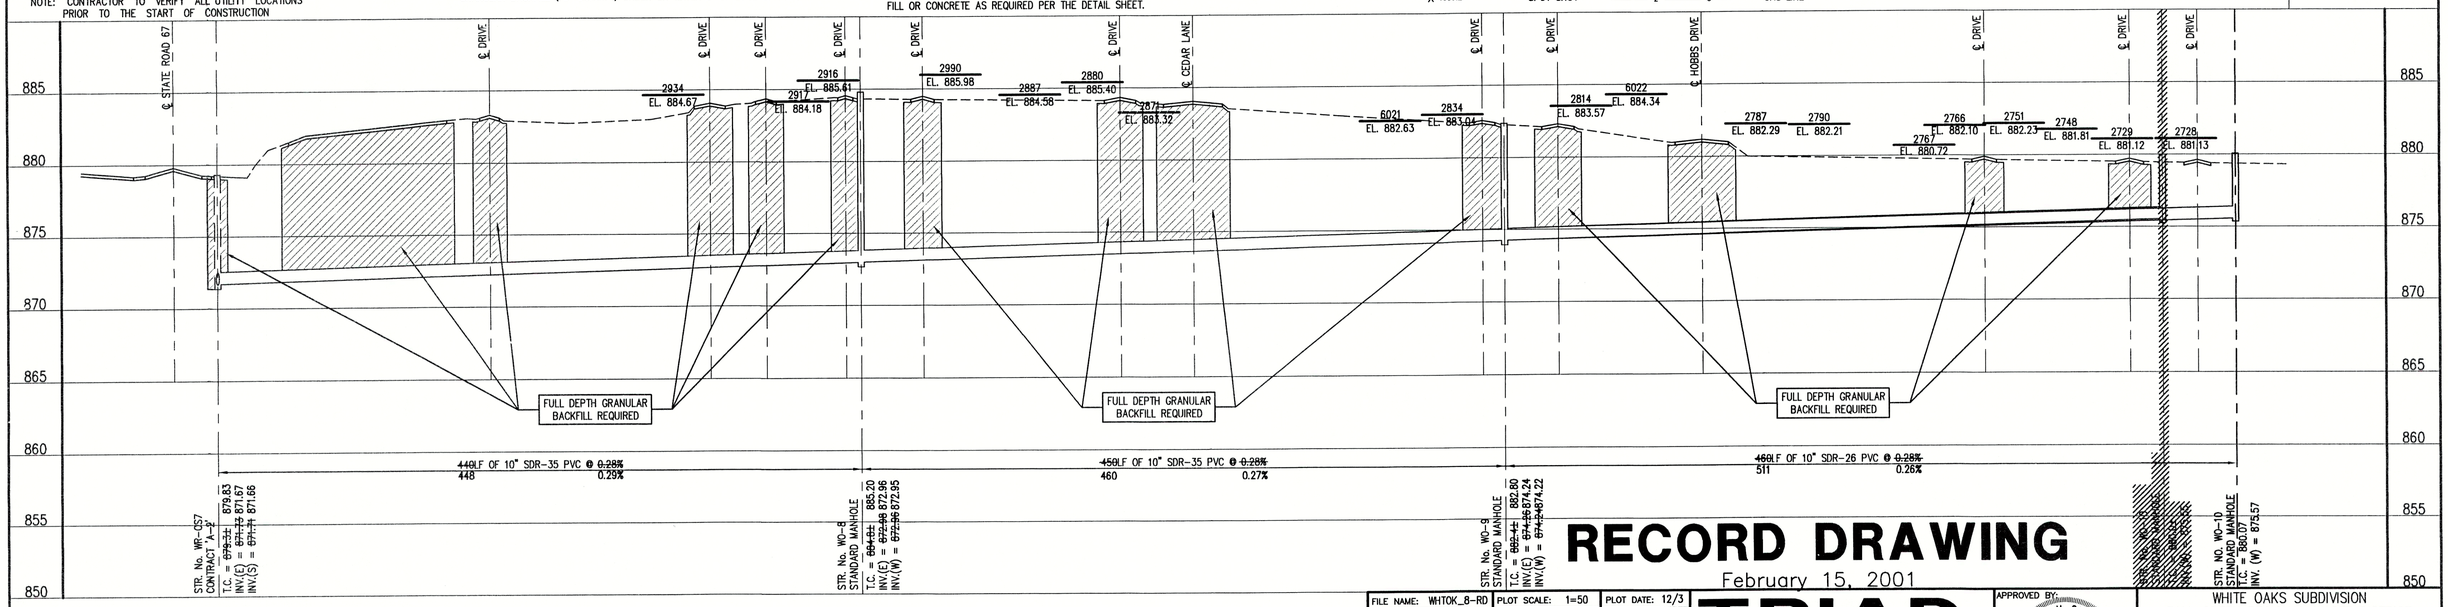

RECORD DRAWING

February 15, 2001

NOTE:
THE CONTRACTOR SHALL INCLUDE IN THE COSTS FOR SANITARY PIPE, ALL WATER SERVICE RECONNECTIONS, STORM SEWER RECONNECTION, WATER MAIN RELOCATIONS, CONCRETE RECONSTRUCTION, AND SIDEWALK RECONSTRUCTION AS REQUIRED TO INSTALL NEW WORK AS SHOWN ON THE DRAWINGS.

FILE NAME: WHTOK_8-RD	PLOT SCALE: 1=50	PLOT DATE: 12/3	
NO.	DATE	DESCRIPTION	BY

TRIAD ASSOCIATES INC.
INDIANAPOLIS, INDIANA

APPROVED BY: THOMAS W. SCHUBERT REGISTERED No. 15614 STATE OF INDIANA PROFESSIONAL ENGINEER
Thomas M. Schubert, P.E.

WHITE OAKS SUBDIVISION
FALL CREEK REGIONAL WASTE DISTRICT

PLAN AND PROFILE

DRAWN BY: DAP	DATE 04/12/98	PROJECT No. 98008A	SHEET No. 3
	SCALE AS NOTED		OF 11
DESIGNED BY: D.A. Pauling			
CHECKED BY: James W. Frazell, P.E.			