

Main line Oak ST

11.27.17

Tim
McCurdy



112 Oak ST

11.27.17

Tim
McLurdy



114 & 116 Oak St

11.27.17


Tim
McLurdy



118 Oak ST

11.27.17

Tim
McCurdy

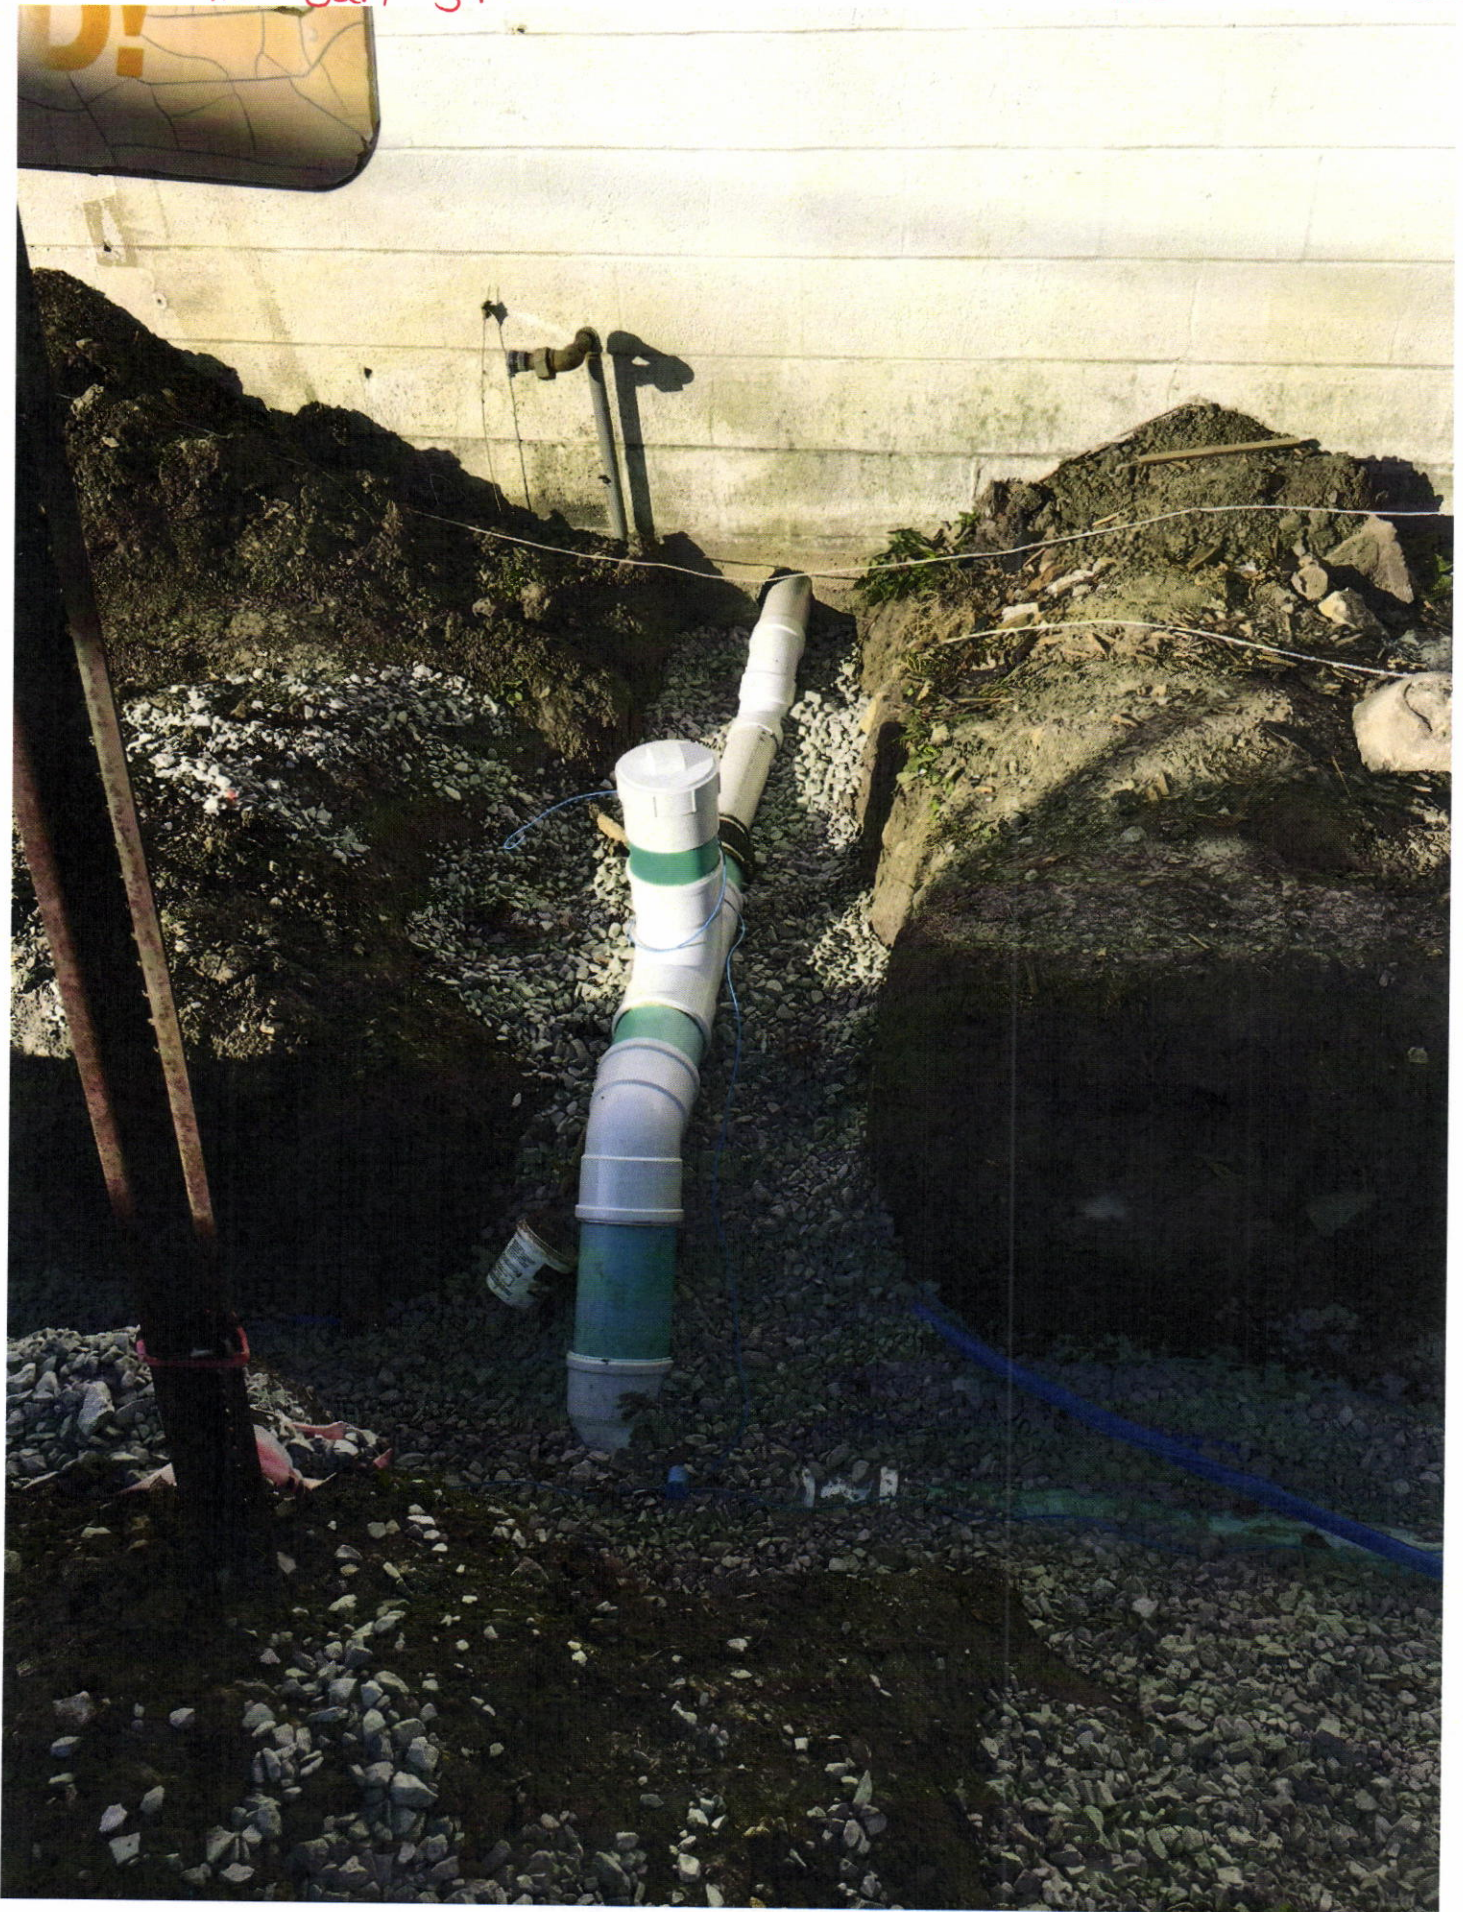

120, 122 Oak ST Tap (turned to east)

will be

11.27.17

Tim
McLurdy

