

Fall Creek Regional Waste District
9378 S 650 W, P.O. Box 59, Pendleton, IN 46064
765-778-7544

#6819

Agreement for Sanitary Sewer Service

This Agreement made and entered into this 14 day of June, 2019 between Fall Creek Regional Waste District ("District") and Green Letter Apartments ("Applicant") regarding the provision of sanitary sewer service, and the assignment of capacity in and connection to, the District's facilities for the premises located at _____.

Street Address: 1248 W US 36 - Double (1244 & 1248)

Now therefore, the parties, in consideration of the mutual promises set out in this Agreement, the receipt and sufficiency of which is hereby acknowledged, agree as follows:

1. The Applicant agrees that all workmanship and materials shall conform to all District ordinances and the District's construction standards. District must accept and approve all work and materials before backfilling and final connection is made to the sewer mains. Any violation of this provision will cause all lines and appurtenances in violation to be removed and replaced at the Applicant's expense.
2. The District shall have the right to enter upon the Applicant's premises at all reasonable times to inspect, repair, or replace any equipment used in connection with the District's service or which has an impact on said service.
3. The Applicant shall be responsible for all monthly user rates, capacity charges, and tap fees. The failure to pay any rate charge or fee may result in a lien against the property and/or the termination of service to the property, the cost of which will be borne by Applicant, including, but not limited to, all attorney's fees and collection costs.
4. The District shall not be responsible for any damages as a result of any failure to supply service unless said damages are due to default, neglect or culpability on the part of the District.
5. If there is an available sanitary sewer within three hundred (300) feet of the property line, the property owner shall be required to connect to the District's sanitary sewer system.
6. The Applicant and District agree that the provision of sanitary sewer service touches and concerns the property and the terms of this Agreement bind the District and Applicant and their heirs, executors, administrators, personal representatives, successors, agents, attorneys, assigns, designees, and transferees.

The parties hereto have read and fully understand the above provisions and agree to comply with said provisions.

FALL CREEK REGIONAL WASTE DISTRICT

Signature

APPLICANT


Signature

STATE OF INDIANA)

) SS:

COUNTY OF MADISON)

SUBSCRIBED and sworn to before me this 14 day of June, 2019

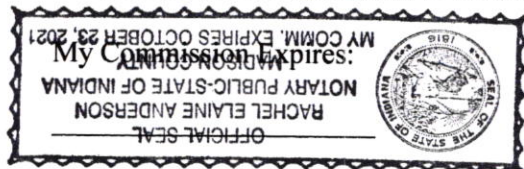

Signature

Printed

Notary Public

Resident of Madison County

Inspector Sean M Date Inspected 7.23.19 Approved ☒ Rejected ☐

Reason for Rejection _____

Date Reinspected _____ Approved ☐ Rejected ☐

Notes:

Size Pipe 6" Type Pipe 35

Basement Yes ☐ No ☒

Sump Pump Yes ☐ No ☒

Downspout to Ground Yes ☐ No ☐


Septic Tank Pumped & Filled Yes ☐ No ☐

Contractor F&E Construction

Special Conditions _____

Existing Home ☒

New Construction ☐

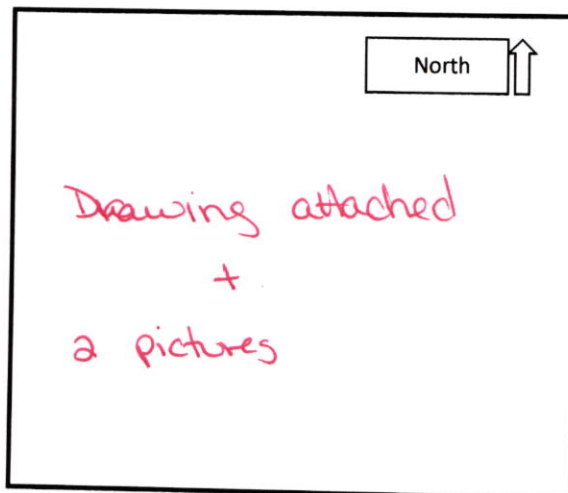

GREEK LETTER APARTMENTS LLC
2417 WEST SR 38
PENDLETON, IN 46064

2100
71-167/749
104

6/14/19 Date

Pay to the
Order of FCRWD

\$ 9737.³⁸

Nine thousand seven hundred thirty seven ³⁸/₁₀₀ Dollars



For B-F grinder/pump etc

Stephen W. [Signature]


Fee Breakdown:

Capacity: \$2800.00 x 2
(1244 : 1248)

Tap: \$570.00
(sharing tap)


Rec. #010946

Grinder: \$3567.38
(sharing grinder)

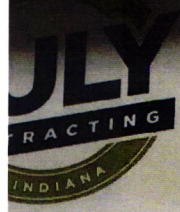


PROJECT: _____ DATE: _____

1244 w US 36 & 1248 w US 36

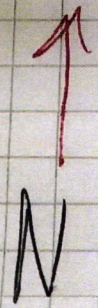

1248

us 36

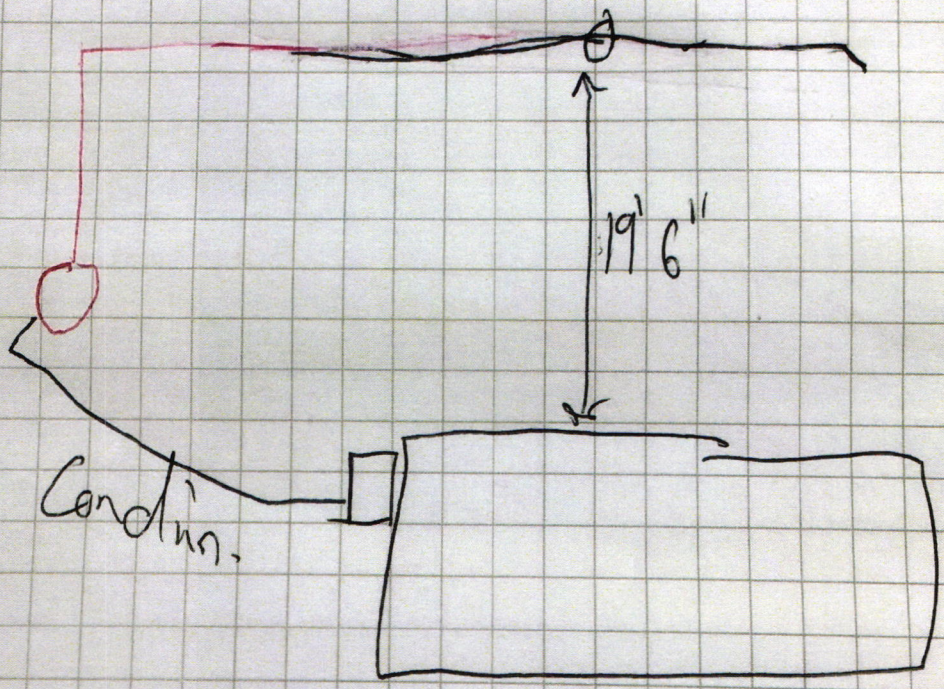

F & E construction

property is a duplex that shares one grinder unit



1844 W US 36 & 1848 W US 36

Sean Mitchell

7.23.19



1844 W US 36 & 1848 W US 36

Sean Mitchell

7.33.19