


N →

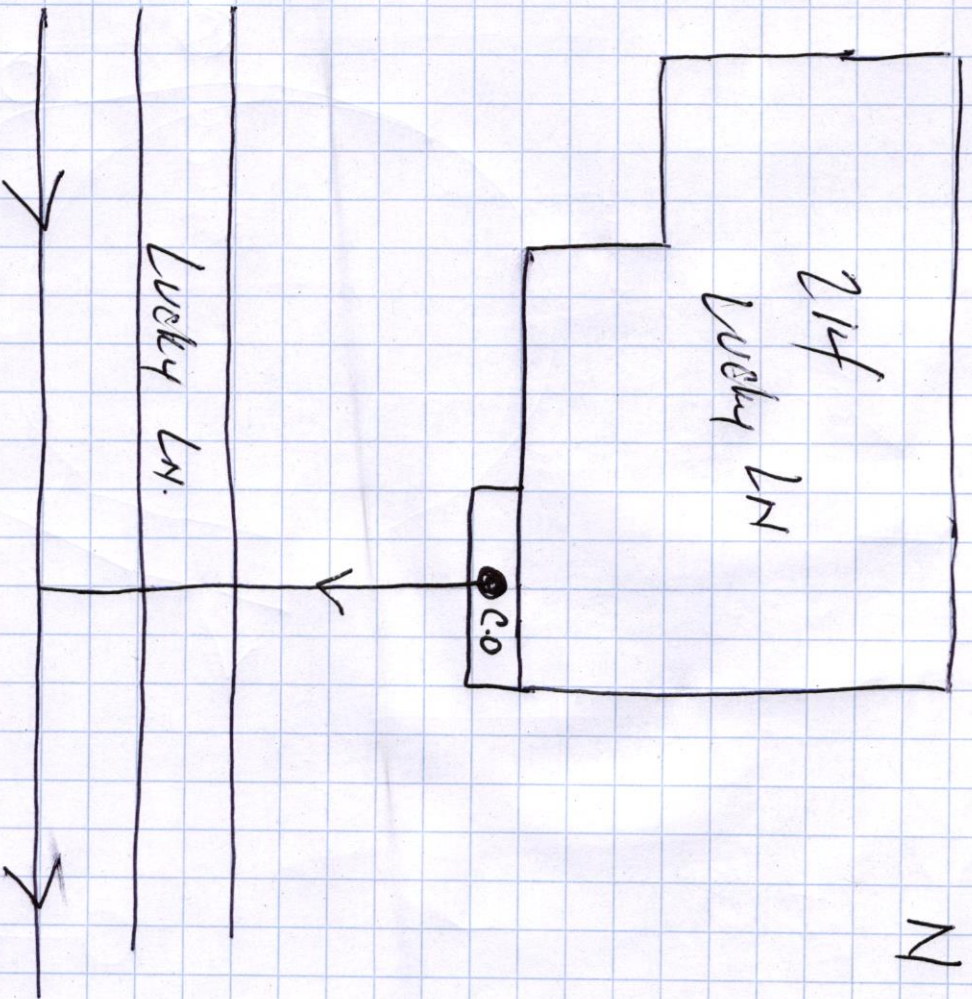

STAN 2034