


2151 W US 36

Connected in late 80's

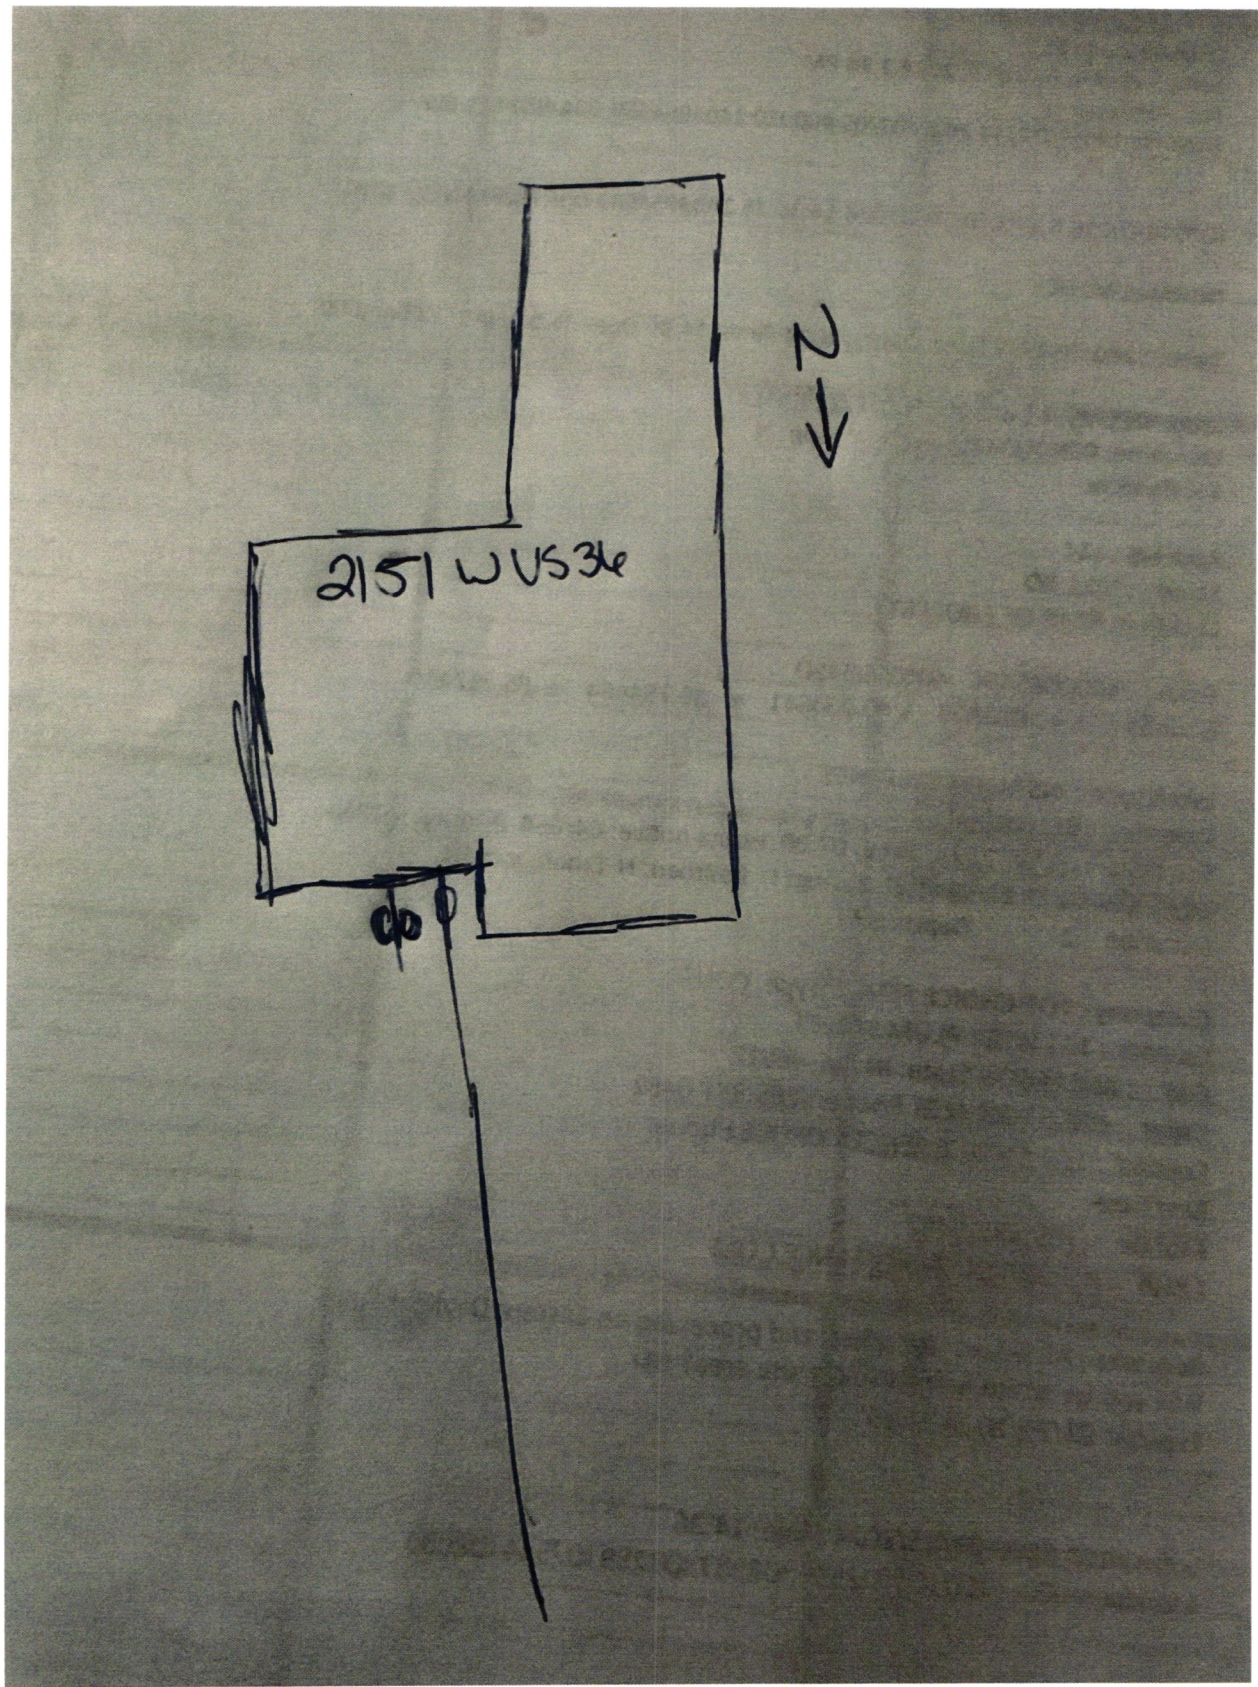



2151 W US 36

Connected in late 80's

