


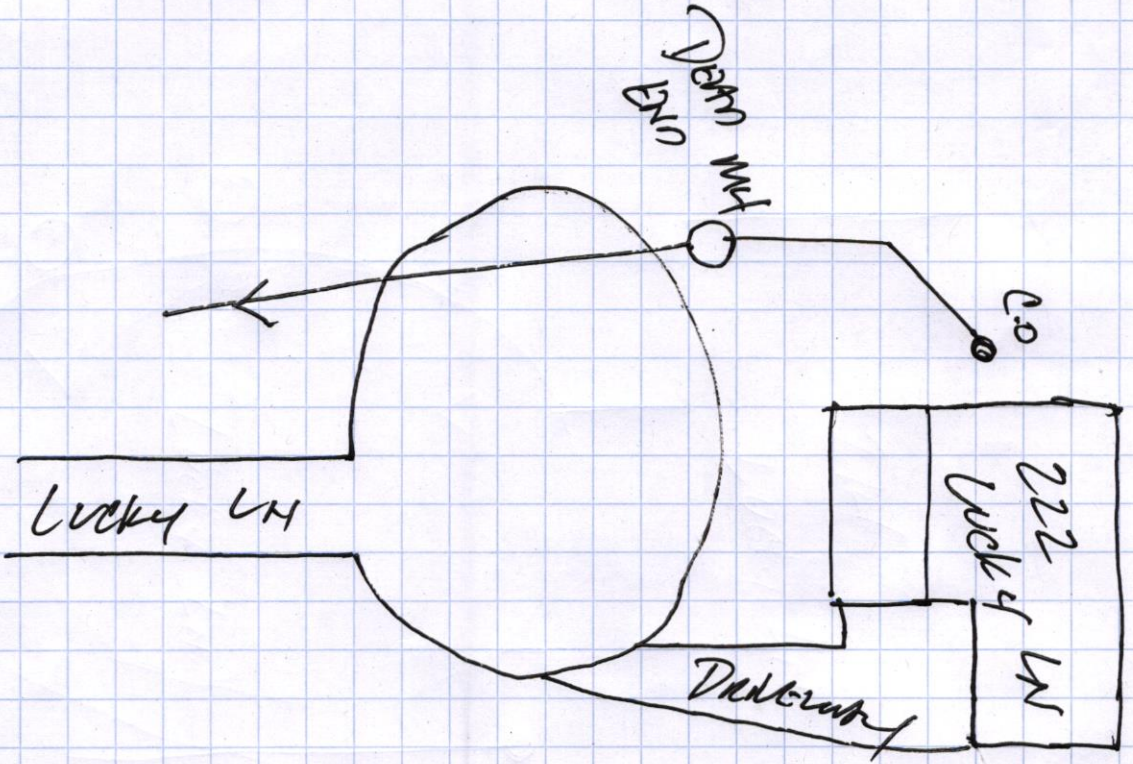

(No inspection)

San 2024