


318 S Adams

SRF
Phase II

4.11.18

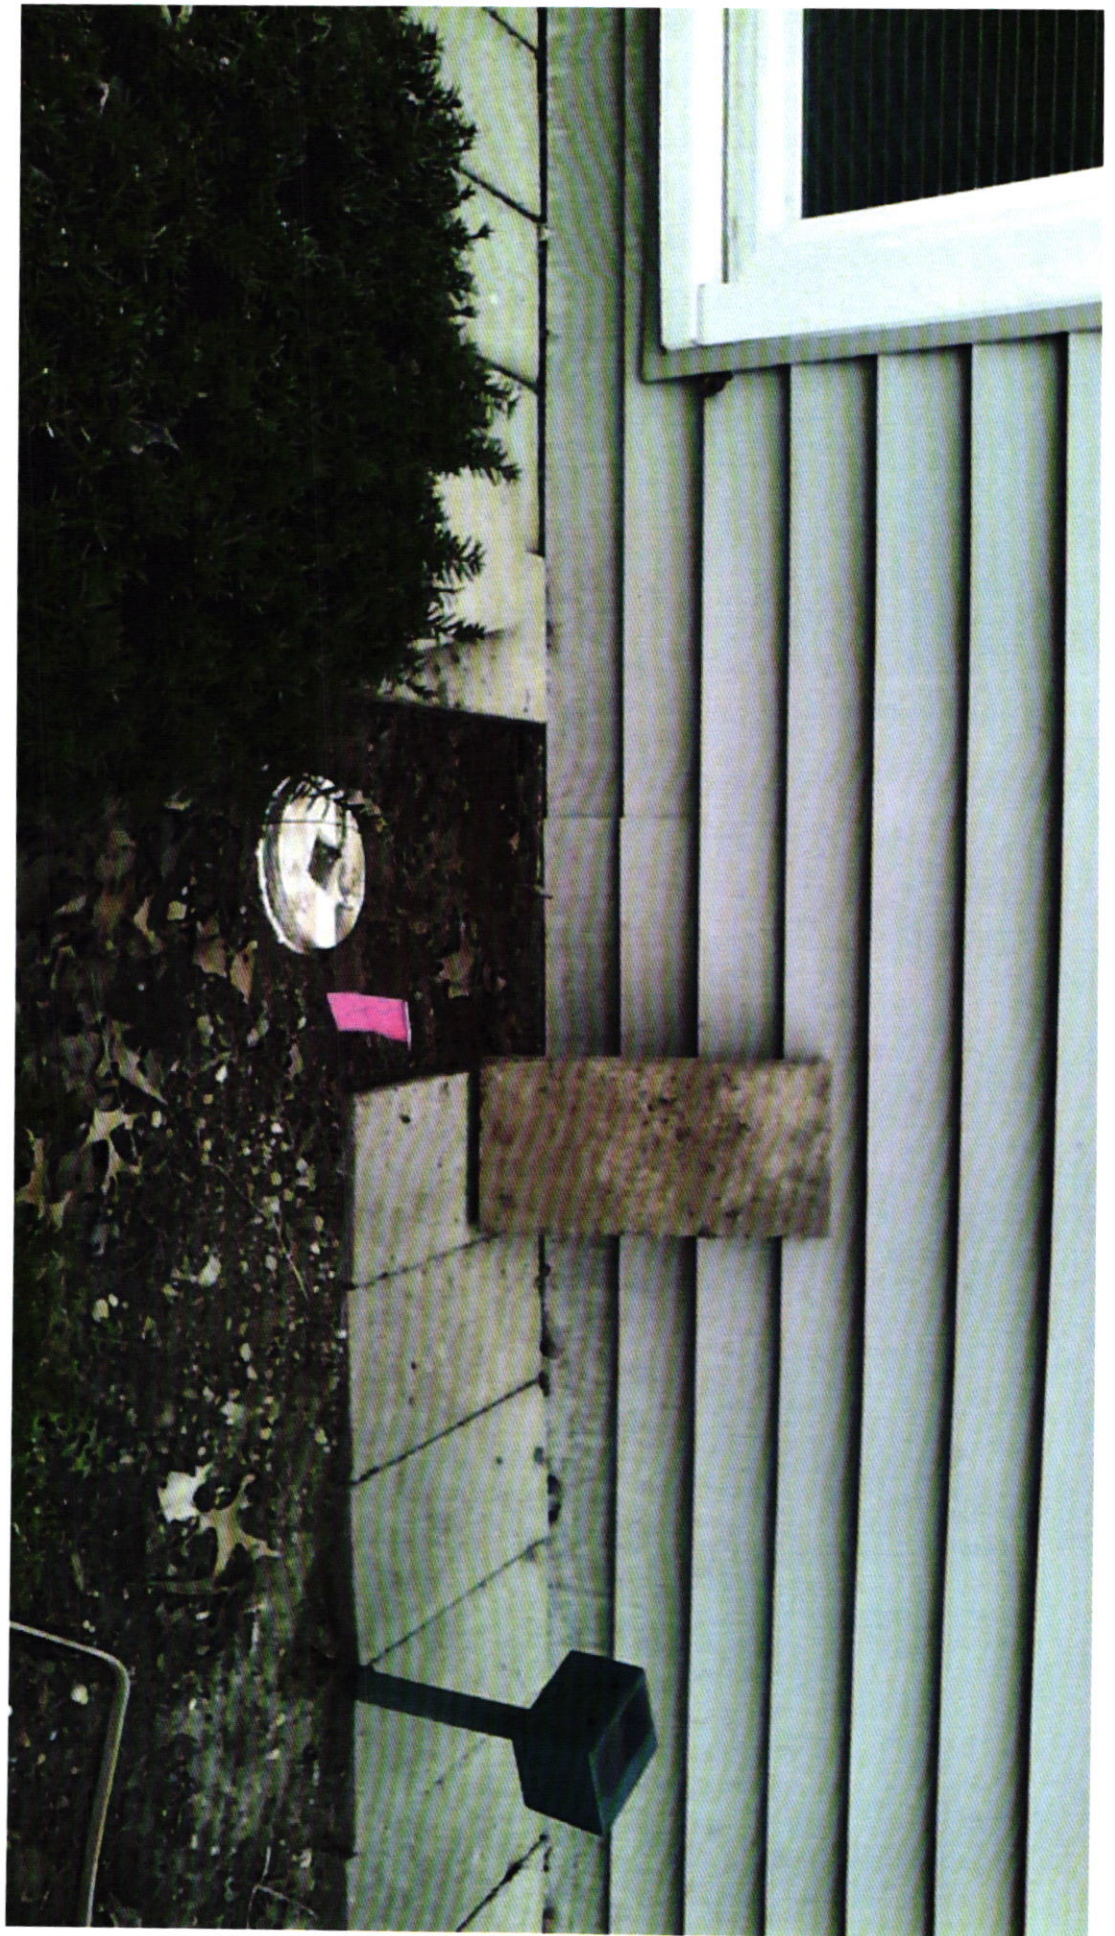

Becca Hunter

From: Tim McCurdy
Sent: Friday, July 10, 2020 2:43 PM
To: Becca Hunter
Subject: 20200710091322.pdf
Attachments: 20200710091322.pdf

Can you attach this to Wendell Buckley on Adams street from our SRF phase 2 project ?

8-27-18


EAST

ADD DIRT
IN FRONT OF
BARN STEP

BARN

NORTH

VALLEY

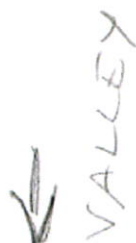

2-4"



2 to 4"

DEEP

6 FT



2 to 4" DEEP

6-8'



6 FT

2 to 4" DEEP

LEVEL

6-8'

6-7



BLACK PLASTIC

EDGE

BLACK PLASTIC EDGE

HOUSE

SOUTH

NOTE:

VALLEY 2-4" DEEPER

THAN BLACK PLASTIC
EDGE AROUND HOUSE

PHONE #

778-2711

101 ENDELL