8-300680

Fall Creek Regional Waste District 9378 S 650 W, P.O. Box 59, Pendleton, IN 46064 765-778-7544 Agreement for Sanitary Sewer Service

This Agreement made and entered into this $\underline{12}$ day of $\underline{4pn}$, $20 \underline{33}$, between Fall Creek Regional Waste District ("District") and <u>Coronado</u> ("Applicant") regarding the provision of sanitary sewer service, and the assignment of capacity in and connection to, the District's facilities for the premises located at <u>Falls of Pendleton Lot 30</u>

Pintal Street Address: 457 Wan

Now therefore, the parties, in consideration of the mutual promises set out in this Agreement, the receipt and sufficiency of which is hereby acknowledged, agree as follows:

- 1. The Applicant agrees that all workmanship and materials shall conform to all District ordinances and the District's construction standards. District must accept and approve all work and materials before backfilling and final connection is made to the sewer mains. Any violation of this provision will cause all lines and appurtenances in violation to be removed and replaced at the Applicant's expense.
- 2. The District shall have the right to enter upon the Applicant's premises at all reasonable times to inspect, repair, or replace any equipment used in connection with the District's service or which has an impact on said service.
- 3. The Applicant shall be responsible for all monthly user rates, capacity charges, and tap fees. The failure to pay any rate charge or fee may result in a lien against the property and/or the termination of service to the property, the cost of which will be borne by Applicant, including, but not limited to, all attorney's fees and collection costs.
- 4. The District shall not be responsible for any damages as a result of any failure to supply service unless said damages are due to default, neglect or culpability on the part of the District.
- 5. If there is an available sanitary sewer within three hundred (300) feet of the property line, the property owner shall be required to connect to the District's sanitary sewer system.
- 6. The Applicant and District agree that the provision of sanitary sewer service touches and concerns the property and the terms of this Agreement bind the District and Applicant and their heirs, executors, administrators, personal representatives, successors, agents, attorneys, assigns, designees, and transferees.

The parties hereto have read and fully understand the above provisions and agree to comply with said provisions.

FALL CREEK REGIONAL WASTE DISTRICT	
Signature	Signature
STATE OF INDIANA)	
) SS: COUNTY OF MADISON)	
SUBSCRIBED and sworn to before me this _	12 day of April, 20 21
My Commission Expires SEAL	Signature Rochel E. the
RACHEL ELAINE ANDERSON NOTARY PUBLIC-STATE OF INDIANA MADISON COUNTY	Printed Rachel E. Anderson
MY COMM. EXPIRES OCTOBER 23, 2021	Notary Public Resident of <u>Maduson</u> County
Inspector	_ Approved Rejected
Reason for Rejecton Date Reinspected	
Notes: / 4 Dub 2	Approved Rejected
Size Pipe 0 Type Pipe 100 35	
Basement <u>Yes No</u> Sump Pump <u>Yes</u> No	North
Downspout to Ground <u>Yes</u> No	
Septic Tank Pumped & Filled Yes No	
Contractor ULWARD	
Special Conditions	
Existing Home	
New Construction	

#6696





Falls of Pendleton Lot 30

Don Moore 4/13/2021

4-13-21 Fauls of 7-Tomm LOT 30 DR MATSON EX. 457 Peritol way GARATE Inbur

Falls of Pendleton Lot 30

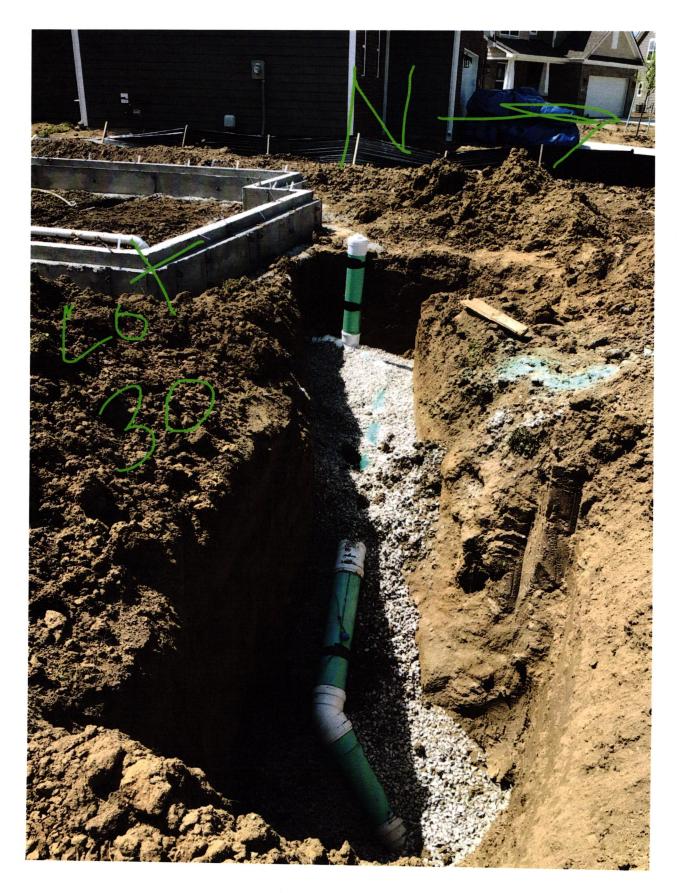



CLAYTON PROPERTIES GROUP ARBOR HOMES SILVERTHORNE HOMES PERMIT ACCOUNT	71-65/749 First Merchants Bank 044328
9225 HARRISON PARK COURT INDIANAPOLIS, IN 46216 PAY TO THE	DATE 4/12/21
Seven hundred sixty and 00/100	\$ 760.00 Dollars
	NOT VALID FOR AMOUNTS OVER \$10,000

1

Leve Ollosz

•