add Order on file

4425

FALL CREEK REGIONAL WASTE DISTRICT

9378 S 650 WEST, P.O. BOX 59, PENDLETON, IN 46064

765-778-7544

26-04480.00

AGREEMENT FOR SANITARY SEWER SERVICE

This Agreement made and entered into this 11th day of June, 2001, between FALL CREEK REGIONAL WASTE DISTRICT ("District") and Joe Lintz ("Applicant") regarding the provision of sanitary sewer service, and the assignment of capacity in, and connection to, the District's facilities for the premises located at 6343 White Oaks Dr

NOW THEREFORE, the parties, in consideration of the mutual promises set out in this Agreement, the receipt and sufficiency of which is hereby acknowledged, agree as follows:

1. The Applicant agrees that all workmanship and materials shall conform to all District ordinances and the District's construction standards. District must accept and approve all work and materials before backfilling and final connection is made to the sewer mains. Any violation of this provision will cause all lines and appurtenances in violation to be removed and replaced at the Applicant's

2. The District shall hav ant's premises at all reasonable times to inspect, repair, or replace any equi District's service or which has an impact on said service.

Put in Jims mailbox 6-11-01

3. The Applicant shall b tes, capacity charges, and tap fees. The failure to pay any rate charge o property and/or the termination of service to the property, the cost of which will be b t limited to, all attorney's fees and collection costs.

4. The District shall not be responsible for any damages as a result of any failure to supply service unless said damages are due to default, neglect or culpability on the part of the District.

5. If there is an available sanitary sewer within three hundred (300) feet of the property line, the property owner shall be required to connect to the District's sanitary sewer system.

6. The Applicant and District agree that the provision of sanitary sewer service touches and concerns the property and the terms of this Agreement bind the District and Applicant and their heirs, executors, administrators, personal representatives, successors, agents, attorneys, assigns, designees, and transferees.

The parties hereto have read and fully understand the above provisions and agree to comply with said provisions.

FALL CREEK REGIONAL WASTE DISTRICT

Signature

APPLICANT

Signature

STATE OF INDIANA)
) SS:
COUNTY OF MADISON)

SUBSCRIBED and sworn to before me this _____ day of _____, 200___.

My Commission Expires:

Signature

Printed

Notary Public
Resident of Madison County

****

INSPECTOR Bill DATE INSPECTED 6-12-01 APPROVED ✓ REJECTED

REASON FOR REJECTION

DATE REINSPECTED APPROVED REJECTED

NOTES:
SIZE PIPE 4 TYPE PIPE 35

BASEMENT YES NO X

SUMP PUMP YES NO X

DOWNSPOUT TO GROUND YES X NO

SEPTIC TANK PUMPED & FILLED YES X NO Fish

CONTRACTOR Self

SPECIAL CONDITIONS

EXISTING HOME X
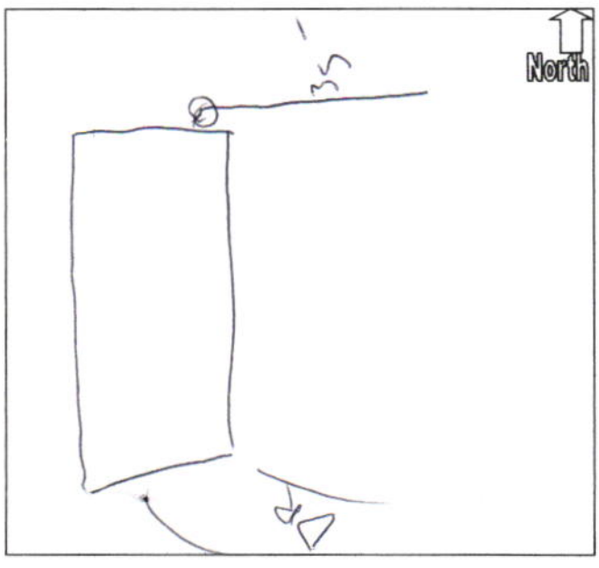
NEW CONSTRUCTION