



10-4-19

Maple Trails

lot 49

DR Watson Ex.

N
↓

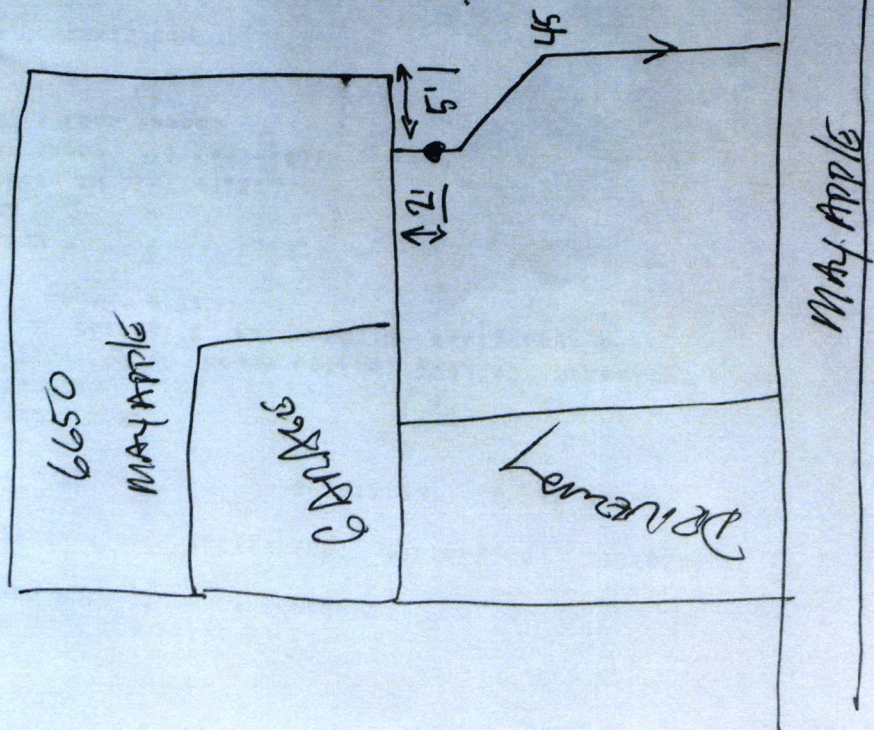


