8-18343.02

4405

FALL CREEK REGIONAL WASTE DISTRICT

9378 S 650 WEST, P.O. BOX 59, PENDLETON, IN 46064

765-778-7544

AGREEMENT FOR SANITARY SEWER SERVICE

This Agreement made and entered into this 22nd day of May, 2001, between FALL CREEK REGIONAL WASTE DISTRICT ("District") and Betty Price ("Applicant") regarding the provision of sanitary sewer service, and the assignment of capacity in, and connection to, the District's facilities for the premises located at 670 N Pendleton Ave..

NOW THEREFORE, the parties, in consideration of the mut[illegible] Agreement, the receipt and sufficiency of which is hereby acknowledged, agree as follows:

Put in Tims mailbox 11-14-01

1. The Applicant agrees that all workmanship and materia[illegible] nces and the District's construction standards. District must accept and appro[illegible] kfilling and final connection is made to the sewer mains. Any violation of this provis[illegible] ances in violation to be removed and replaced at the Applicant's expense.

2. The District shall have the right to enter upon the Applicant's pre[illegible] times to inspect, repair, or replace any equipment used in connection with the District's service or wh[illegible] n impact on said service.

3. The Applicant shall be responsible for all monthly user rates, capacity charges, and tap fees. The failure to pay any rate charge or fee may result in a lien against the property and/or the termination of service to the property, the cost of which will be borne by Applicant, including, but not limited to, all attorney's fees and collection costs.

4. The District shall not be responsible for any damages as a result of any failure to supply service unless said damages are due to default, neglect or culpability on the part of the District.

5. If there is an available sanitary sewer within three hundred (300) feet of the property line, the property owner shall be required to connect to the District's sanitary sewer system.

6. The Applicant and District agree that the provision of sanitary sewer service touches and concerns the property and the terms of this Agreement bind the District and Applicant and their heirs, executors, administrators, personal representatives, successors, agents, attorneys, assigns, designees, and transferees.

The parties hereto have read and fully understand the above provisions and agree to comply with said provisions.

FALL CREEK REGIONAL WASTE DISTRICT
Debbie Wilson
Signature

APPLICANT
Mark Niggemeyer
Signature

STATE OF INDIANA)
) SS:
COUNTY OF MADISON)

SUBSCRIBED and sworn to before me this 22nd day of May, 2001.

My Commission Expires:
2-20-2008

Signature Deborah L. Wilson
Printed Deborah L. Wilson
Notary Public
Resident of Madison County

****

INSPECTOR Tim DATE INSPECTED 11-14-01 APPROVED ✓ REJECTED _____

REASON FOR REJECTION _____

DATE REINSPECTED _____ APPROVED _____ REJECTED _____

NOTES:
SIZE PIPE 4" 1½ TYPE PIPE 35/160

BASEMENT YES ✓ NO

SUMP PUMP YES ✓ NO

DOWNSPOUT TO GROUND YES ✓ NO

SEPTIC TANK PUMPED & FILLED YES ✓ NO

CONTRACTOR Fredericks

SPECIAL CONDITIONS 4" Grade very low

EXISTING HOME ✓
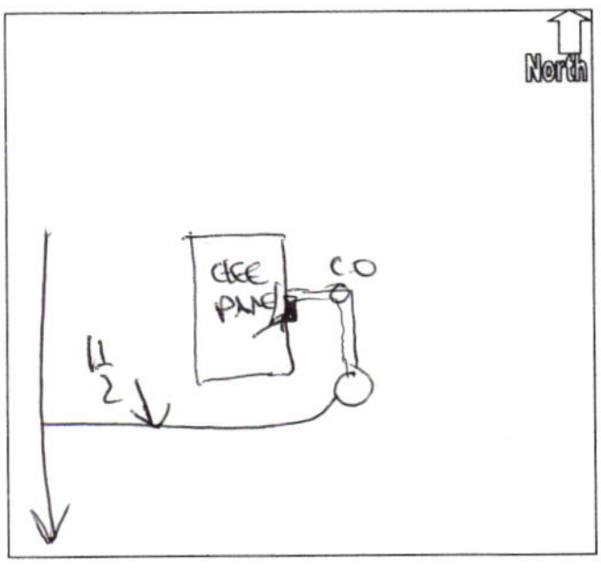
NEW CONSTRUCTION _____