



# FALL CREEK REGIONAL WASTE DISTRICT

9378 S. 650 West PO Box 59  
Pendleton, IN 46064-0059 778-7544

23-02040.00

## APPLICATION FOR SEWER PERMIT

Nº 2536

Date 29 July 1998

Permit Void 90 days from Date of Issuance

Owner Name

Russell Scott

Property Address 6725 South Spring Street

Lot # Huntsville

S PT 12 L 001

P.O. Box

N/A

Town Pendleton

IN Zip Code

46064

Phone (765) 778-8068

City Water

Well X

\$ N/A

Tap on Fee Paid

\$ N/A

Inspection fee paid

Application is hereby made for connection to the Fall Creek Regional Waste District Sewer System for the above listed property - Permit Type: Residential ☒, Commercial ☐, Industrial ☐, or Governmental/Institutional ☐. User Information

All workmanship and materials shall conform to the standards of the District Ordinance as described in Ordinance 84-2 and 84-3 as amended. Acceptance and approval must be made by the District inspector or his duly authorized representative before backfilling and final connection is made to the main sewer lines. Any violation of applicable regulations will cause all lines and appurtenances in violation to be removed and replaced at the owners expense.

The Fall Creek Regional Waste District is responsible for the inspection, approval of materials, and installation techniques only. All costs for materials and installation and any liabilities resulting from same is the sole responsibility of the property owner.

I have read and fully understand the above provisions and agree to comply by said provisions.

Russell L. Scott  
APPLICANT(S) SIGNATURE

INSPECTOR

B

Date inspected

11-4-98

Approved

✓

Rejected

Reason for rejection

Date reinspected

Approved

Rejected

Notes:

Size Pipe

6

"

Type Pipe

PVC 160

Basement Yes

✓

No

Sump Pump Yes

No

X

Downspout to Ground Yes

X

No

Septic Tank Pumped & filled Yes

X

No

Contractor

EARL DAVIS


Special Conditions

Existing Home

X

New Construction

North

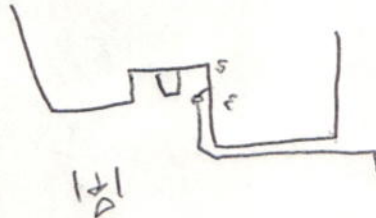



FALL CREEK REGIONAL WASTE DISTRICT  






















