8-12737.00


#7748

Fall Creek Regional Waste District 9378 S 650 W, P.O. Box 59, Pendleton, IN 46064 765-778-7544

Agreement for Sanitary Sewer Service

This Agreement made and entered into this day of March, 2020, between Fall Creek Regional Waste District ("District") and	
Street Address: 680 Blarney B	1. Pendutan
Now therefore, the parties, in consideration of the mutual promises set out in this Agreement, the receipt and sufficiency of which is hereby acknowledged, agree as follows:	
 The Applicant agrees that all workmanship and materials shall conform to all District ordinances and the District's construction standards. District must accept and approve all work and materials before backfilling and final connection is made to the sewer mains. Any violation of this provision will cause all lines and appurtenances in violation to be removed and replaced at the Applicant's expense. 	
2. The District shall have the right to enter upon the Applicant's premises at all reasonable times to inspect, repair, or replace any equipment used in connection with the District's service or which has an impact on said service.	
3. The Applicant shall be responsible for all monthly user rates, capacity charges, and tap fees. The failure to pay any rate charge or fee may result in a lien against the property and/or the termination of service to the property, the cost of which will be borne by Applicant, including, but not limited to, all attorney's fees and collection costs.	
 The District shall not be responsible for any damages as unless said damages are due to default, neglect or culpa 	s a result of any failure to supply service
5. If there is an available sanitary sewer within three hundred (300) feet of the property line, the property owner shall be required to connect to the District's sanitary sewer system.	
6. The Applicant and District agree that the provision of sa concerns the property and the terms of this Agreement beheirs, executors, administrators, personal representative designees, and transferees.	anitary sewer service touches and bind the District and Applicant and their
The parties hereto have read and fully understand the above provisions and agree to comply with said provisions.	
FALL CREEK REGIONAL WASTE DISTRICT Signature	APPLICANT Signature
STATE OF INDIANA)) SS: COUNTY OF MADISON)	
SUBSCRIBED and sworn to before me this day of, 20	
My Commission Expires: Signature	
Printed	4 - D.4.0.
Notary Public Resident of County ***********************************	
Inspector Date Inspected //// Approved N Rejected	
Reason for Rejecton Date Reinspected Approved	
Notes: Size Pipe $\frac{\sqrt{g''}}{g''}$ Type Pipe $\frac{\sqrt{g''}}{g'}$ 35	Nejecteu
Basement <u>Yes No</u>	North
Sump Pump <u>Yes No</u> Downspout to Ground Yes No	
Septic Tank Pumped & Filled Yes No	December
Contractor Ni S Krc Special Conditions	or awing
Existing Home New Construction	4
New ConstructionX	1
	2 pictores



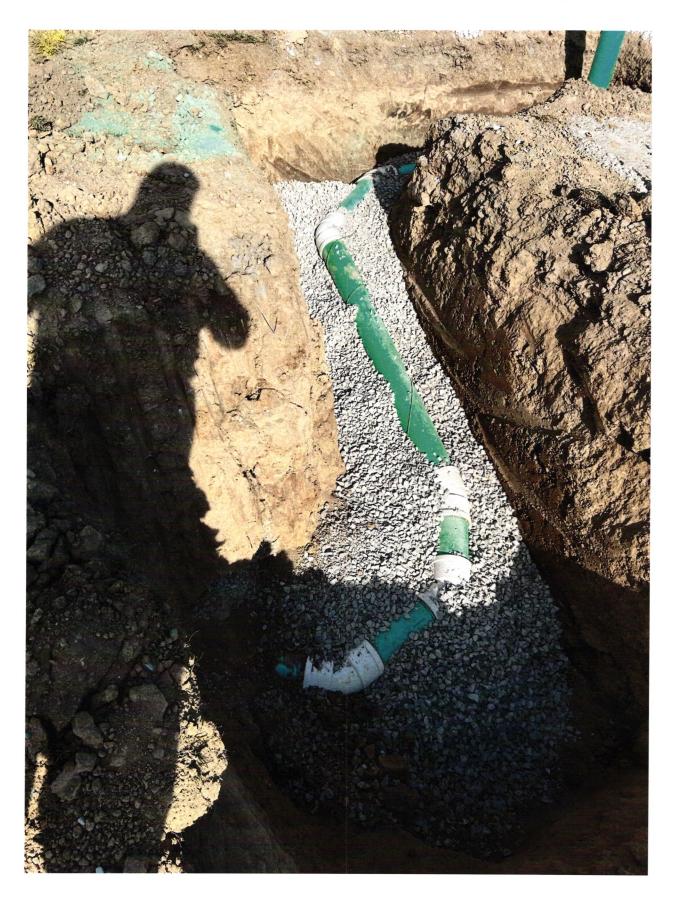



THIS CHECK IS PRINTED IN RED AND BLUE INK ON THE FACE ON CHEMICAL AND BLEACH REACTIVE PAPER WITH INVISIBLE FLUORESCENT FIBERS AND BASKETWEAVE ON BACK D.R.HORTON Builder **Check Number** 1471006 JP Morgan Chase Bank, N.A. Syracuse, NY 50-937 **DRH Inc. Controlled Disb** Date Amount 213 1341 Horton Circle \$******760.00 03/16/22 Arlington, TX 76011 2720128 Void after 6 months from date of issue SEVEN HUNDRED SIXTY AND 00/100 ******* Pay To The Order Of: FALL CREEK REGIONAL WASTE DISTRICT 9378 SOUTH 650 WEST PENDLETON IN 46064 D. L. Hacton

CG 159

li

012167