

№ 5846

765-778-7544

Hand-drawn diagram of a trapezoid with a rectangular extension. The main trapezoid has a top-left angle of 45° , a top-right angle of $28\frac{1}{2}^\circ$, and a bottom-left angle of 45° . The bottom side is labeled 180. A rectangular extension is attached to the right side of the trapezoid.

39349

C.P. MORGAN COMMUNITIES, LP
CONSTRUCTION ACCOUNT

JPMORGAN CHASE BANK, N.A.
INDIANAPOLIS, INDIANA 46277
20-1-740

10/24/2005

PAY TO THE
ORDER OF

Fall Creek Regional Waste Dist

*****950.00


Nine Hundred Fifty and no/100*****

\$

DOLLARS

Fall Creek Regional Waste Dist

MEMO

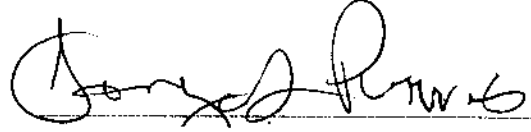

MP

⑈039349⑈ ⑈074000010⑈