



Drawing  
+  
1 picture  
attached





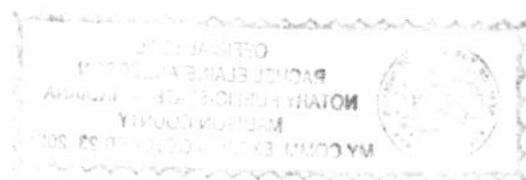

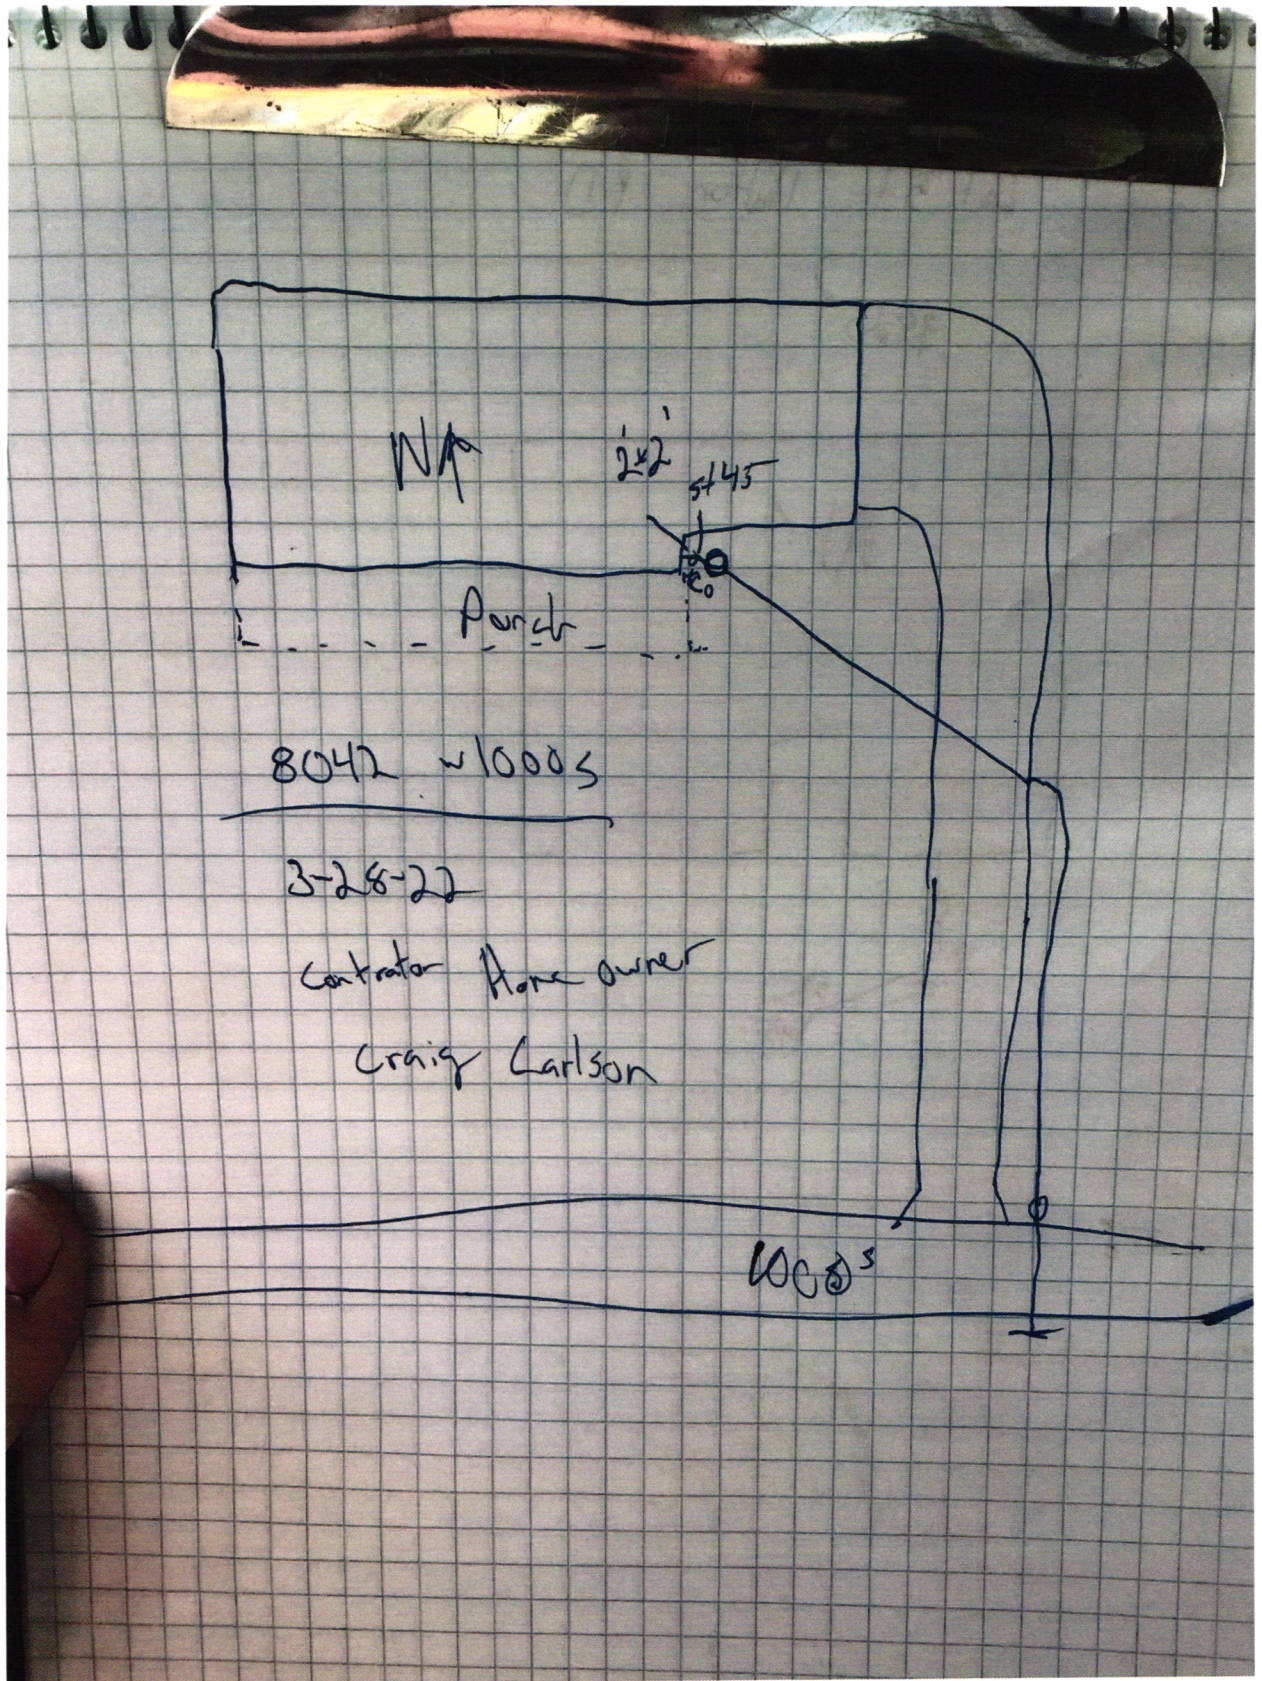



10/29/2019

[https://classic.convergepay.com/VirtualMerchant/transaction.do?dispatchMethod=printTransaction&hdnflid\\_transactionId=291019A43-B...](https://classic.convergepay.com/VirtualMerchant/transaction.do?dispatchMethod=printTransaction&hdnflid_transactionId=291019A43-B...)

FALL CREEK REGIONAL WASTE DISTRI  
9378 S 650 W  
PO BOX 59  
PENDLETON, IN 46064  
765-778-7544

FALL CREEK REGIONAL WASTE DIST

Date: 10/29/2019 03:17:39 PM

CREDIT CARD SALE

MASTERCARD

CARD NUMBER: \*\*\*\*\*1926 K

TRAN AMOUNT: \$570.00

APPROVAL CD: 02191Z

RECORD #: 000

CLERK ID: Rachel

CUST CODE: permit

SALES TAX: \$0.00

INVOICE #: permit

Rec# 011042

Thank you for your business!

Customer Copy

Pay Agreements  
Grinders  
Capacity