




Maple Trails Lot # 271

D.R. Watson

4/15/24

N ←

8/50 Copperleaf Ln.

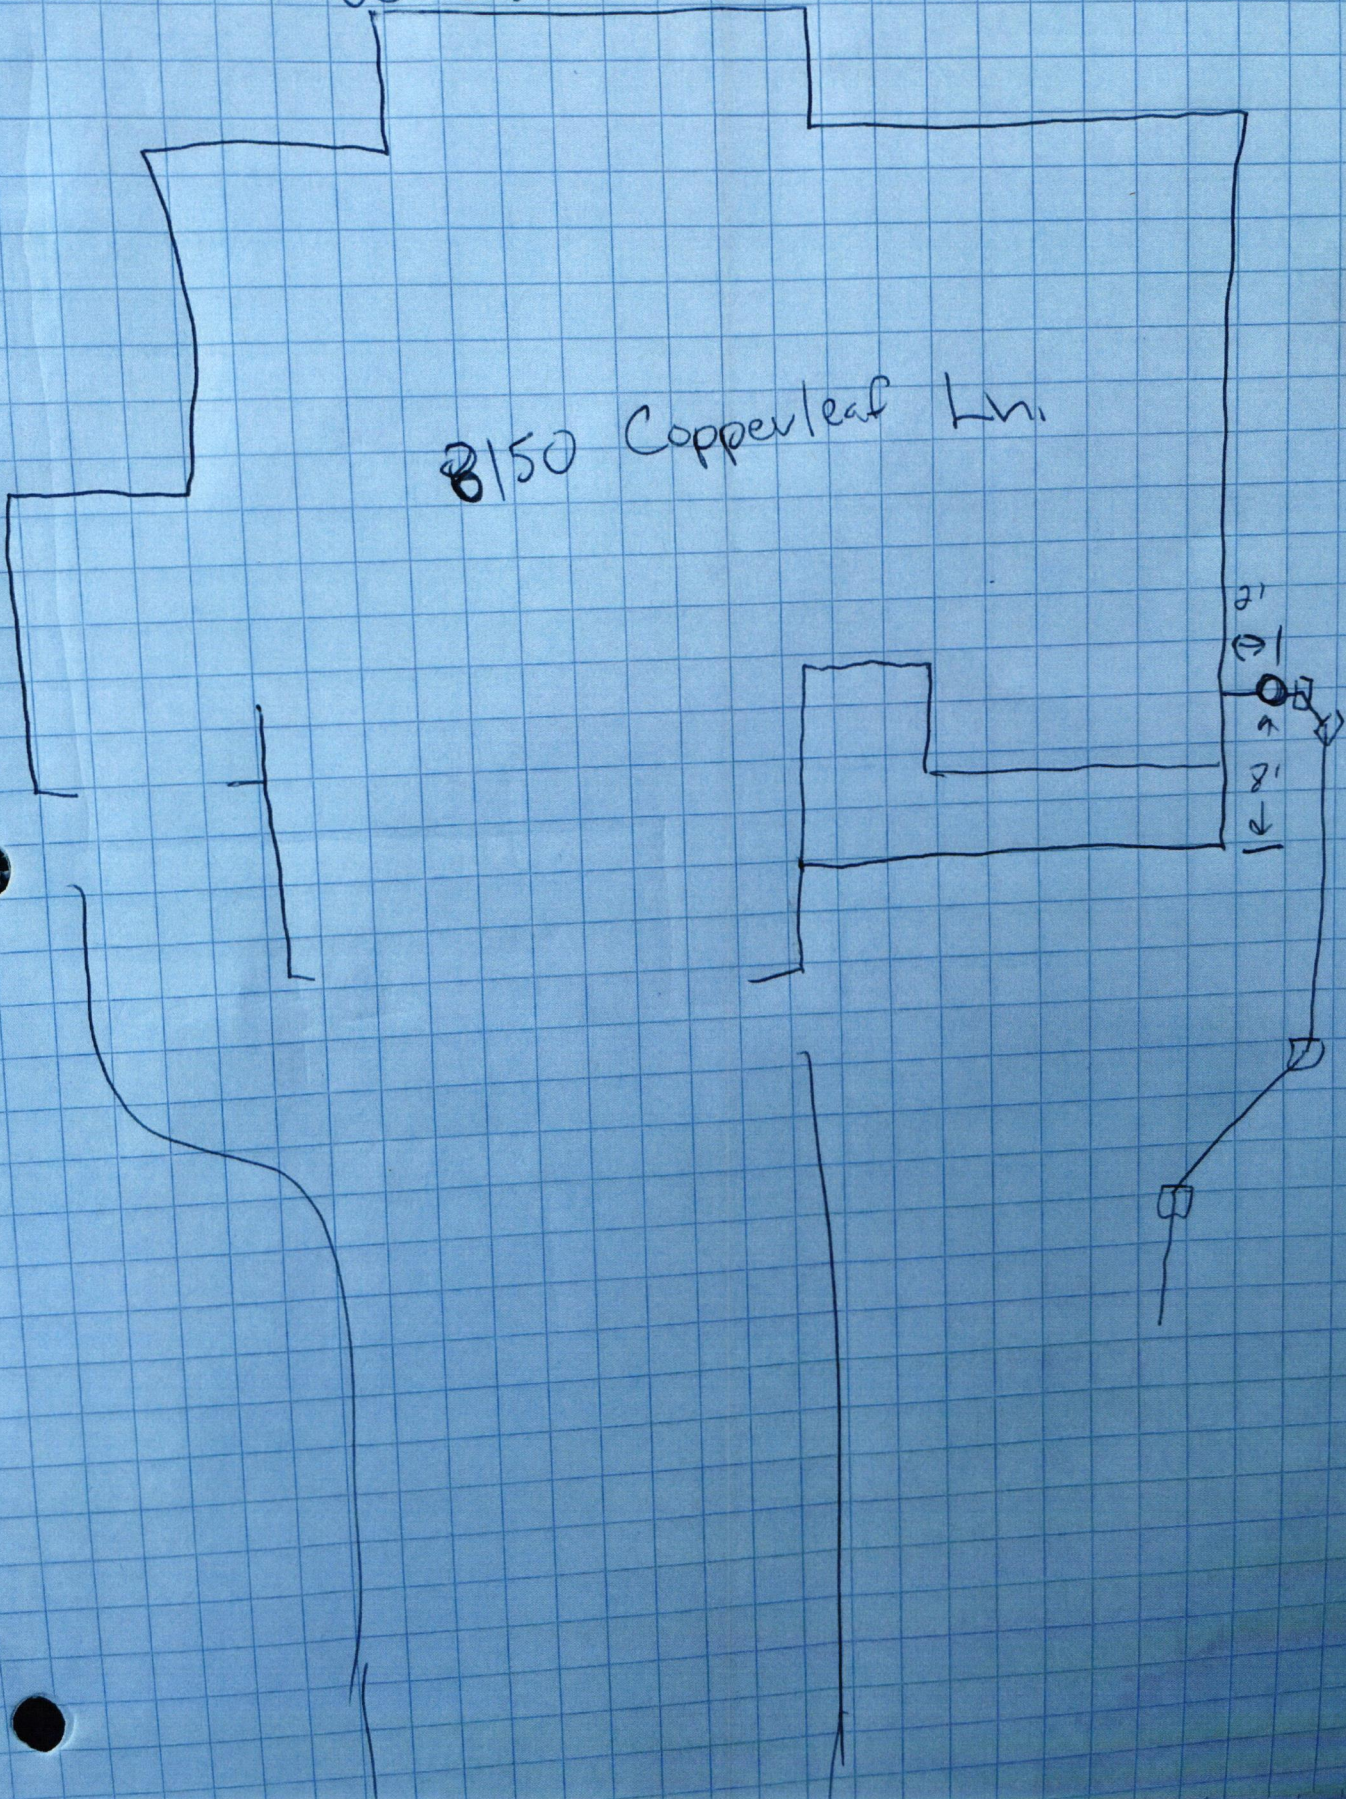



#271





