

№ 5512

765-778-7544


36820

C.P. MORGAN COMMUNITIES, LP
CONSTRUCTION ACCOUNT

BANK ONE, NA
INDIANAPOLIS, INDIANA 46277
20-1-740

4/5/2005

**13,175.00


PAY TO THE ORDER OF Fall Creek Regional Waste Dist

Thirteen Thousand One Hundred Seventy-Five and no/100***** DOLLARS

Fall Creek Regional Waste Dist

MEMO

⑈036820⑈ ⑆074000010⑆ 705001387194⑈

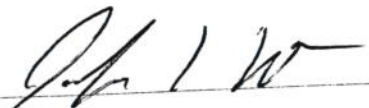

MP

Outside of bank
Construction Enclosed Included

