


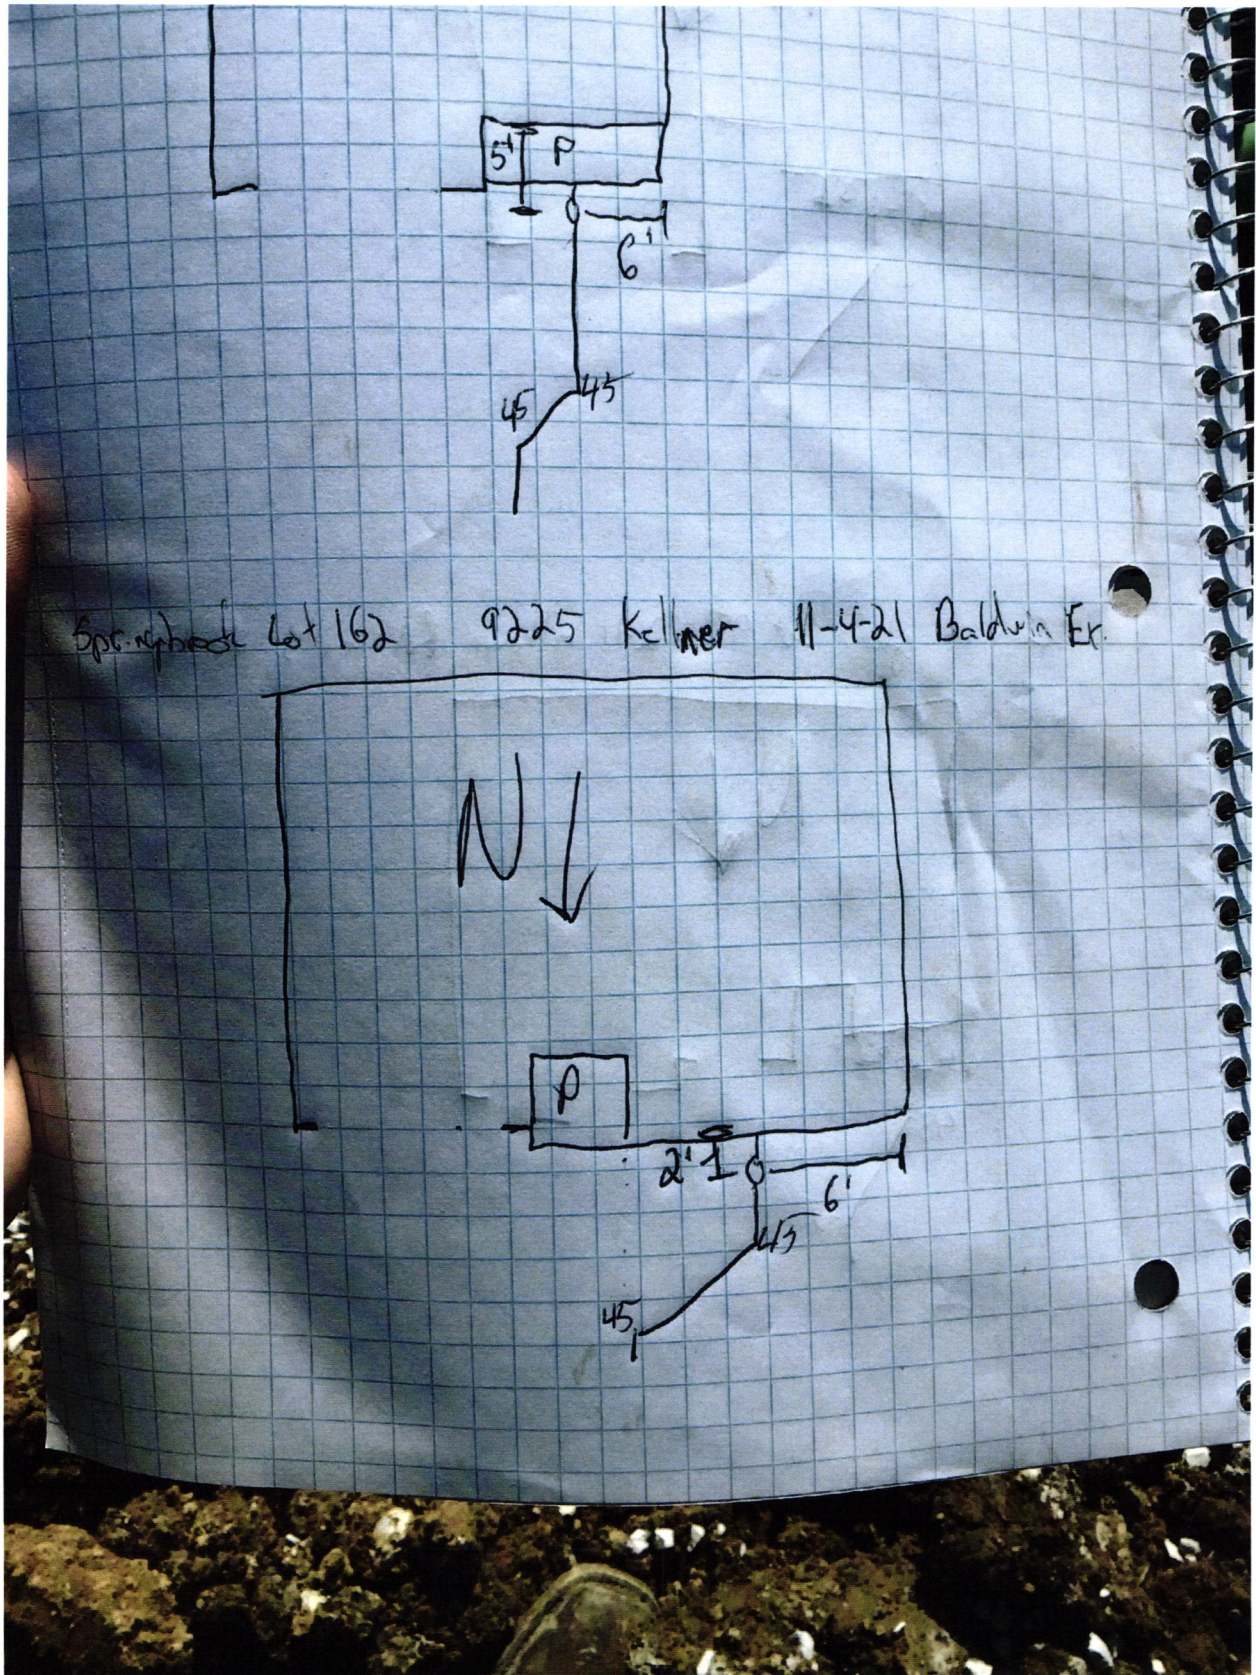
North 

Drawing  
+  
2 pictures  
attached

















Lennar Corporation  
Lennar Homes of Indiana, Inc.  
Indianapolis Division  
11555 N Meridian St Ste 400  
Carmel, IN 46032

CHECK  
NUMBER 1648465

70-2322  
719


July 12, 2021

\*\*\* VOID AFTER 180 DAYS \*\*\*

PAY FALL CREEK REGIONAL WASTE DISTRICT  
TO THE PO BOX 59  
ORDER OF: PENDLETON, IN 46064

CHECK AMOUNT  
**\$760.00**

EXACTLY \*\*\*\*\*760 DOLLARS AND 00 CENTS

 Security features  
included.  
Details on back.

JPMorgan Chase Bank, N.A.  
Chicago, IL



Authorized Signature

Rec # 011778