FALL CREEK REGIONAL WASTE DISTRICT
9378 S. 650 West PO Box 59
Pendleton, IN 46064-0059 778-7544

APPLICATION FOR SEWER PERMIT

№ 2530

Date _____

Permit Void 90 days from Date of Issuance

Owner Name Chuck Gluenger

Property Address Falls Park Plaza II

Lot # _____ P.O. Box _____

Town Pendleton, IN Zip Code 46064

Phone _____ City Water ✓ Well _____

$_____ Tap on Fee Paid

$_____ Inspection fee paid

Application is hereby made for connection to the Fall Creek Regional Waste District Sewer System for the above listed property - Permit Type: Residential ____, Commercial ✓, Industrial ____, or Governmental/ Institu .

Al 11/6/98 ne
Distric
Accepta duly
authori ade
to the Per Jim McCurdy, this
cause a business is on its own meter ced
at the

Th pection,
approva r
materia the
sole re

I
comply o

_____ _____
APPLICANT(S) SIGNATURE

****

INSPECTOR BCW

Date inspected 7-14-98 Approved ✓ Rejected _____

Reason for rejection _____

Date reinspected _____ Approved Rejected

Notes:
Size Pipe 6 "
Type Pipe PVC
Basement Yes No ✓
Sump Pump Yes No ✓
Downspout to Ground Yes ✓ No
Septic Tank Pumped & filled Yes No
Contractor M & M Exc. Inc
Special Conditions _____
(Green Shop)
Existing Home _____
New Construction ✓

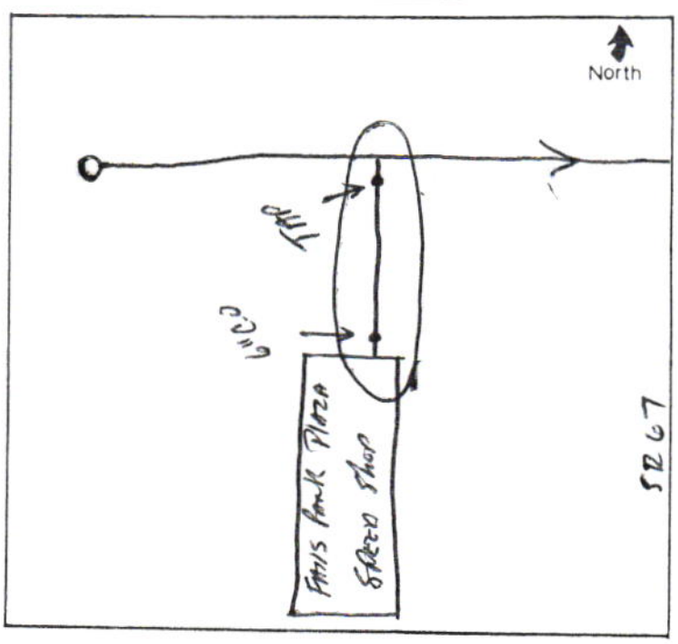

Rev. 11/84