




NOTES:

2	RENUMBERED	6-03	GCR
1	AS-BUILT	11-01	GCR
NO.	DESCRIPTION	DATE	BY
REVISIONS			

HOOSIER HILLS REGIONAL
WATER DISTRICT

C.R. 1100 NORTH WATER MAIN LINE EXTENSION

GRW PROJECT NO. 2543-42

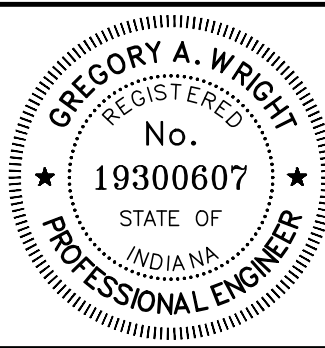

GRW
GRW Engineers, Inc.
Engineers, Architects, Planners
INDIANAPOLIS, INDIANA
LOUISVILLE & LEXINGTON, KENTUCKY
CINCINNATI, OHIO
NASHVILLE, TENNESSEE
ARLINGTON, TEXAS

DRAWN: CWH	DATE: November 2000
FILE NAME: SHT658.DWG	SCALE: 1" = 50'
CHECKED: DRC	SHEET NO.
APPROVED:	658