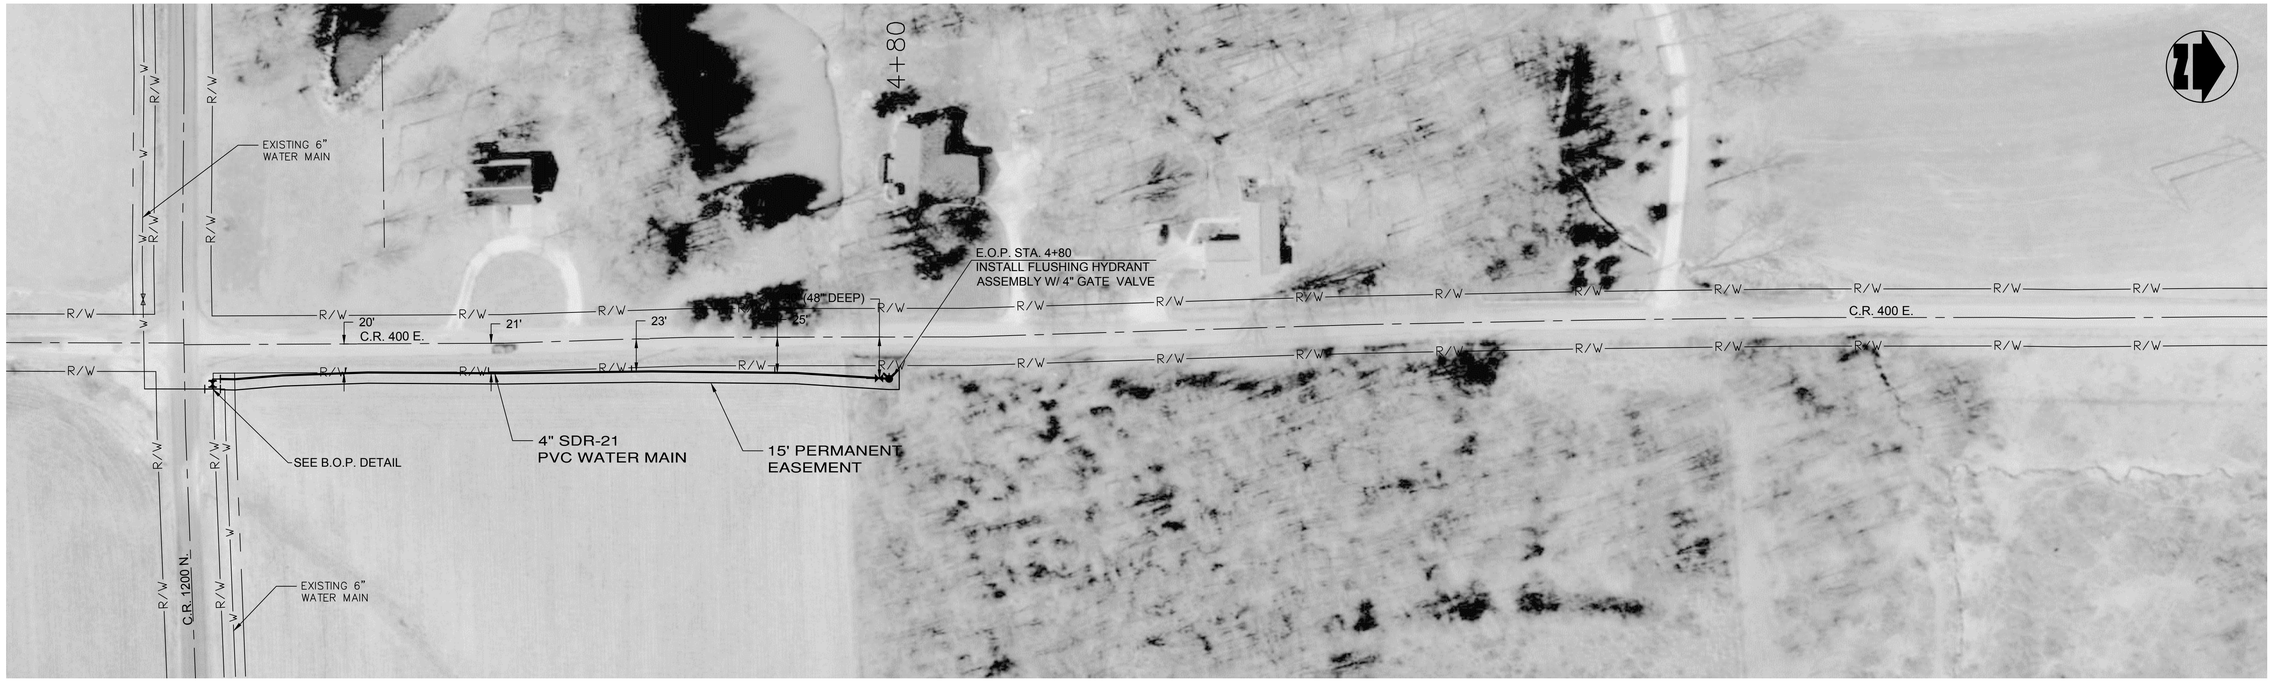

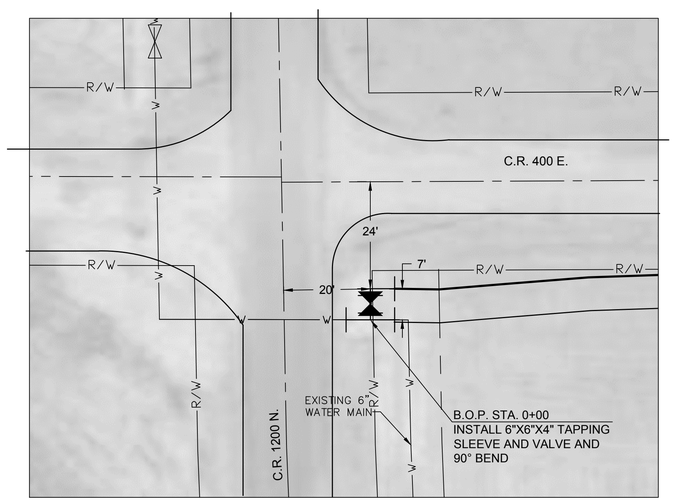

B.O.P. DETAIL

NOT TO SCALE

RECORD DRAWING

This drawing has been redlined from the original contract drawings to show minor/ major changes made during construction. This drawing is not warranted to be complete and accurate in all respects.

GRW Engineers, Inc.

Date: 12-23-09 By: TNW

GREGORY A. WRIGHT REGISTERED No. 19300607 STATE OF INDIANA PROFESSIONAL ENGINEER

GRW PROJECT NO. 3421-29

CLIENT PROJECT NO. N/A

ALL RIGHTS RESERVED
THIS DRAWING IS THE PROPERTY OF GRW ENGINEERS, INC. AND SHALL NOT BE REPRODUCED, PUBLISHED, DISTRIBUTED OR USED FOR CONSTRUCTION OF OTHER PROJECTS WITHOUT THE EXPRESS WRITTEN PERMISSION OF THE PROJECT

ENGINEERS - ARCHITECTS - PLANNERS

www.grwinc.com

HOOSIER HILLS REGIONAL WATER DISTRICT

C.R. 400 E.
WATER MAIN EXTENSION

DESIGNED: CF
DRAWN: GCR
REVIEWED: DRC
APPROVED: GAW

REVISIONS

NO.	DESCRIPTION	DATE	BY
	AS-BUILTS	12-22	TNW

SCALE CHECK: THIS MARK SHOULD MEASURE EXACTLY 1" WHEN PLOTTED

DATE: SEPTEMBER, 2009

SCALE: 1" = 50'

SHEET NO. 729

PRINTED: 3/10/2016 @ 3:44PM

FILE NAME: G:\3421-HHRWD Ann Retain\Sub 29 - CR 400 E\WORKING DRAWINGS\CIVIL 3D\3421-29-SHEET-729.dwg