


PRINTED: 3/10/2016 @ 3:14PM

FILE NAME: G:\3421-HRRWD Ann Retain\Sub-22 CR 575 E\3421-22-SHEET 727.dwg

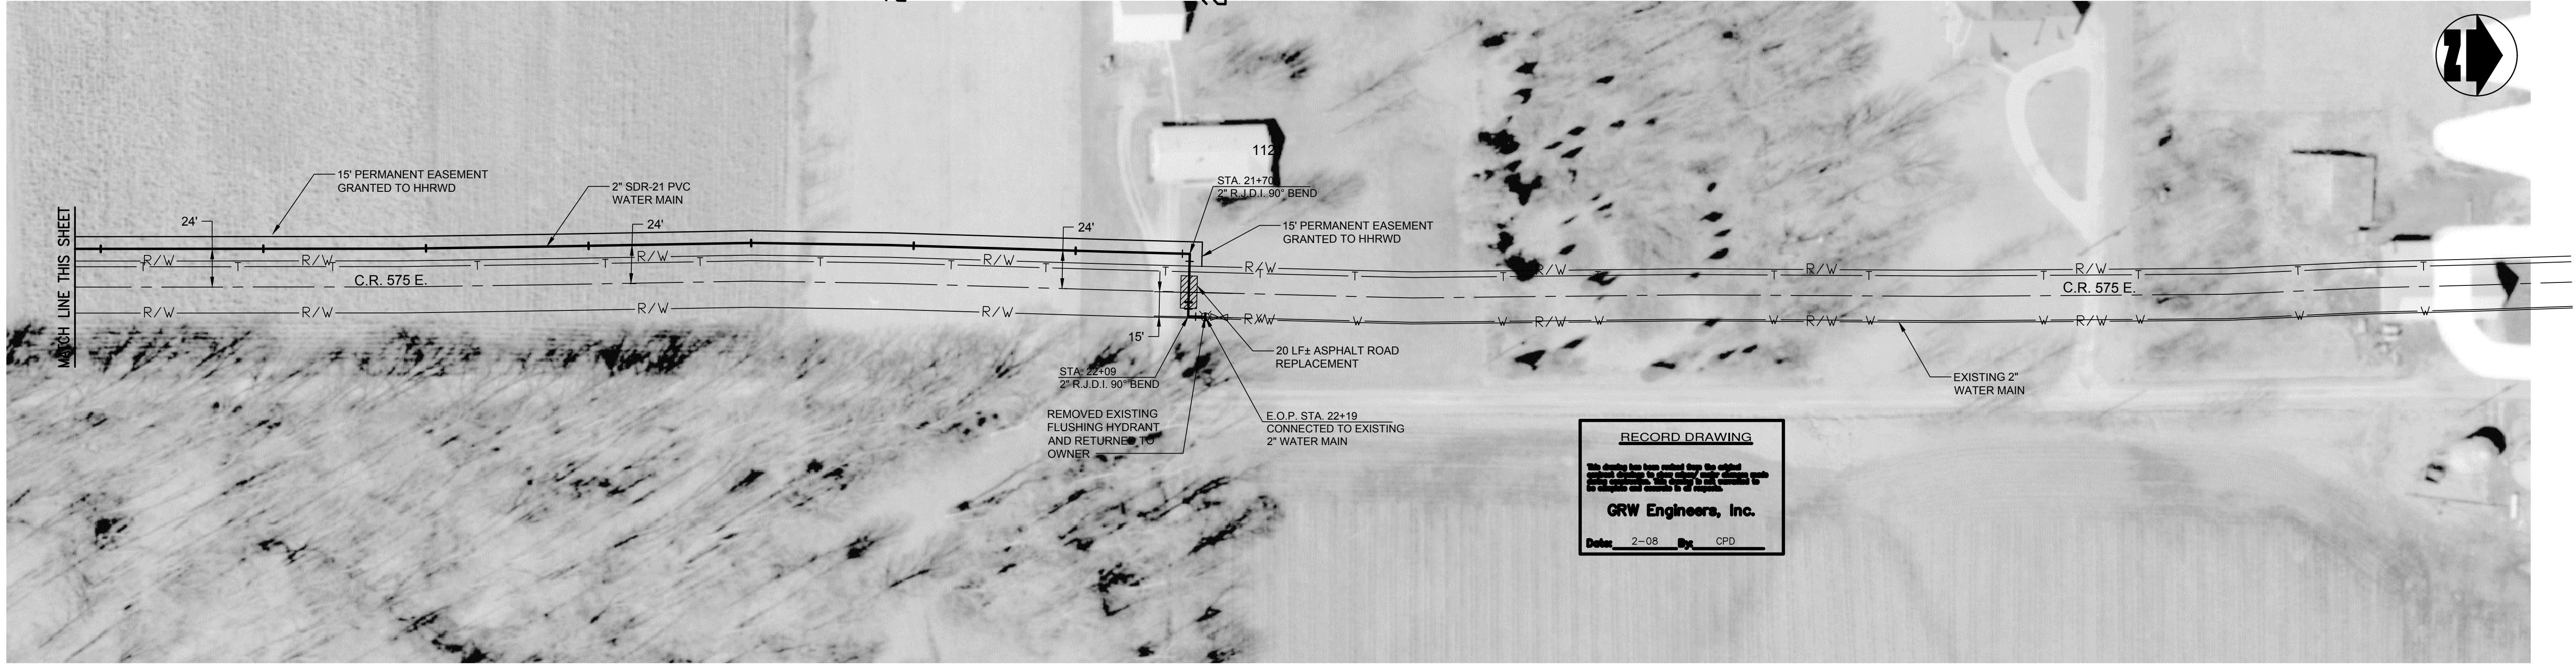

GRW PROJECT NO. 3421-22
CLIENT PROJECT NO. N/A
ALL RIGHTS RESERVED.
THIS DOCUMENT IS THE PROPERTY OF
GRW ENGINEERS, INC. AND IS NOT TO
BE REPRODUCED IN WHOLE OR IN PART
WITHOUT WRITTEN PERMISSION
OTHER THAN THIS SPECIFIC PROJECT



HOOSIER HILLS REGIONAL WATER DISTRICT
C.R. 575 E.
WATER MAIN EXTENSION

DESIGNED		DRC			
BY		BROWN			
DATE		GCR			
		REVIEWED			
NO.		DRC			
		APPROVED			
		GAW			
SCALE CHECK _____ THIS MARK SHOULD MEASURE EXACTLY 1" WHEN PLOTTED					
DATE: SEPTEMBER, 2008					
SCALE: 1" = 50'					
SHEET NO.					
727					