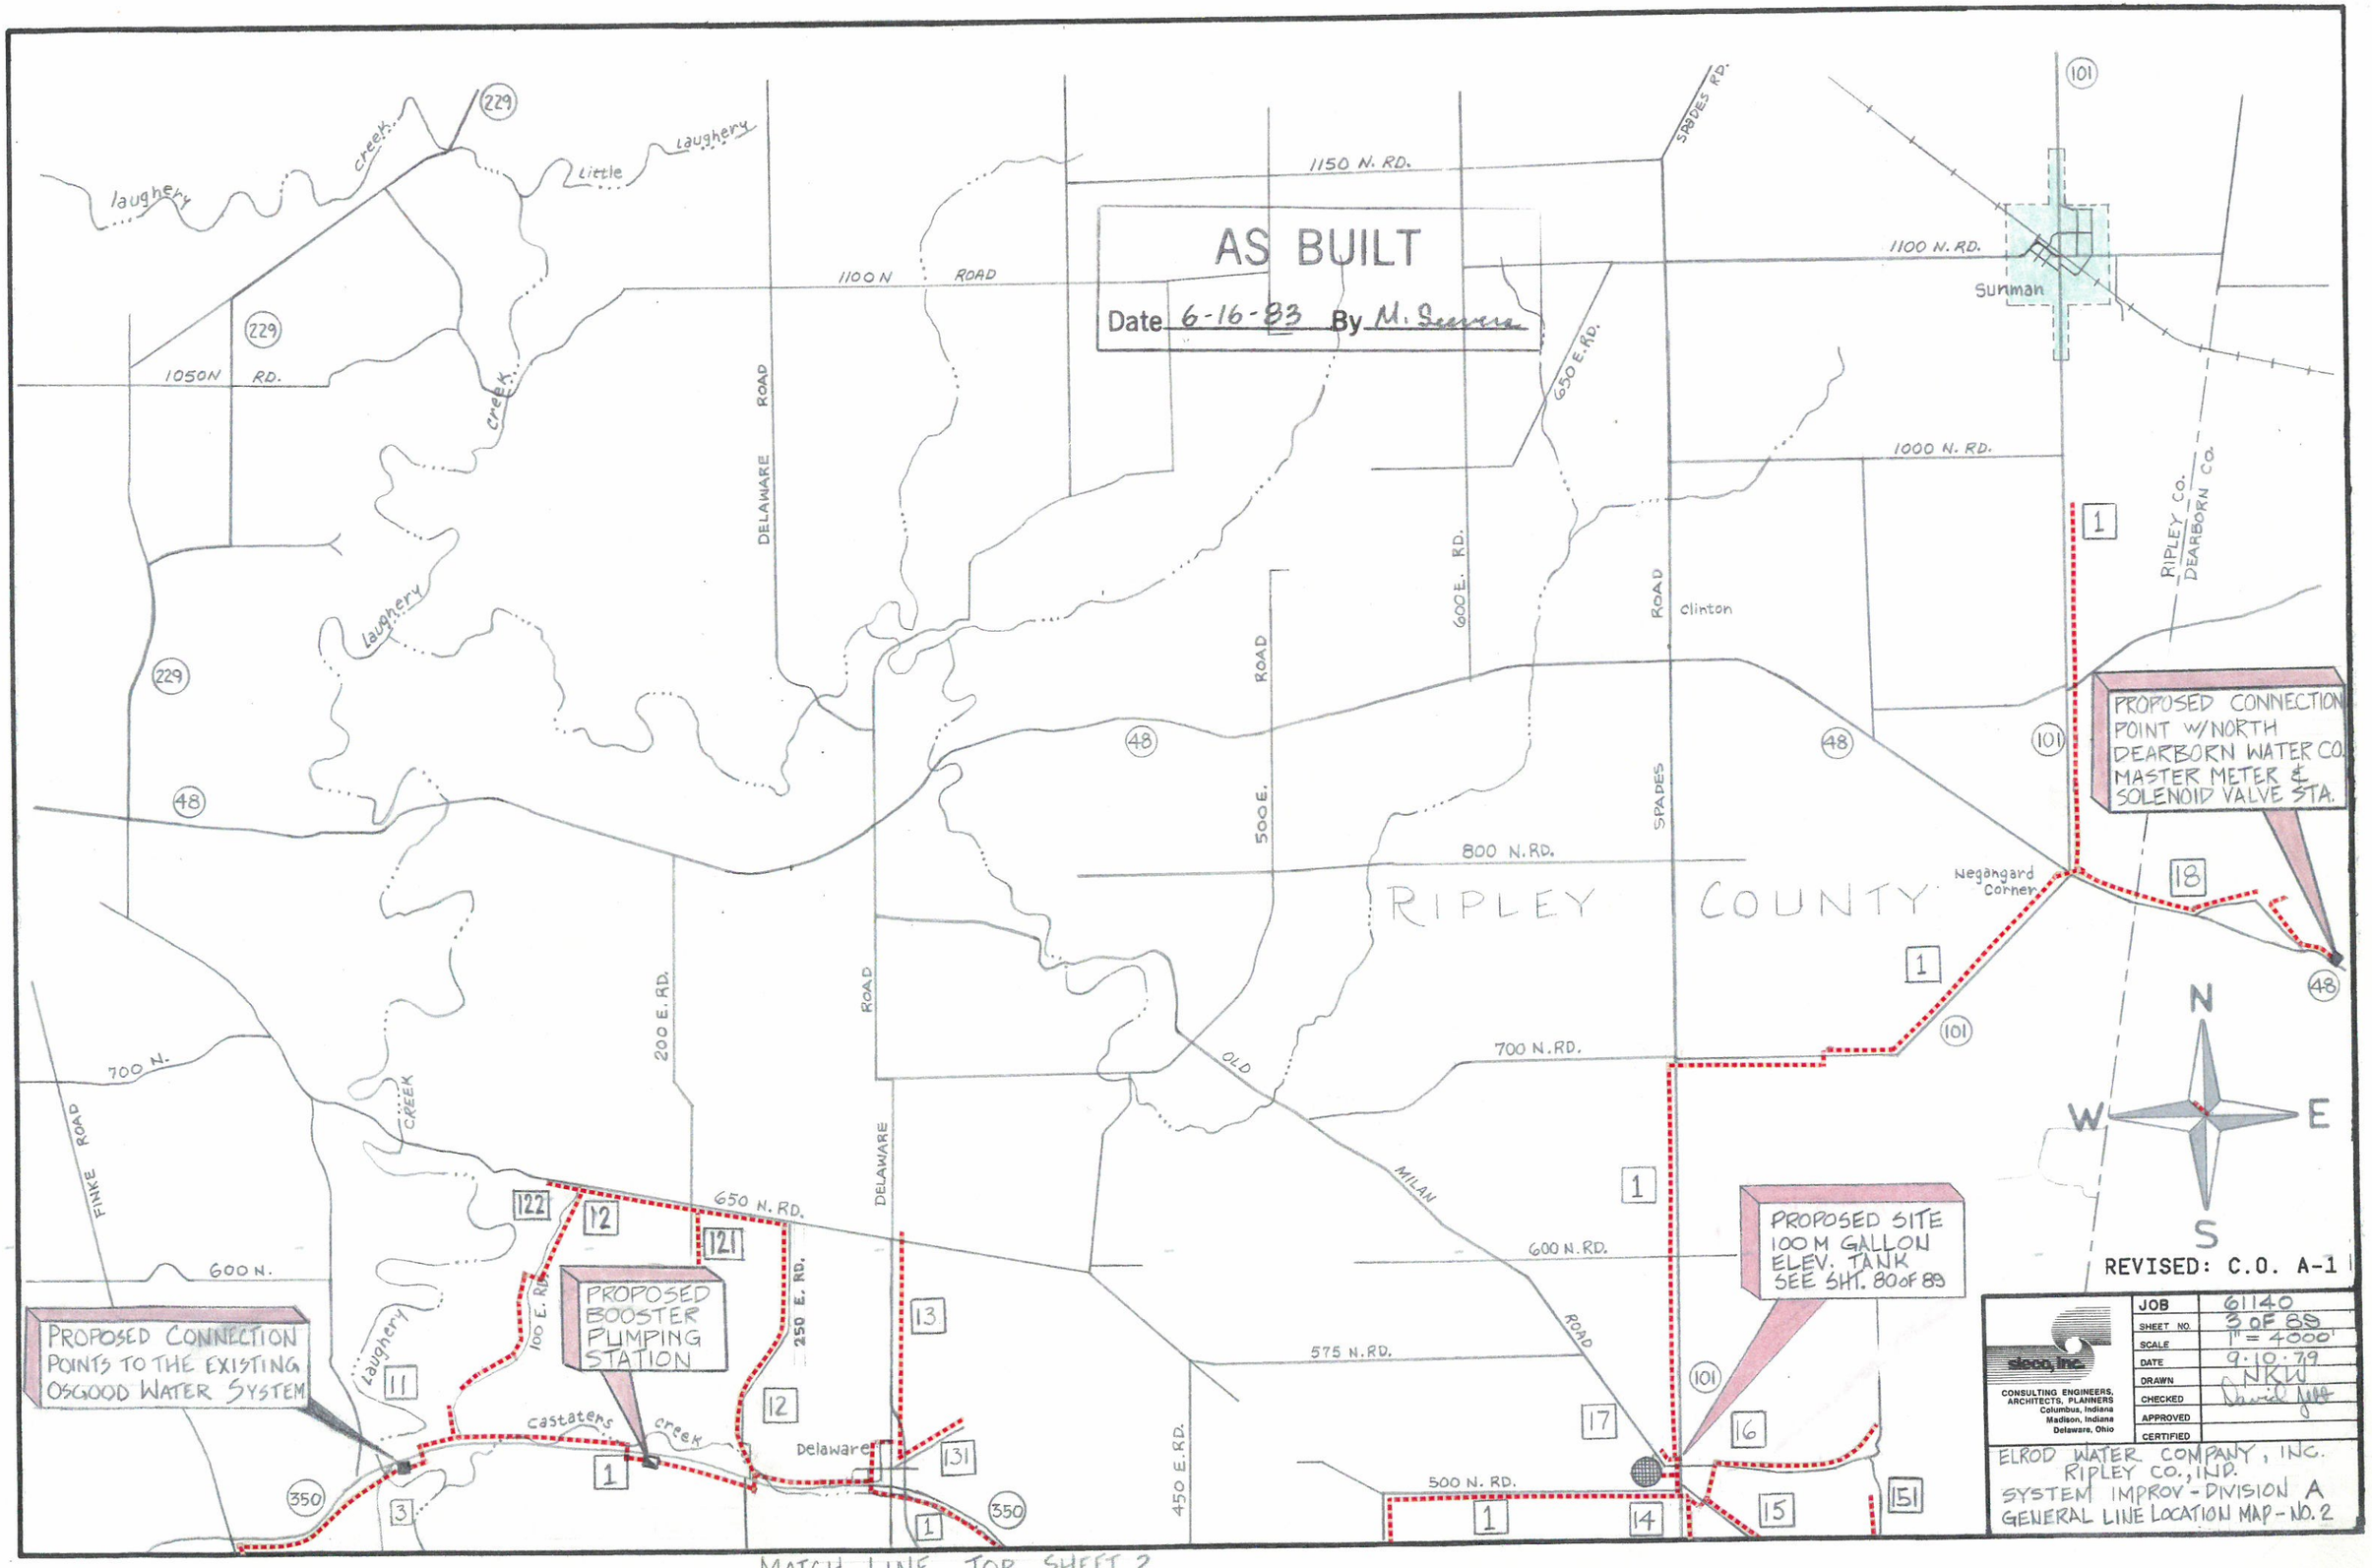
AS BUILT
Date 6-16-83 By M. Sievers
Laughery Creek
Little Laughery
1150 N. RD.
1100 N ROAD
1100 N. RD.
1050N RD.
1000 N. RD.
800 N. RD.
700 N. RD.
650 N. RD.
600 N. RD.
575 N. RD.
500 N. RD.
700 N.
600 N.
DELAWARE ROAD
600 E. RD.
650 E. RD.
500 E.
200 E. RD.
100 E. RD.
250 E. RD.
450 E. RD.
SPADES RD.
SPADES ROAD
OLD MILAN ROAD
FINKE ROAD
Sunman
Clinton
Negangard Corner
Delaware
Castaters Creek
RIPLEY COUNTY
RIPLEY Co.
DEARBORN Co.
PROPOSED CONNECTION POINT W/NORTH DEARBORN WATER CO. MASTER METER & SOLENOID VALVE STA.
PROPOSED SITE 100 M GALLON ELEV. TANK SEE SHT. 80 OF 89
PROPOSED BOOSTER PUMPING STATION
PROPOSED CONNECTION POINTS TO THE EXISTING OSGOOD WATER SYSTEM
MATCH LINE TOP SHEET 2
N
S
E
W
REVISED: C.O. A-1
JOB 61140
SHEET NO. 3 OF 89
SCALE 1" = 4000'
DATE 9-10-79
DRAWN NKW
CHECKED
APPROVED
CERTIFIED
CONSULTING ENGINEERS, ARCHITECTS, PLANNERS
Columbus, Indiana
Madison, Indiana
Delaware, Ohio
ELROD WATER COMPANY, INC.
RIPLEY CO., IND.
SYSTEM IMPROV - DIVISION A
GENERAL LINE LOCATION MAP - NO. 2