


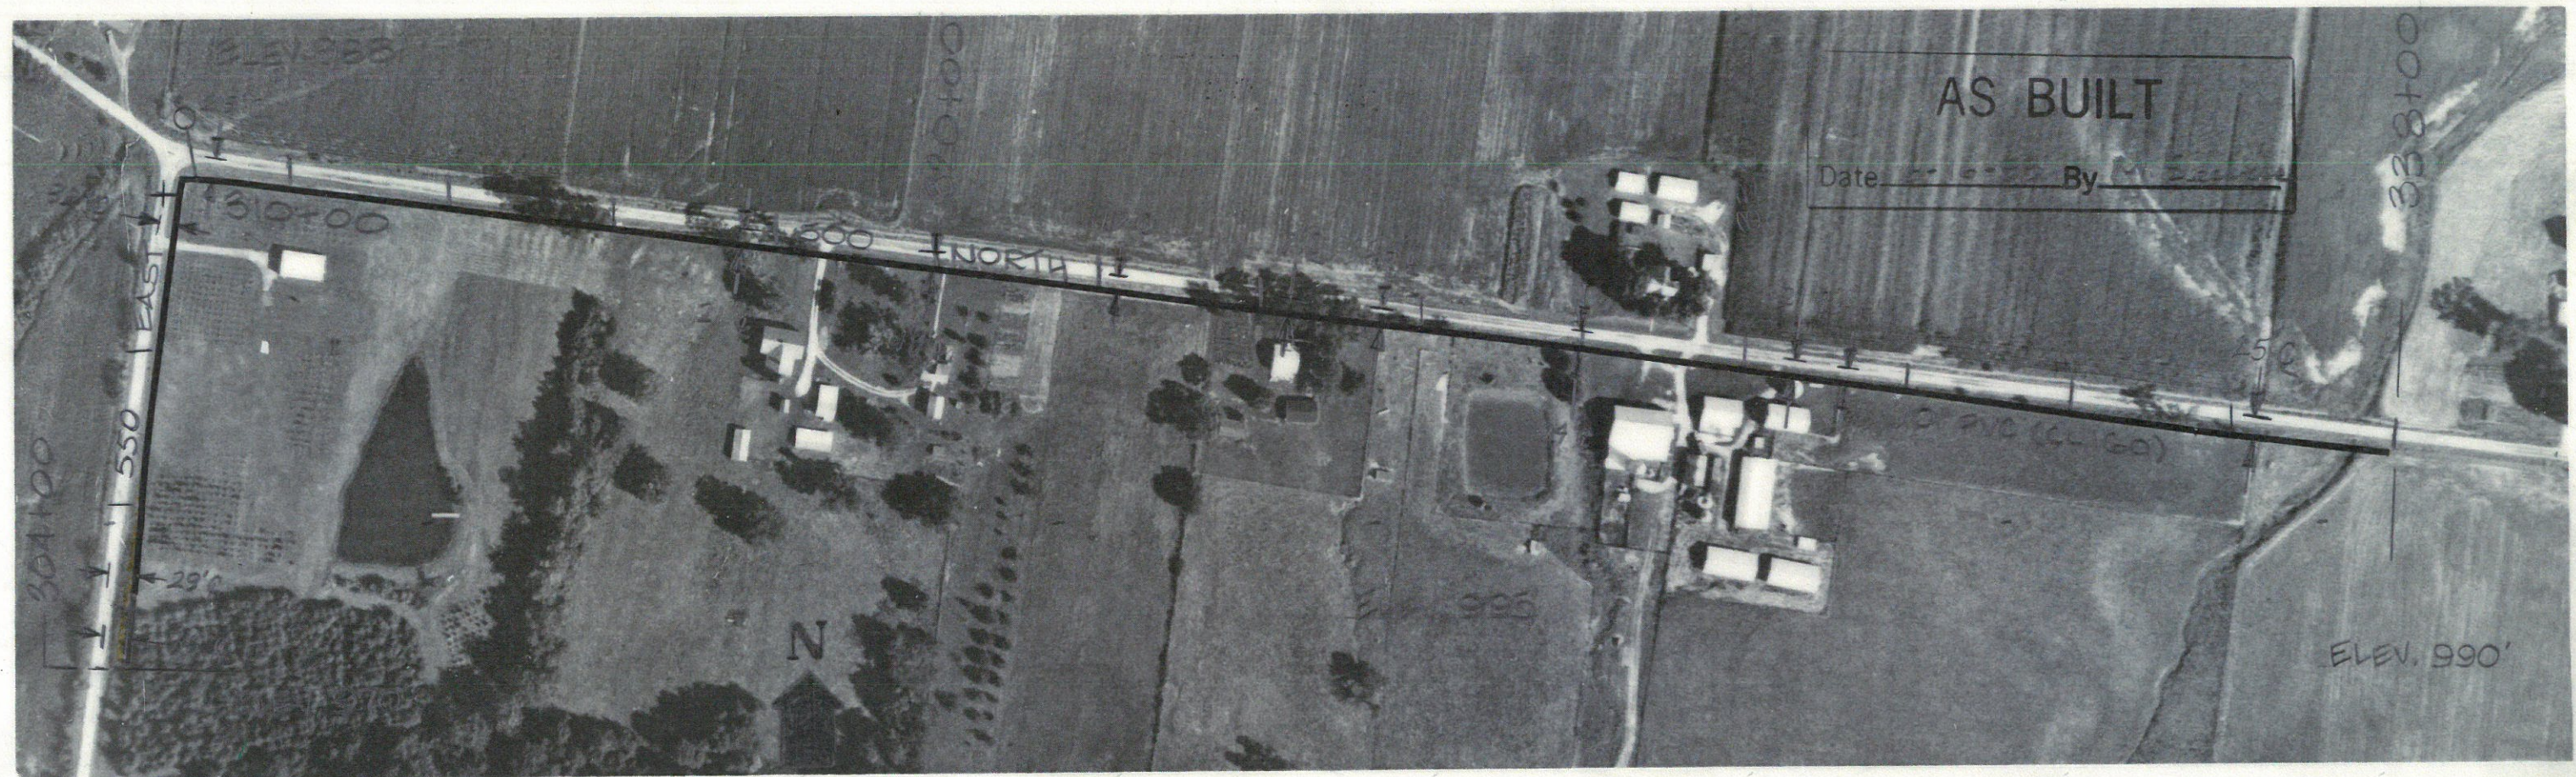

DRAWN BY	WDC	CHECKED BY	David H. H.	SIECO, INC. CONSULTING ENGINEERS, ARCHITECTS, PLANNERS	ELROD WATER CO, INC.	REVISED: C.O. A-1 DIVISION: LINE 1	JOB NO. 61140 SCALE: 1"=200'	SHT. 11 OF 89
DATE	7.18.79	DATE	1.8.80					
		CERTIFIED BY						
		DATE						