
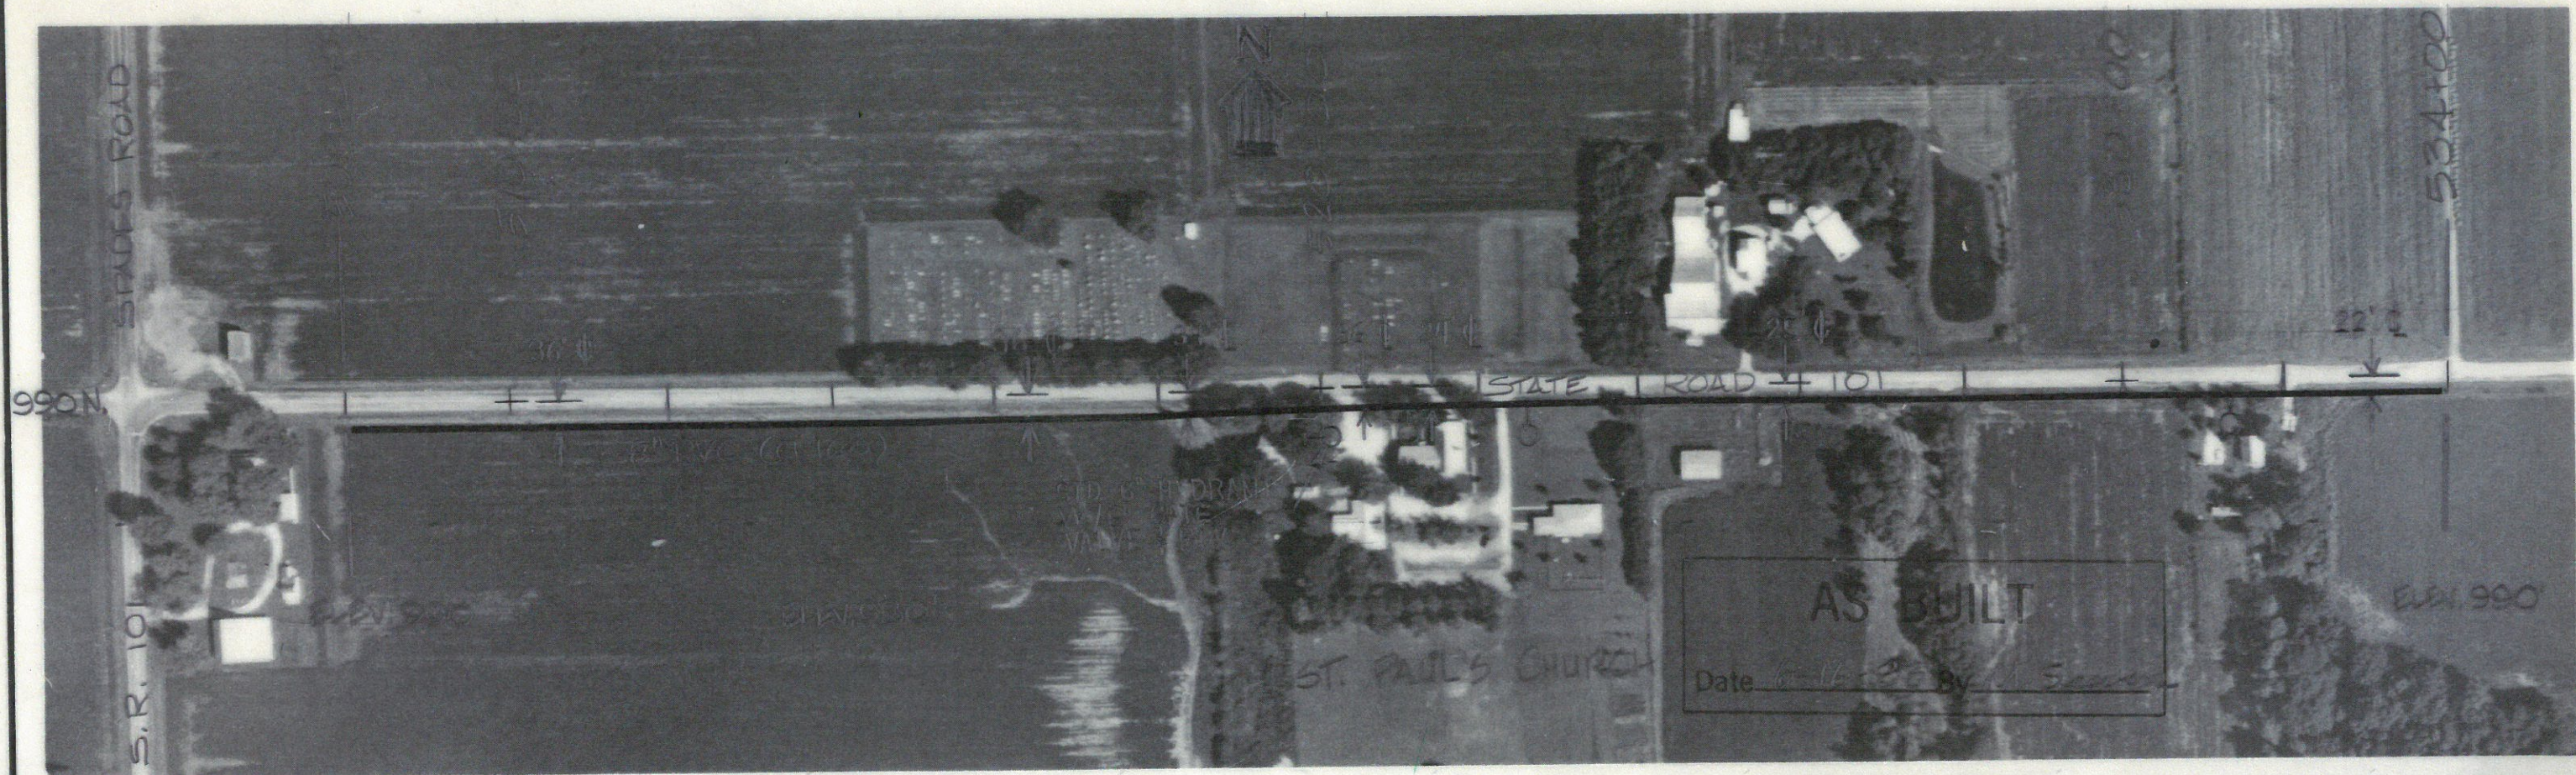


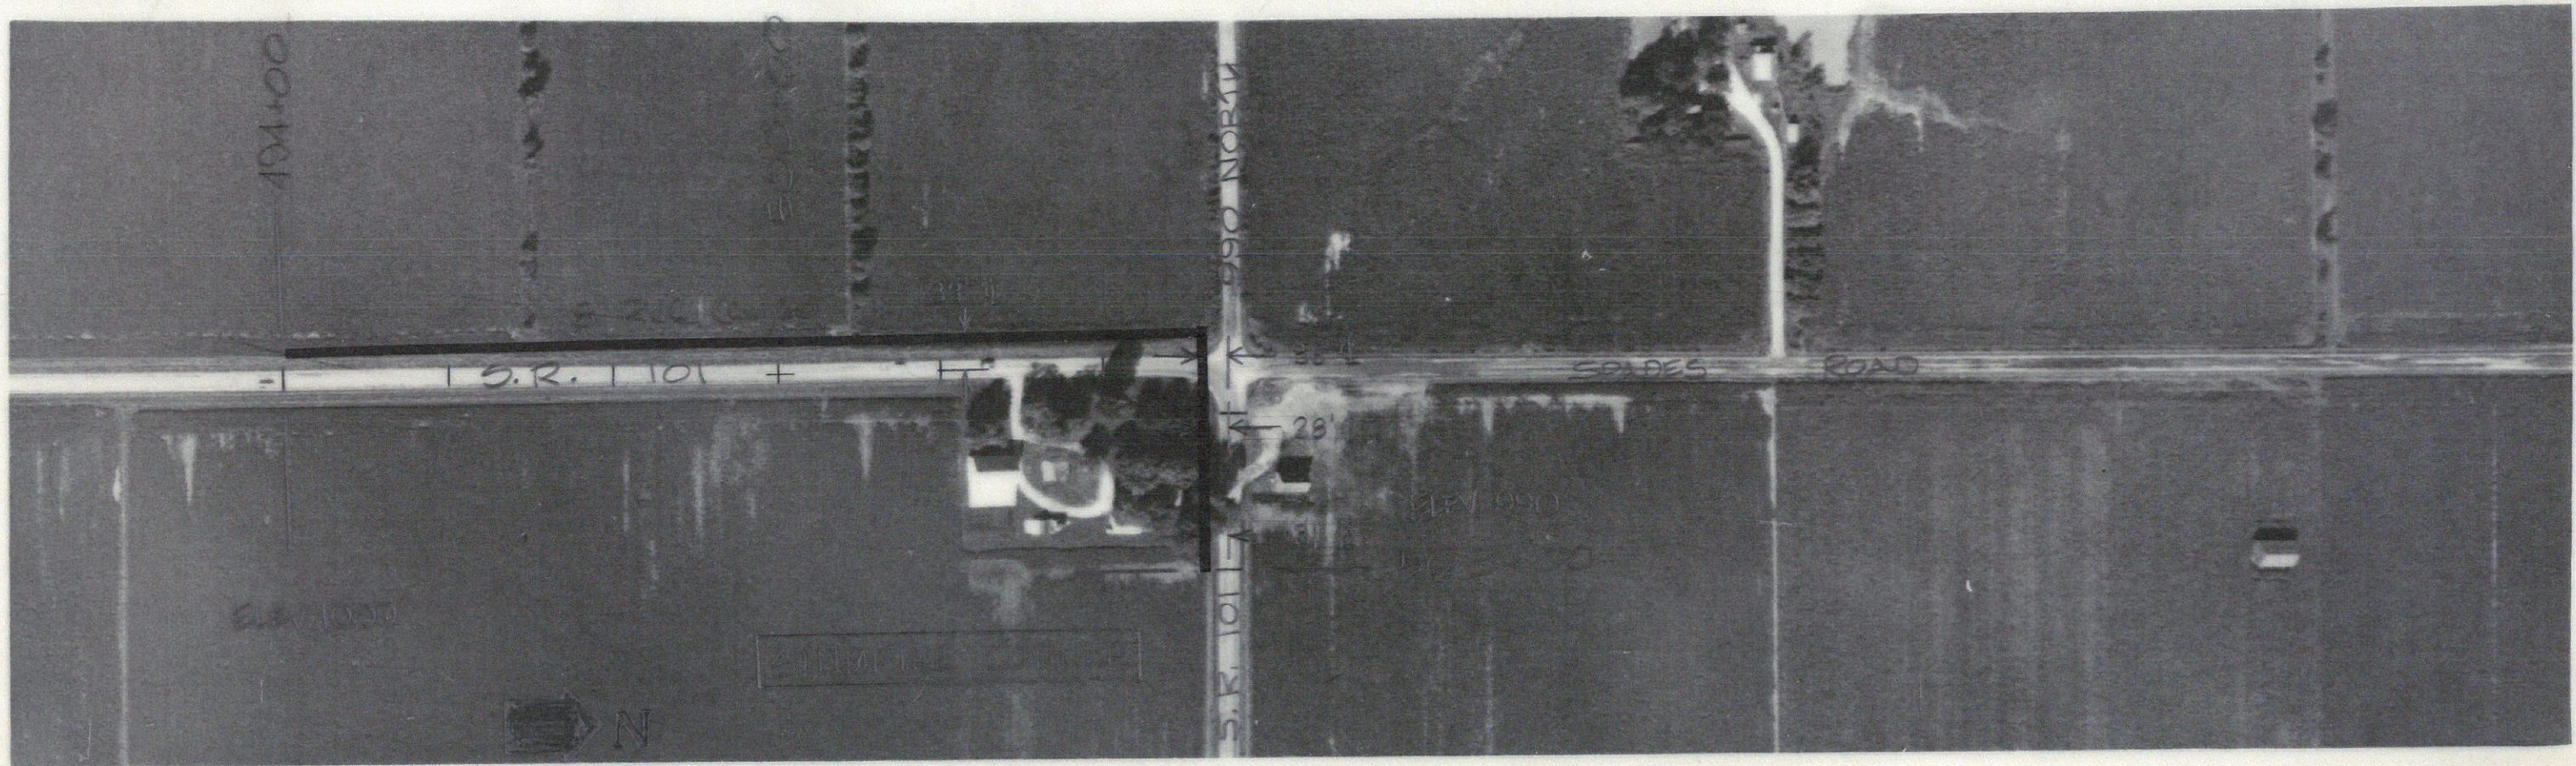

DRAWN BY	W.D.	CHECKED BY	D.W.	SIECO, INC. CONSULTING ENGINEERS, ARCHITECTS, PLANNERS	ELROD WATER CO, INC.	REVISED: C.O. A-1 DIVISION: LINE 1	JOB NO.	SHT.
DATE	7.20.79	DATE	1.8.80				61140	15
		CERTIFIED BY					SCALE:	OF
		DATE					1"=200'	89