
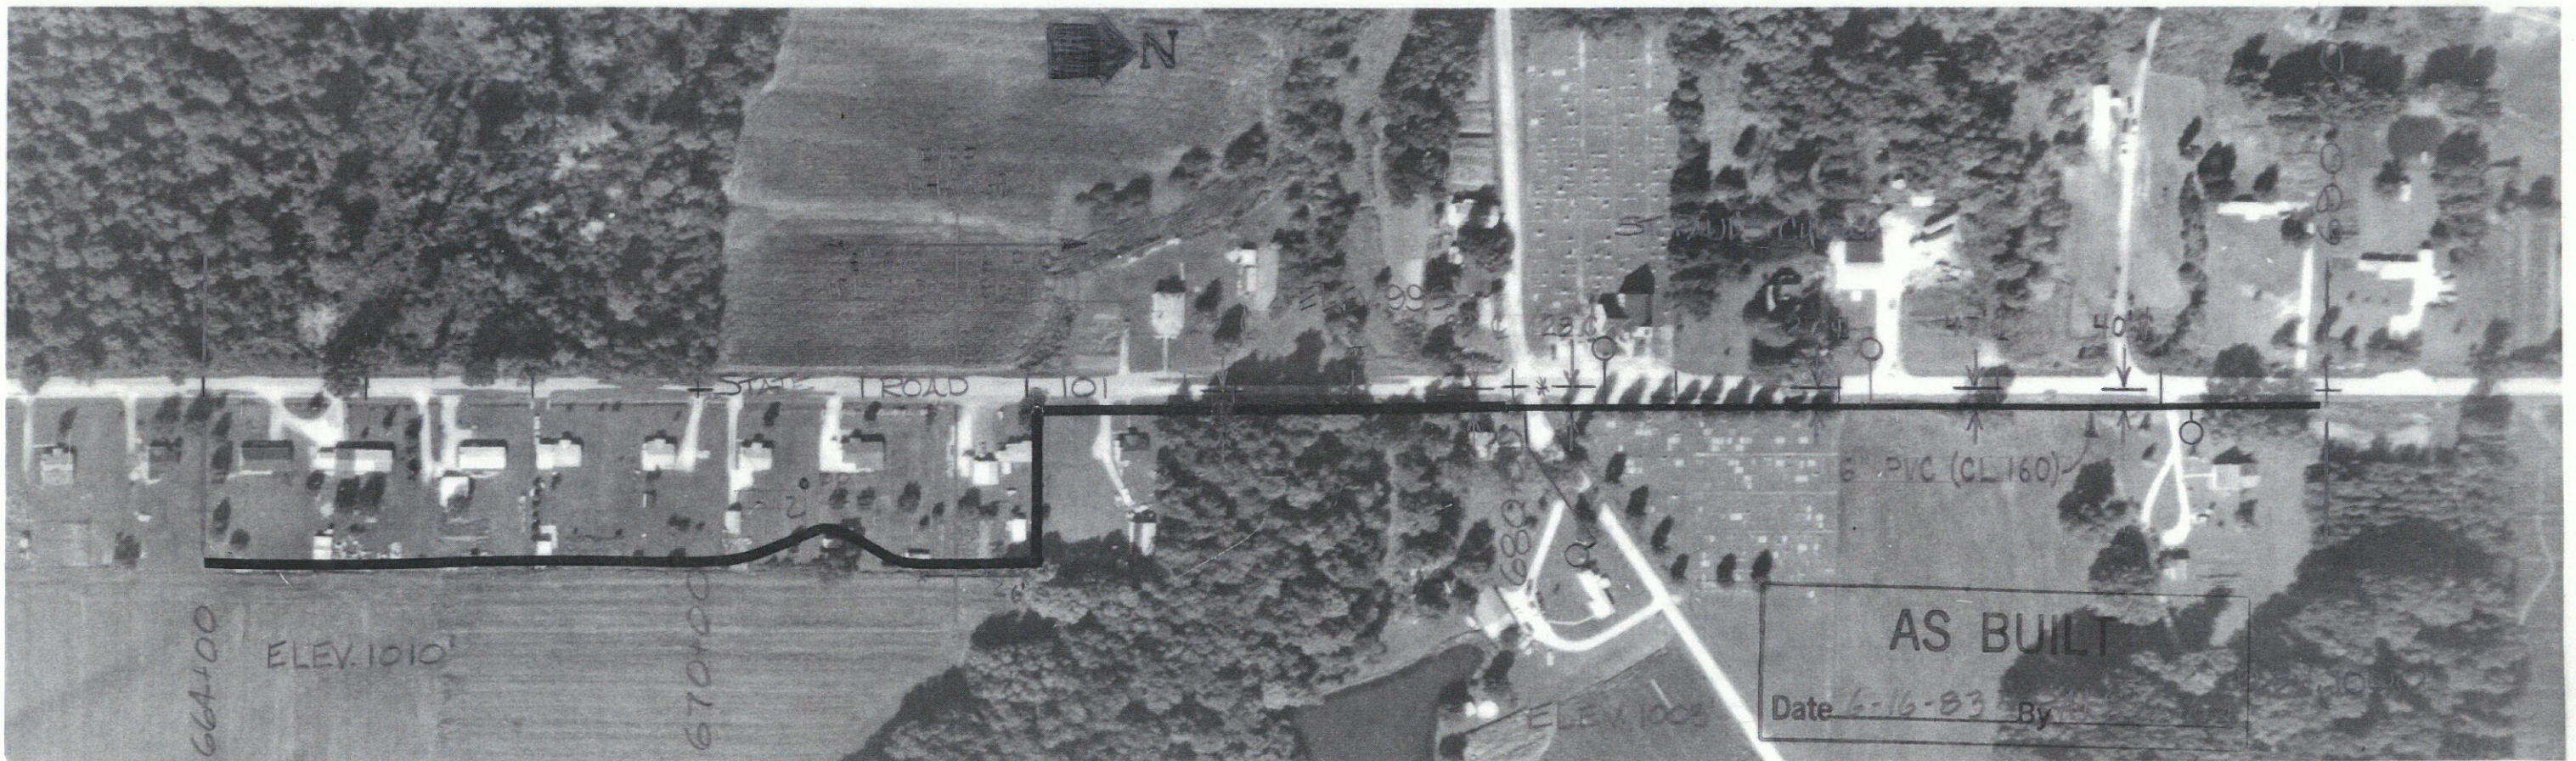


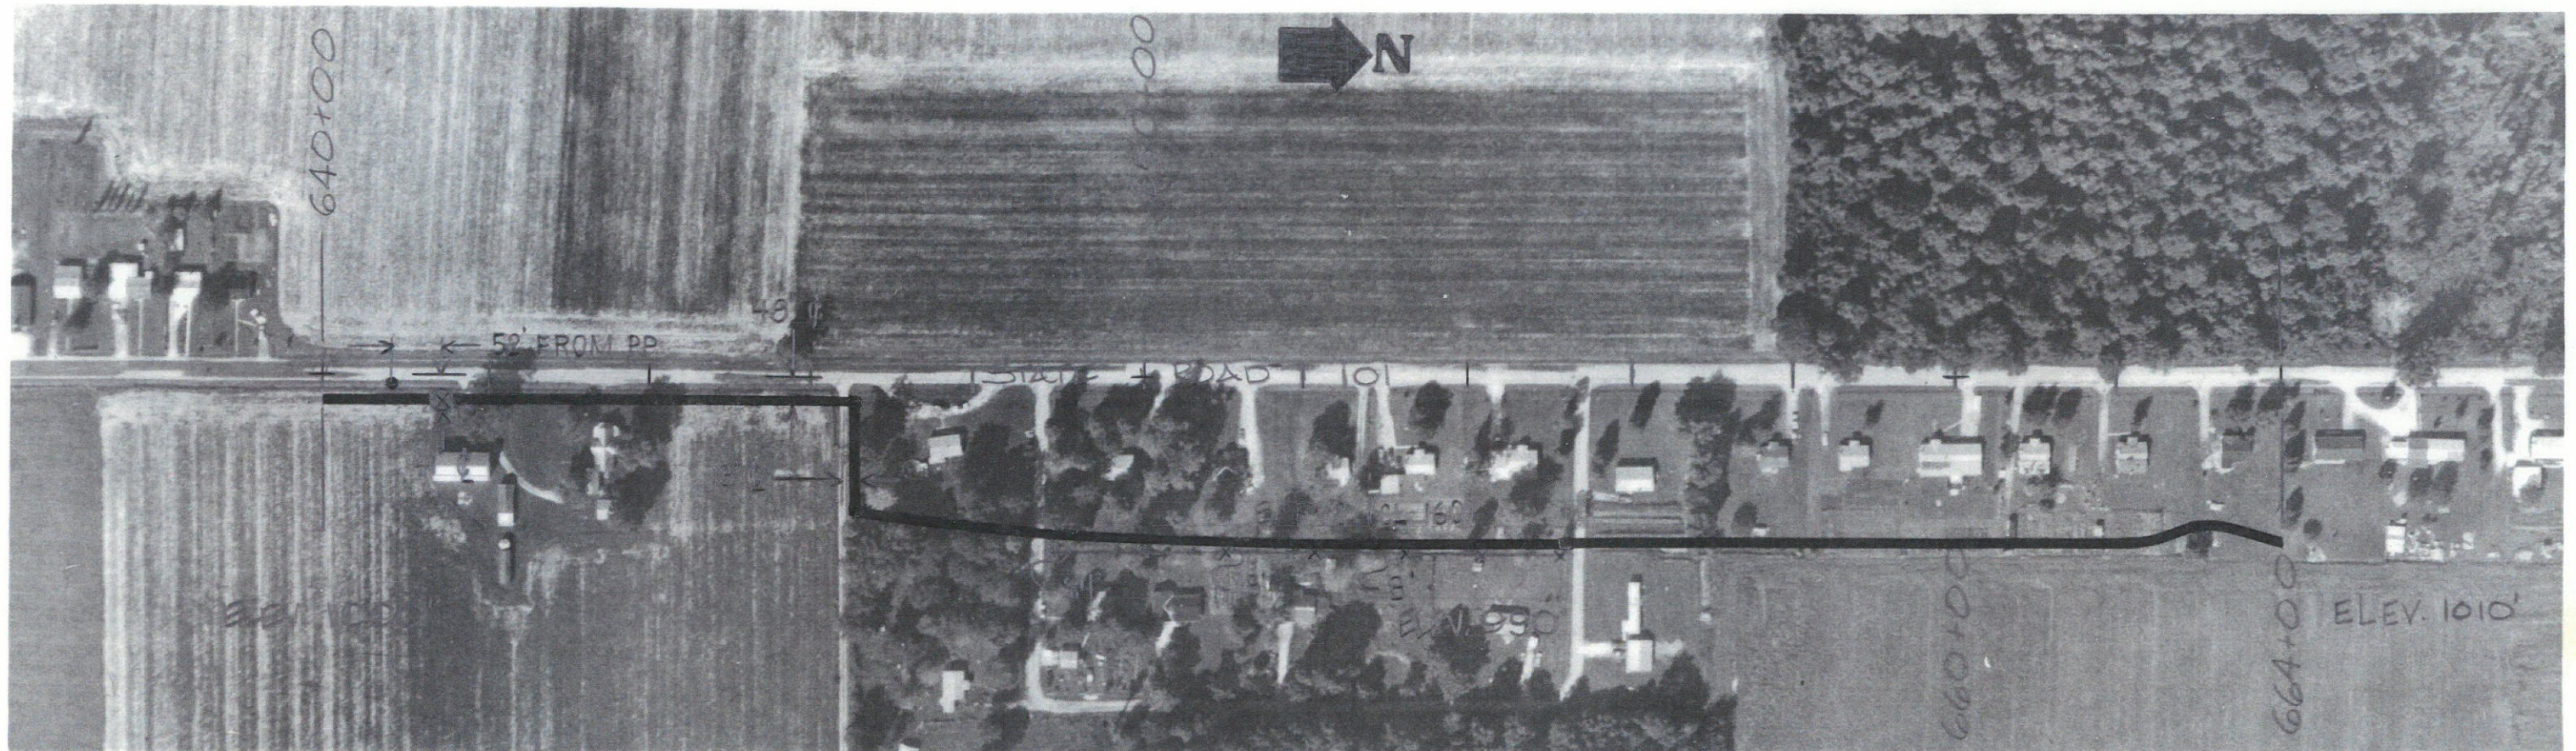

DRAWN BY	WDV	CHECKED BY	David H. H.	SIECO, INC. CONSULTING ENGINEERS, ARCHITECTS, PLANNERS	ELROD WATER CO, INC.	REVISED: C.O. A-1	DIVISION: LIVE 1	JOB NO. 61140	SHT. 18
DATE	7.23.79	DATE	1.31.80						
		CERTIFIED BY							
		DATE						SCALE 1"=200'	OF 89