
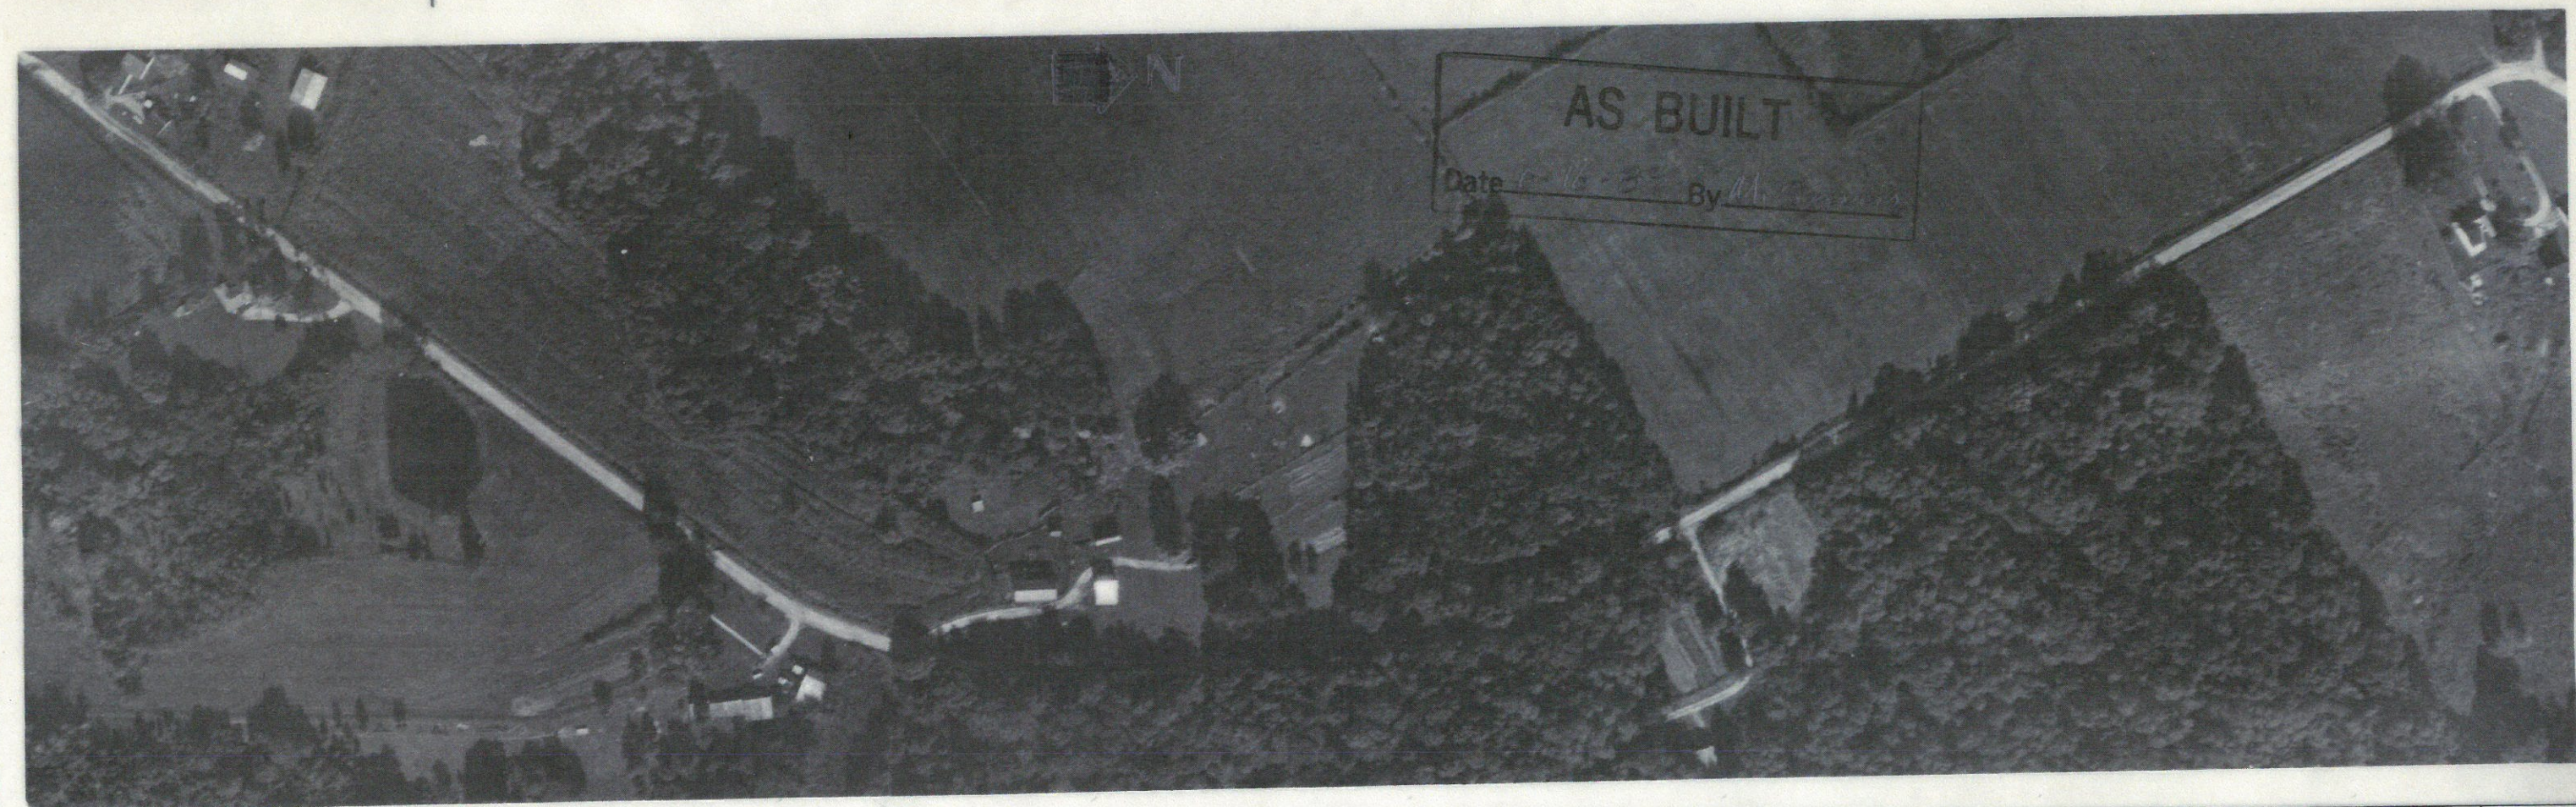


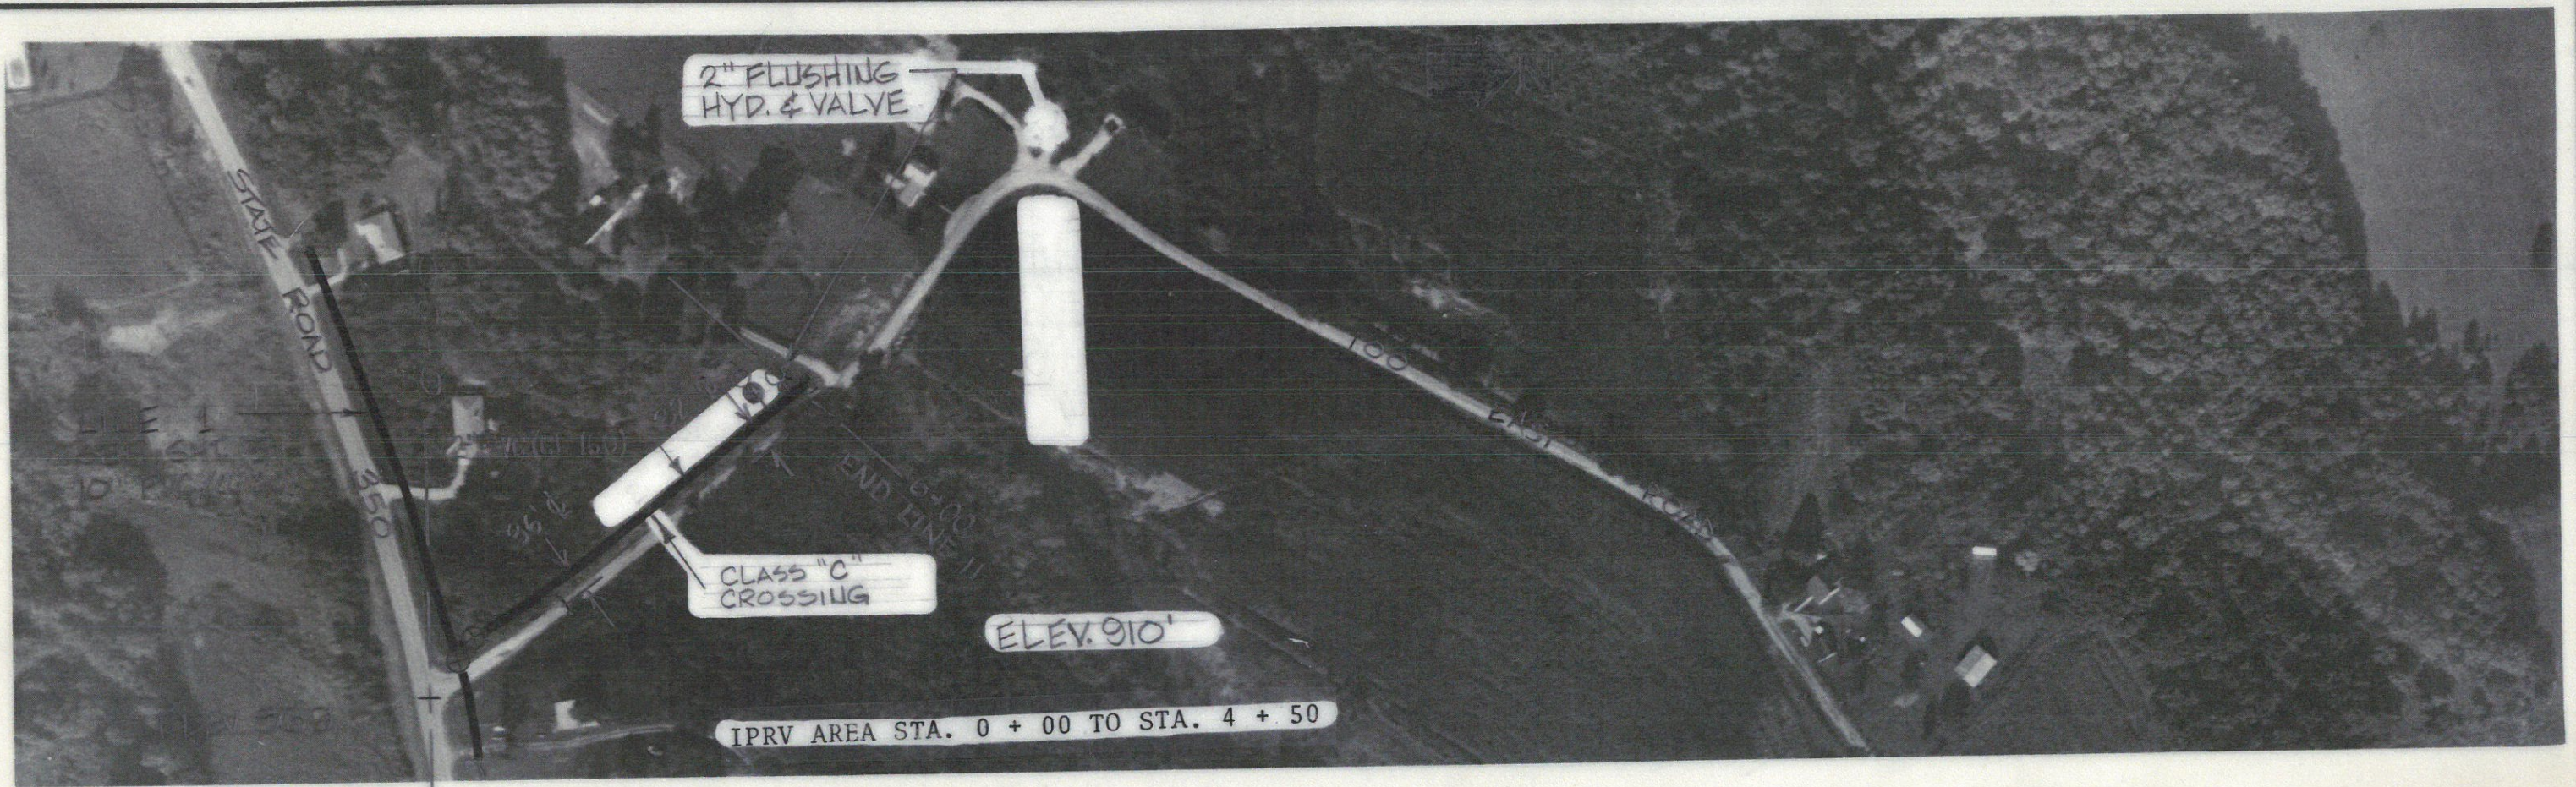

DRAWN BY	WDF	CHECKED BY	<i>[Signature]</i>	SIECO, INC. CONSULTING ENGINEERS, ARCHITECTS, PLANNERS	ELROD WATER CO, INC.	DIVISION: <u>LIVE II</u>	JOB NO <u>61140</u>	SHT. <u>20</u>
DATE	7-23-79	DATE	1-21-80				SCALE 1"=200'	OF <u>89</u>
		CERTIFIED BY						
		DATE						