
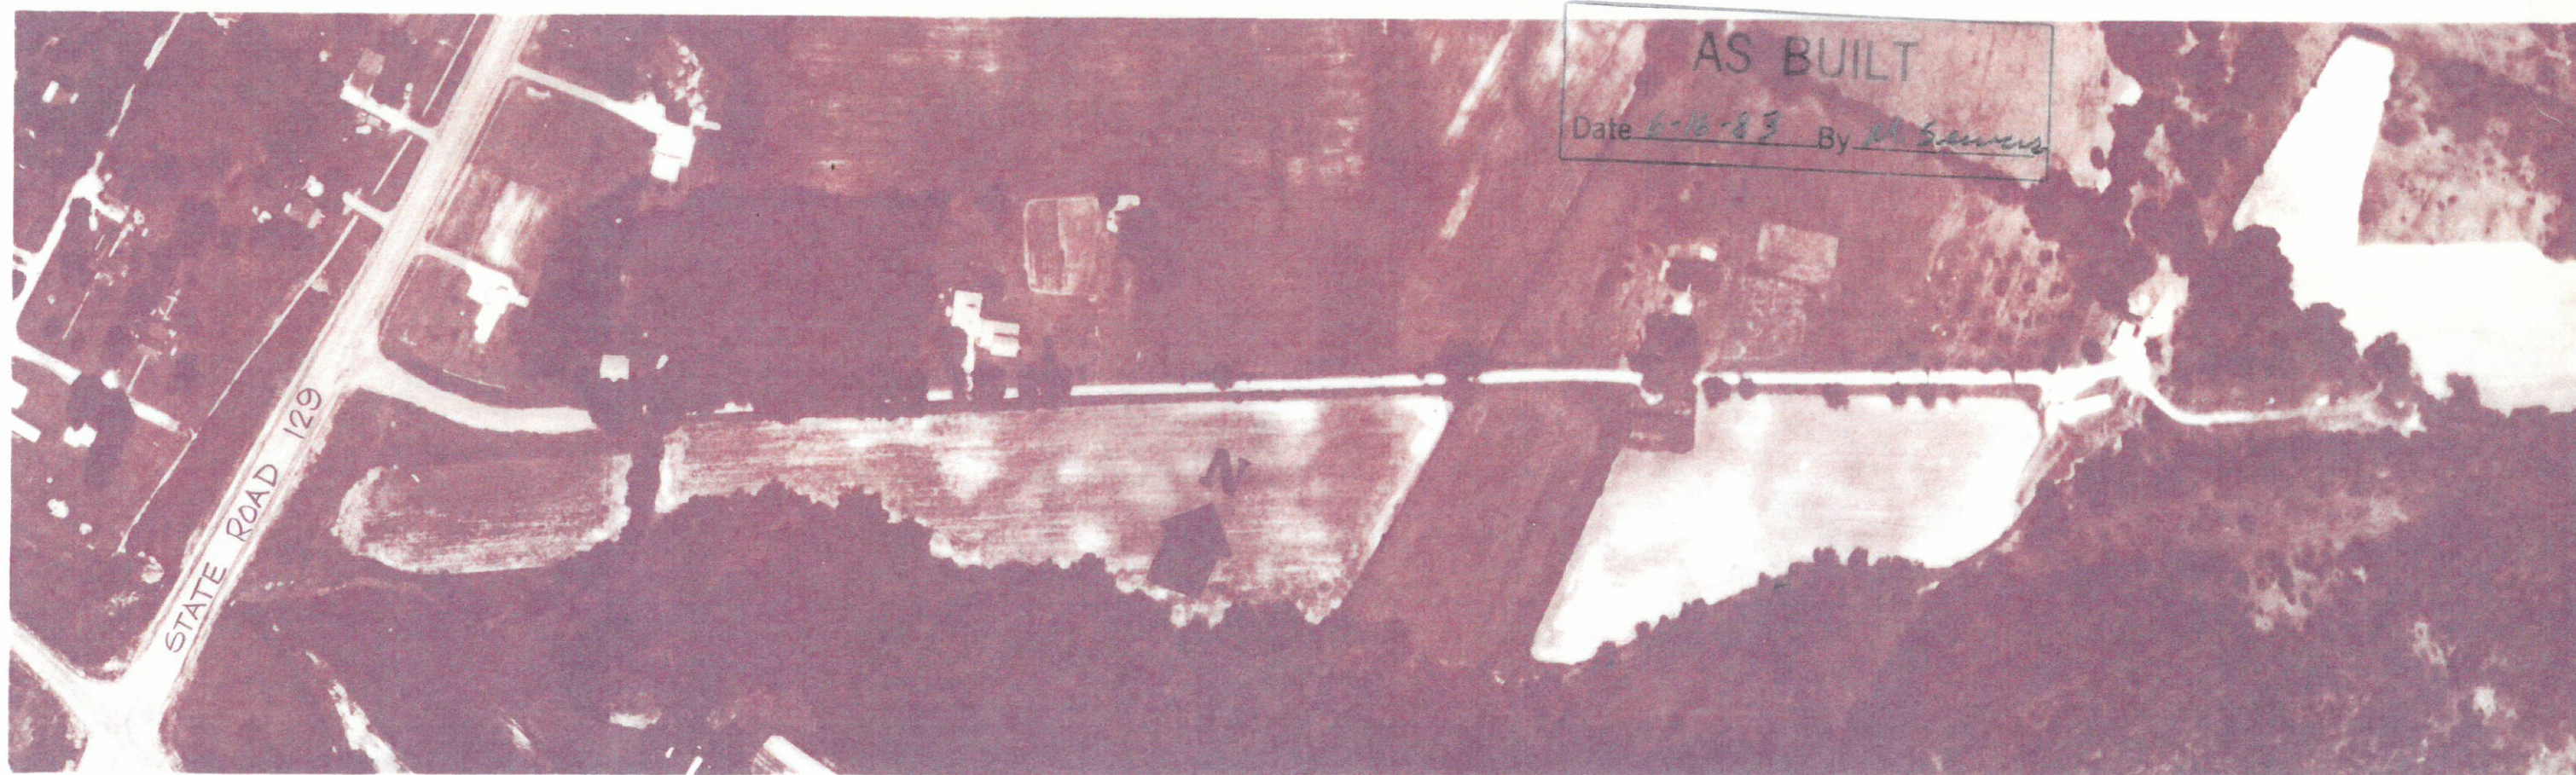


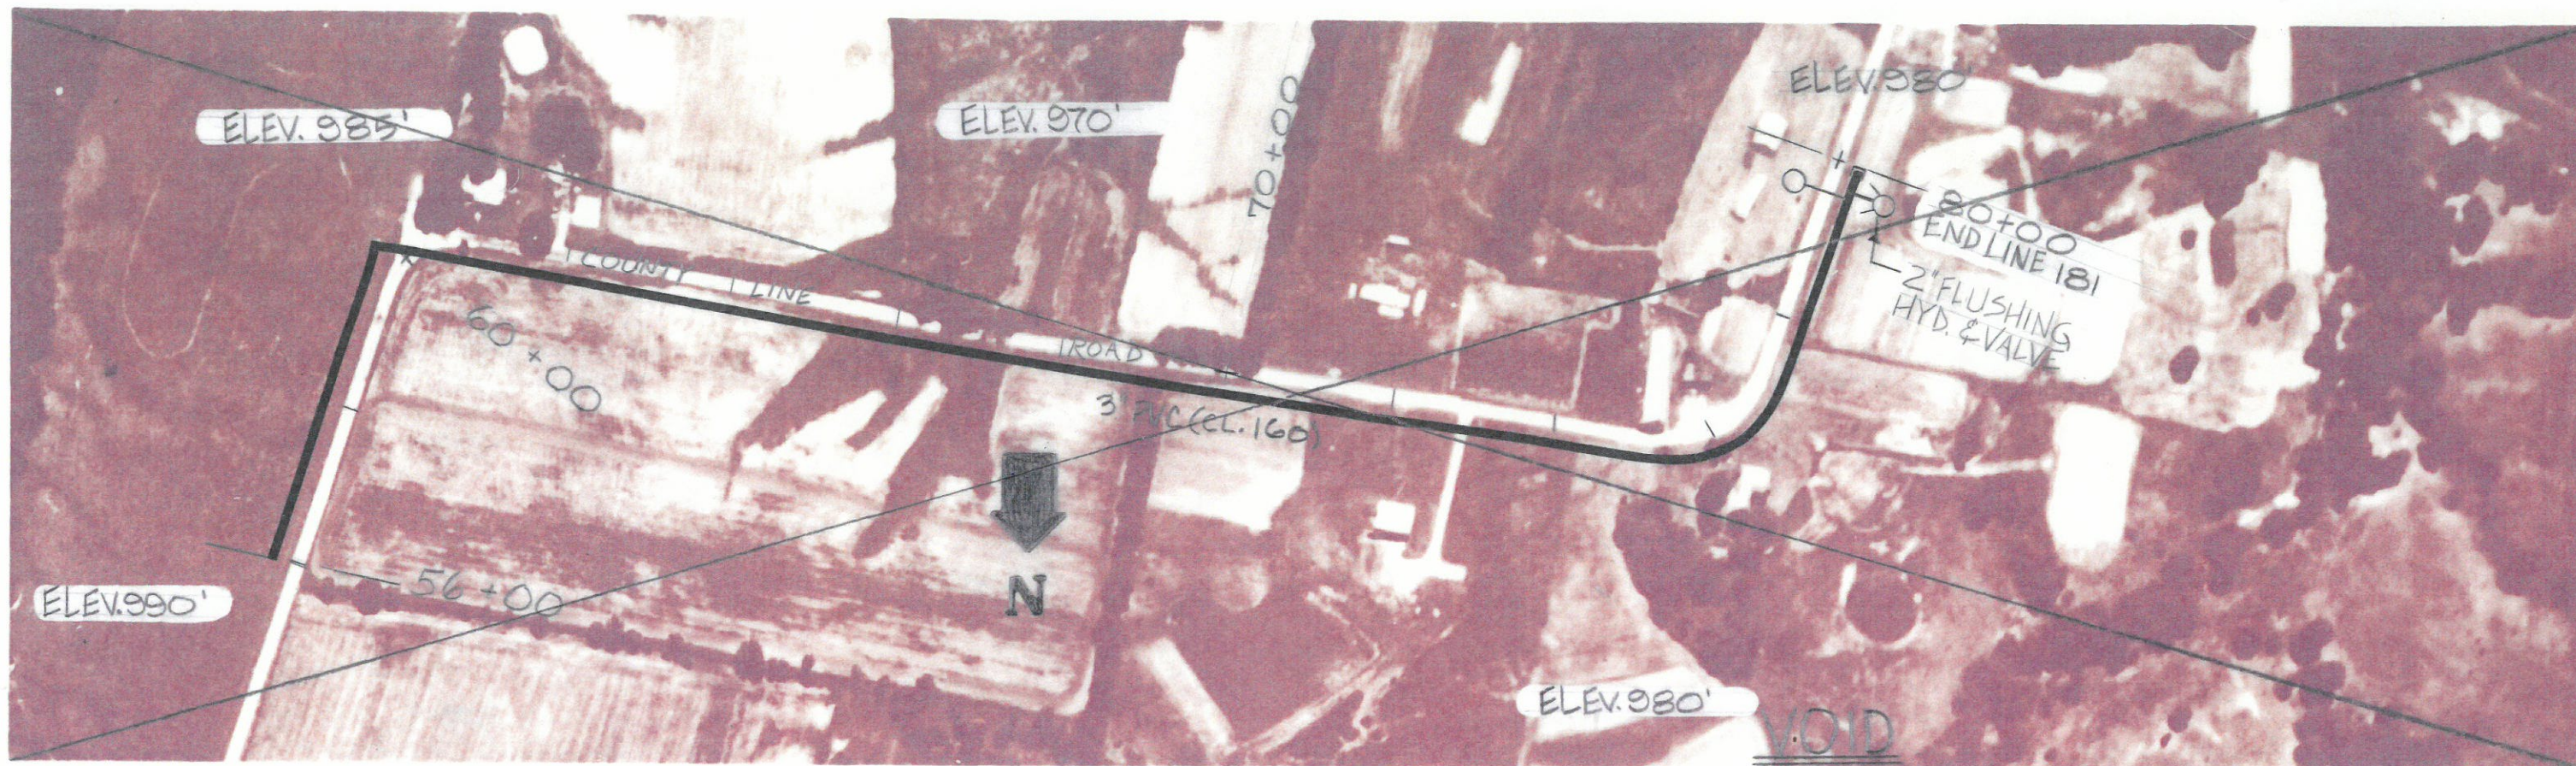

DRAWN BY	WDJ	CHECKED BY	David Ott
DATE	8-2-79	DATE	1-31-80
		CERTIFIED BY	
		DATE	

SIECO, INC.
CONSULTING ENGINEERS,
ARCHITECTS, PLANNERS

ELROD WATER CO, INC.

DIVISION: LINE 181

JOB NO.	61140	SHT	39
SCALE:	1"=200'	OF	89