
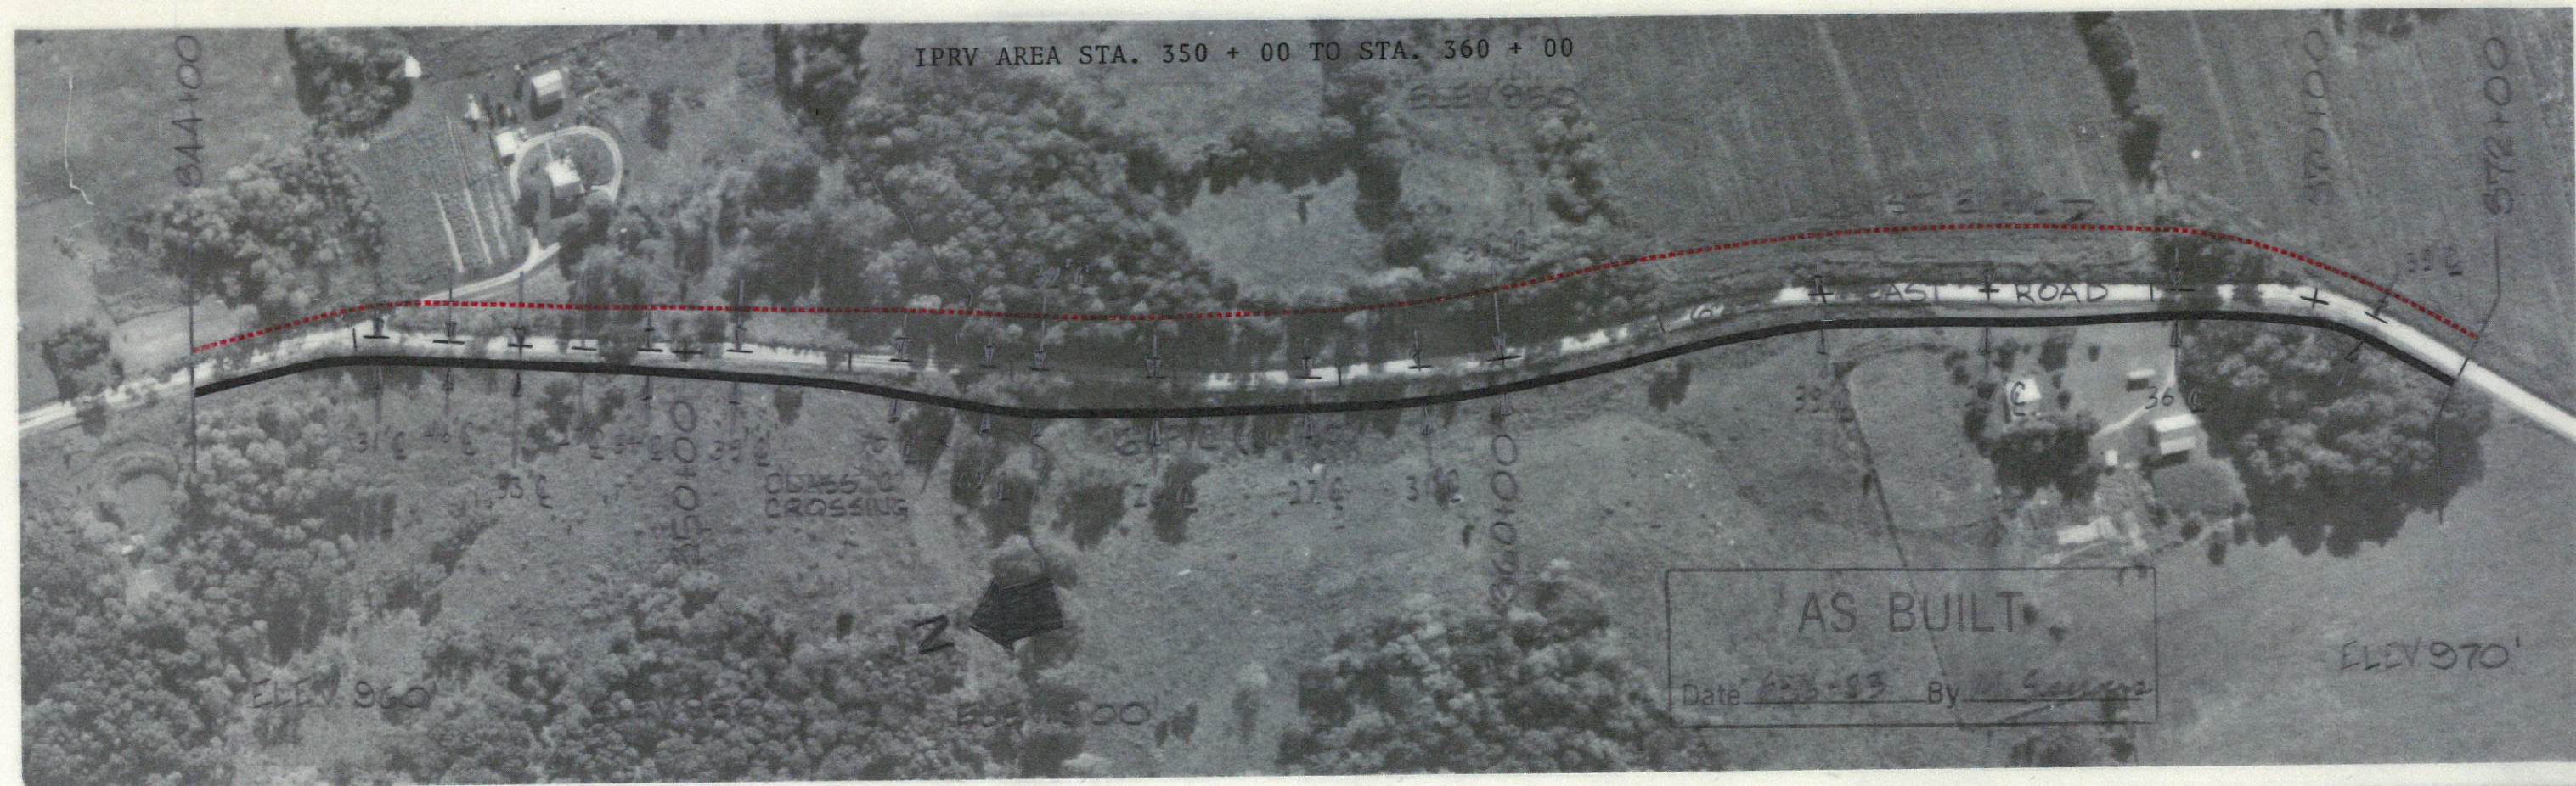


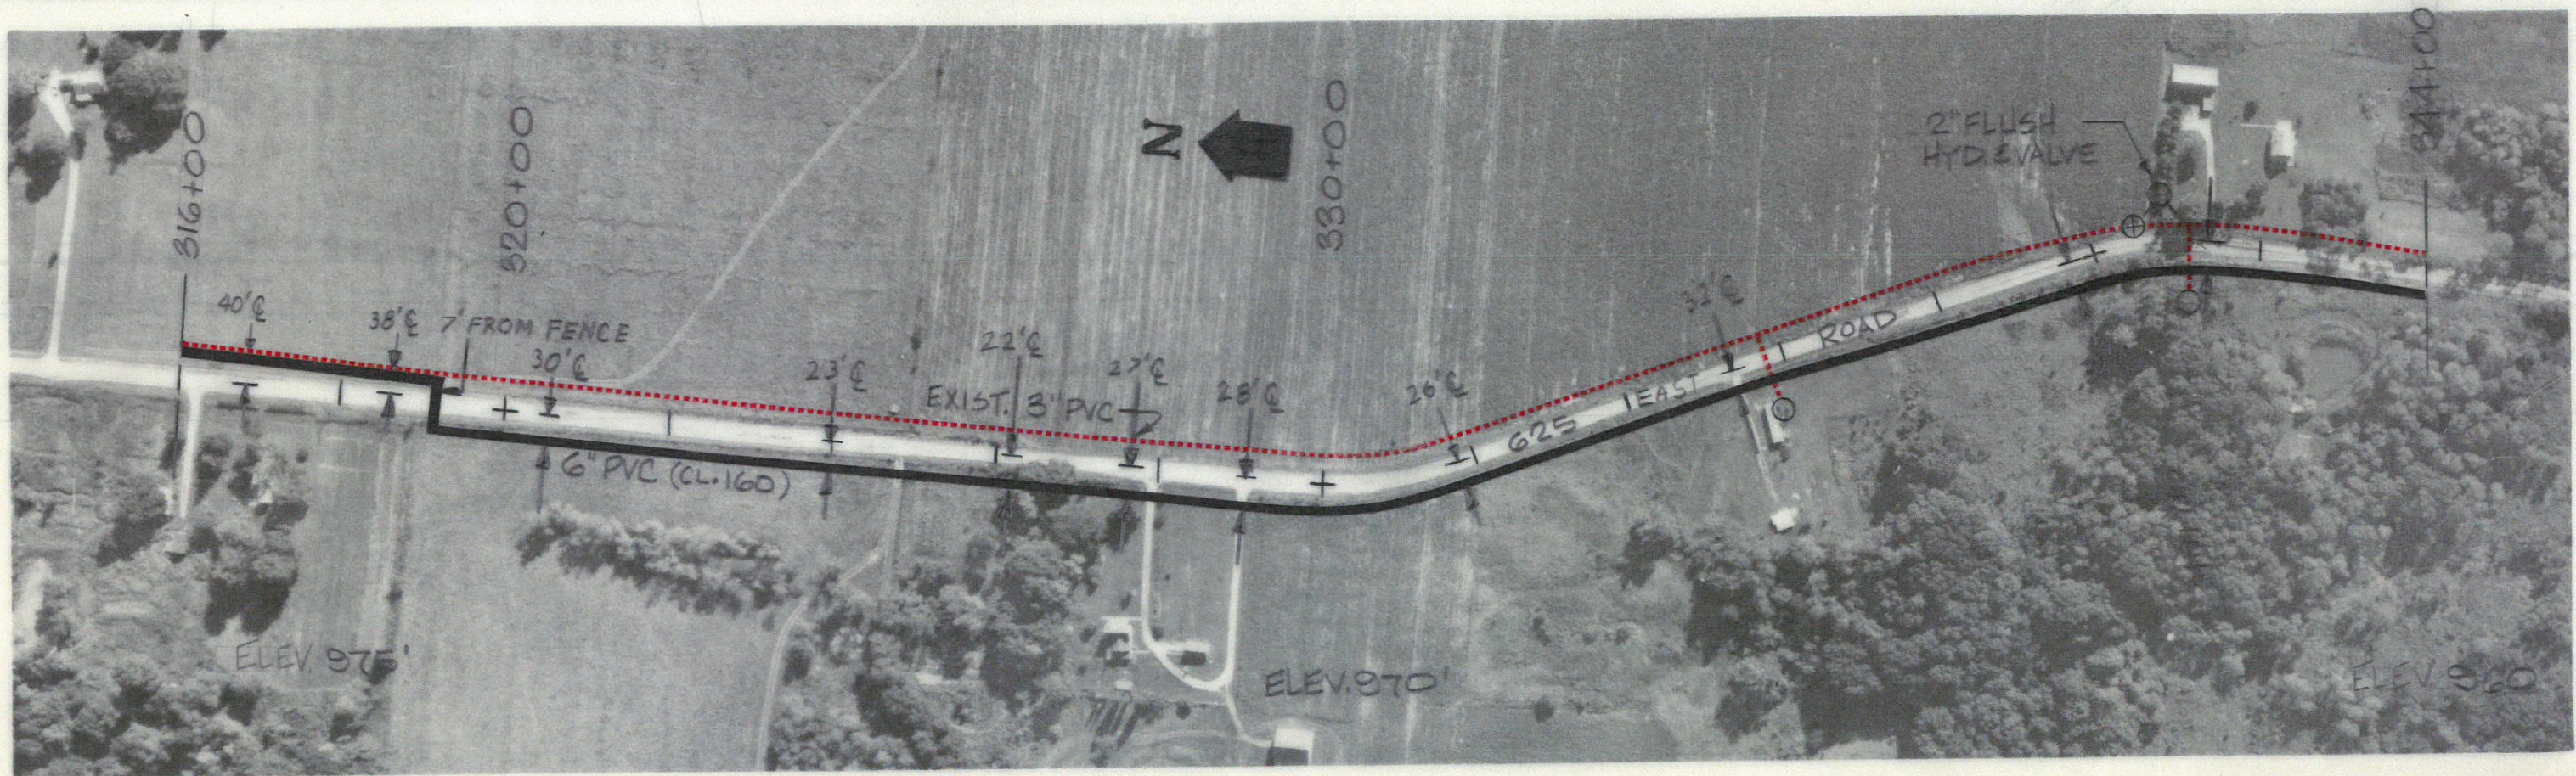

DRAWN BY DATE	WDJ 8-6-78	CHECKED BY DATE CERTIFIED BY DATE	SIECO, INC. CONSULTING ENGINEERS, ARCHITECTS, PLANNERS ELROD WATER CO, INC.	DIVISION: LINE 2	JOB NO. 61140 SCALE: 1"=200' SHT. 48 OF 89
------------------	---------------	--	--	------------------	---