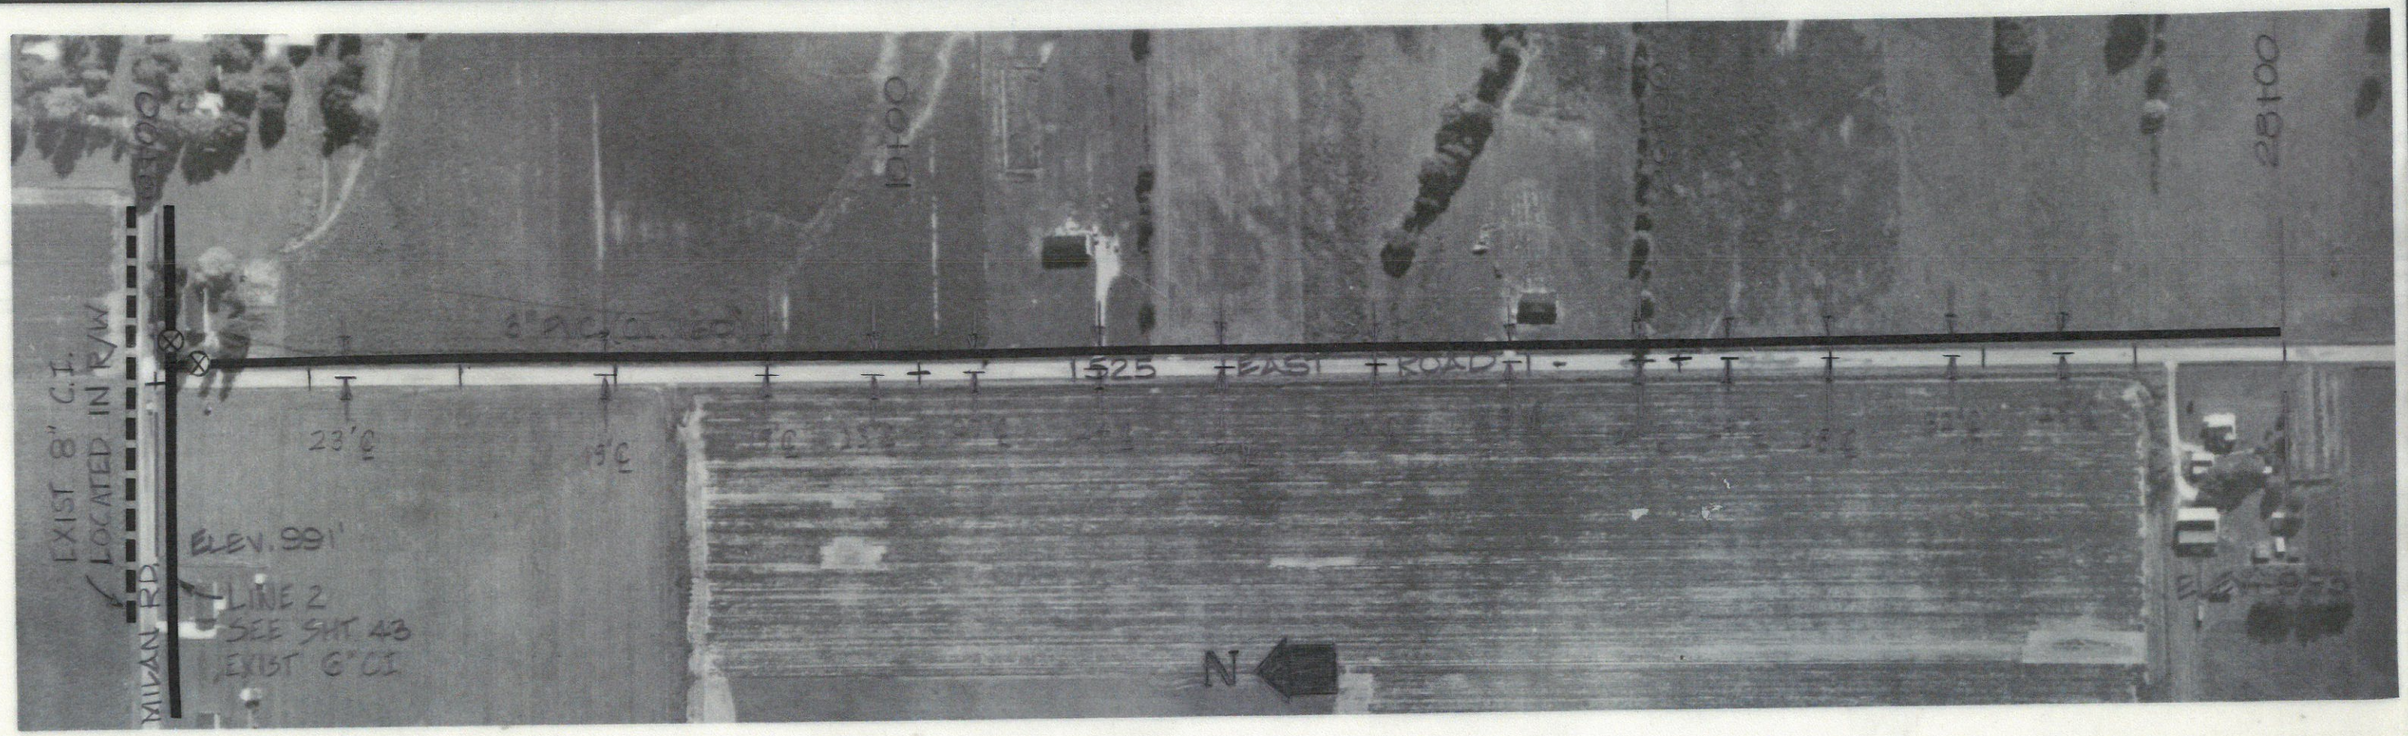

DRAWN BY	WDd	CHECKED BY		SIECO, INC. CONSULTING ENGINEERS, ARCHITECTS, PLANNERS	ELROD WATER CO, INC.	REVISED: C.O. A-1	JOB No. 61140 / SHT. 56
DATE	8-13-78	DATE	1-21-80			DIVISION: LINE 23	SCALE: 1"=200' / OF 89
		CERTIFIED BY					
		DATE					