
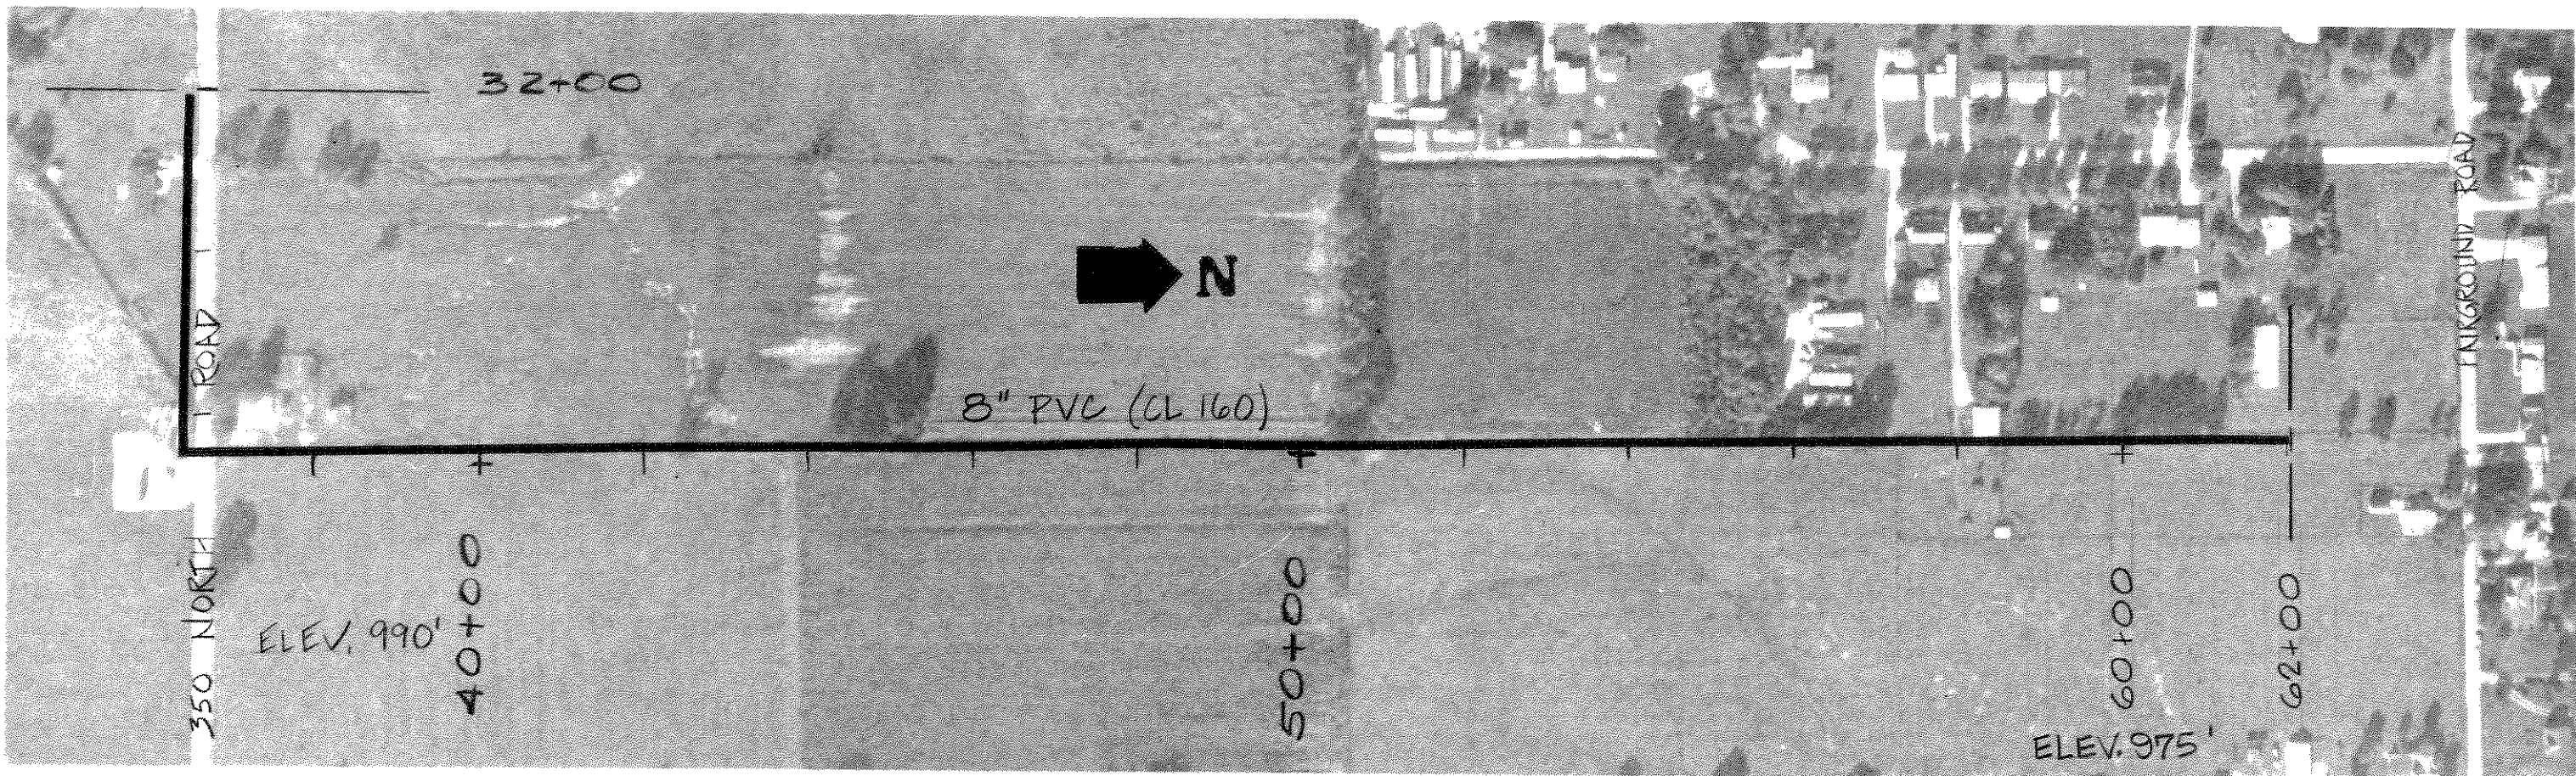


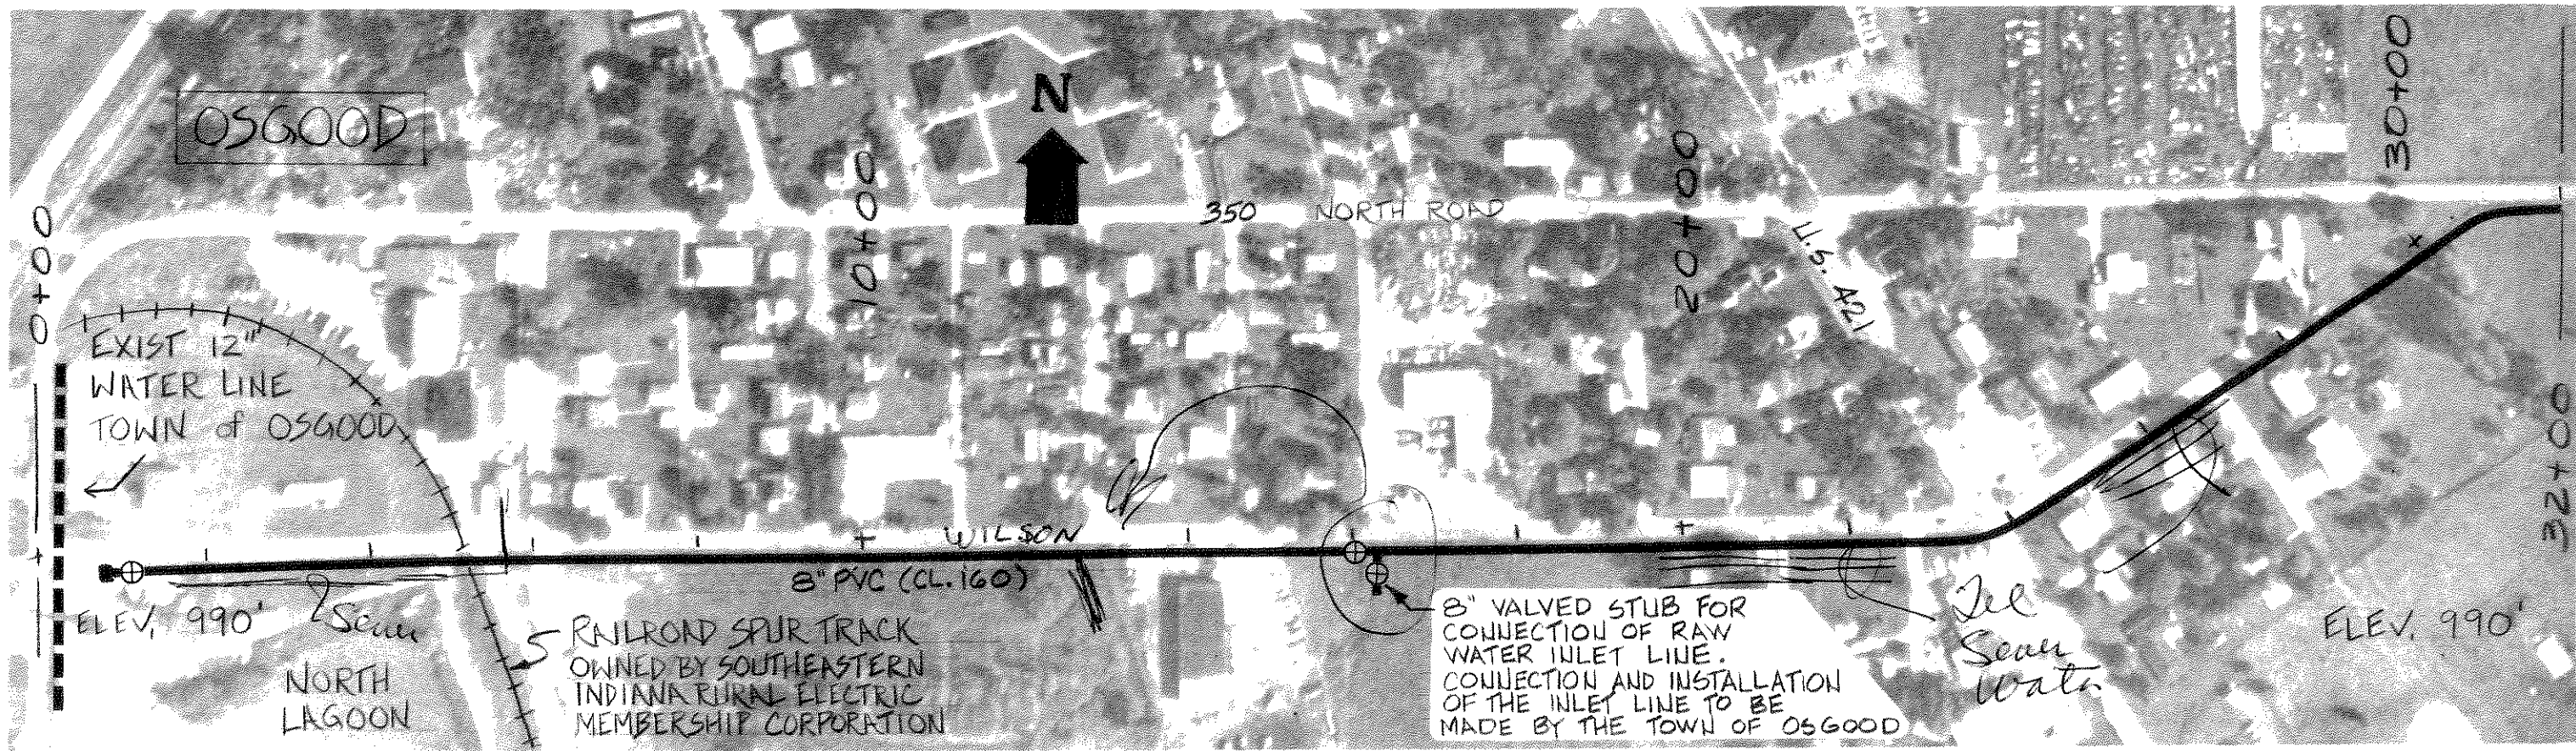

DRAWN BY		CHECKED BY		SIECO, INC. CONSULTING ENGINEERS, ARCHITECTS, PLANNERS	ELROD WATER CO, INC.	DIVISION RAW WATER LINE -3	JOB NO. 61140	SHT 57
DATE		DATE					SCALE 1"=200'	OF
		CERTIFIED BY						