


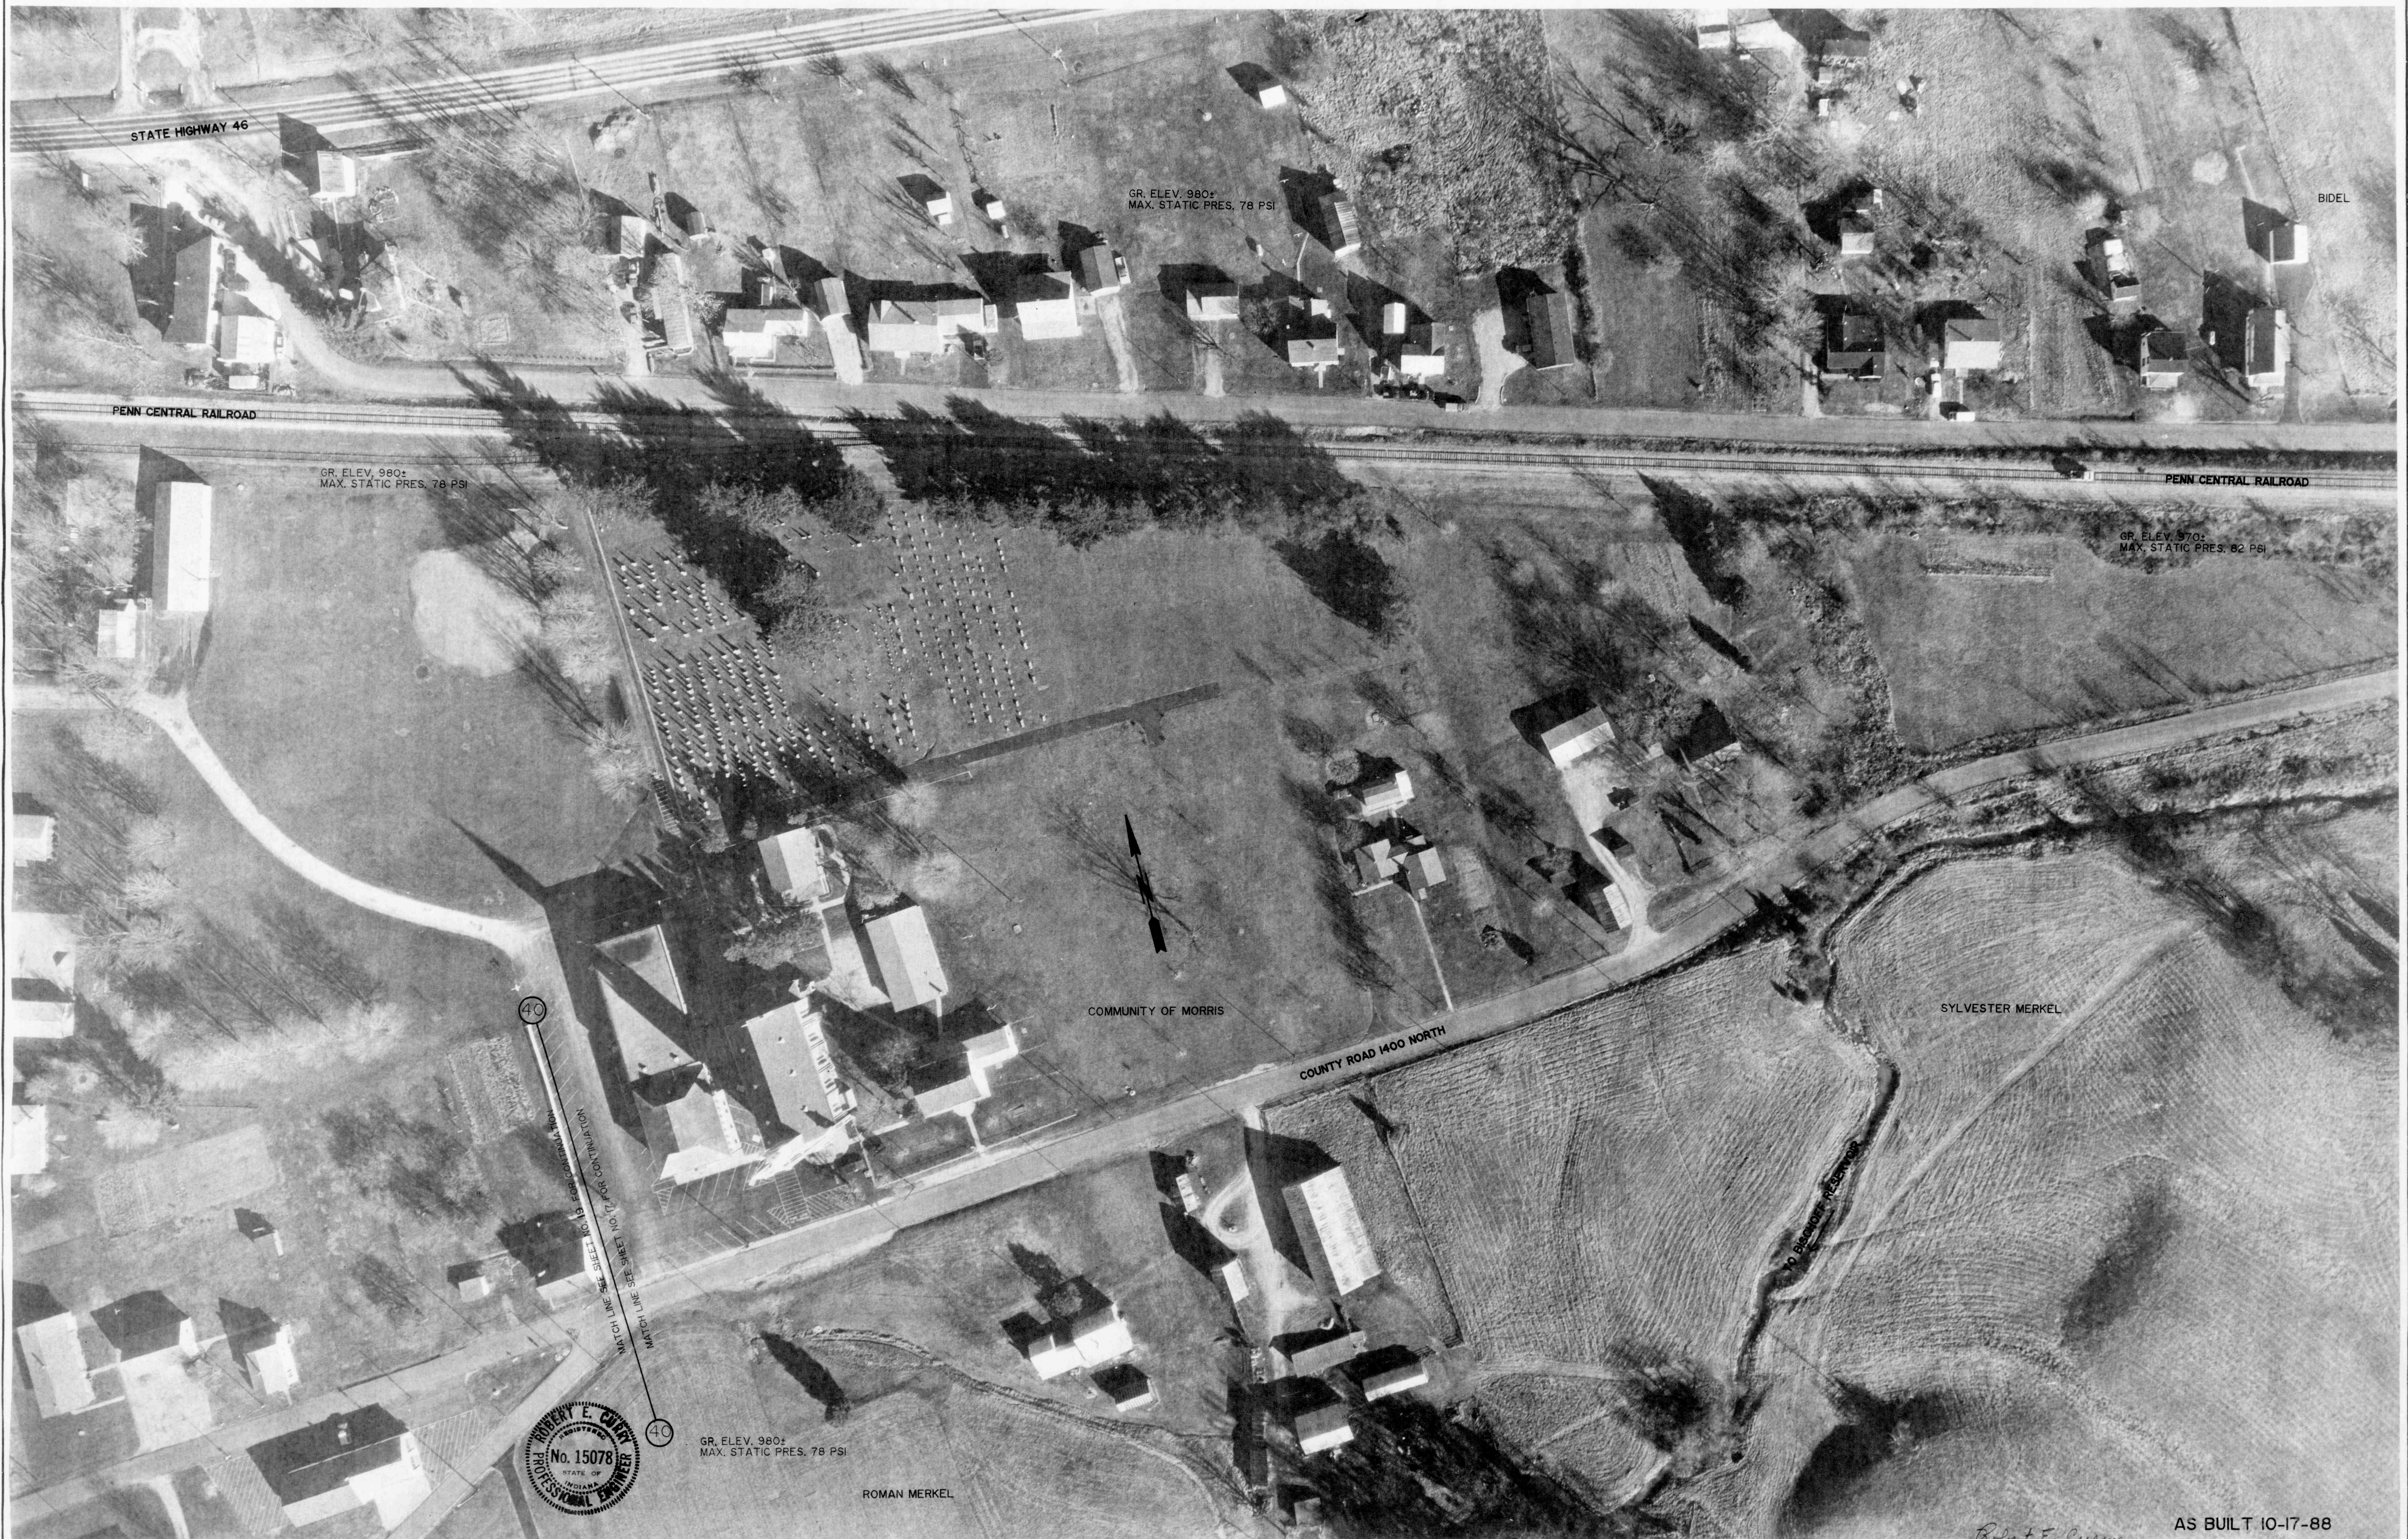

REVISIONS	DRAWN BY		ROBERT E. CURRY & ASSOCIATES, INC. CONSULTING ENGINEERS 3346 AVON ROAD PLAINFIELD, INDIANA 46168	ELROD WATER COMPANY, INC. RIPLEY COUNTY, INDIANA	WATER MAIN EXTENSIONS TO COMMUNITIES OF CLINTON, SPADES & MORRIS	JOB NO.	SHT. 18
	DATE					SCALE 1" = 50'	OF 24
	CERTIFIED BY	REC					
	DATE	4/15/87					