


GR. ELEV. 1005 ±
MAX. STATIC PRES. 67 PSI

COUNTY ROAD 1100 NORTH

GR. ELEV. 990 ±
MAX. STATIC PRES. 73 PSI


GR. ELEV. 1000 ±
MAX. STATIC PRES. 69 PSI

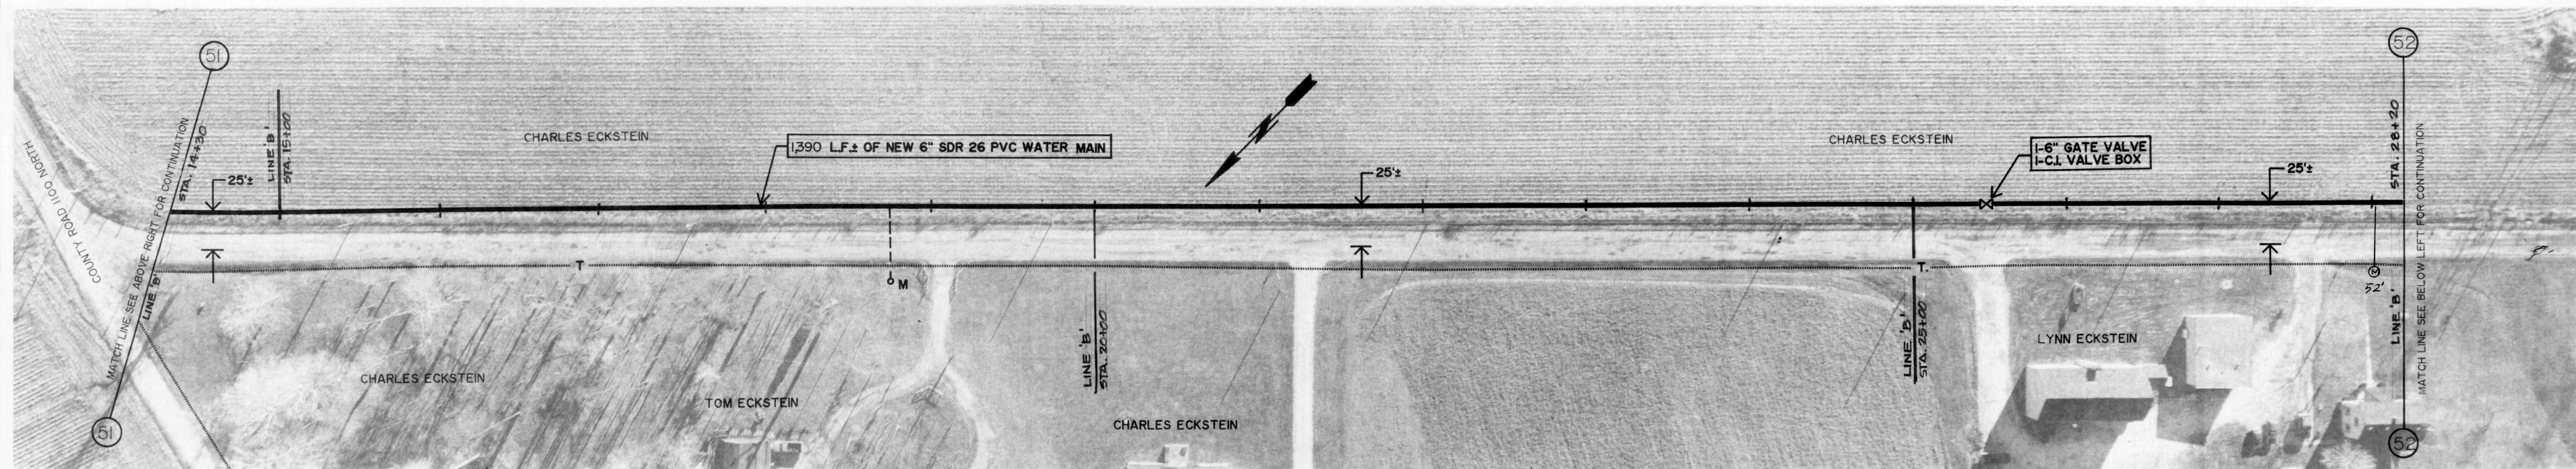

GR. ELEV. 1000 ±
MAX. STATIC PRES. 69 PSI

COUNTY ROAD 650 EAST
ST. NICHOLAS RD.

GR. ELEV. 990 ±
MAX. STATIC PRES. 73 PSI

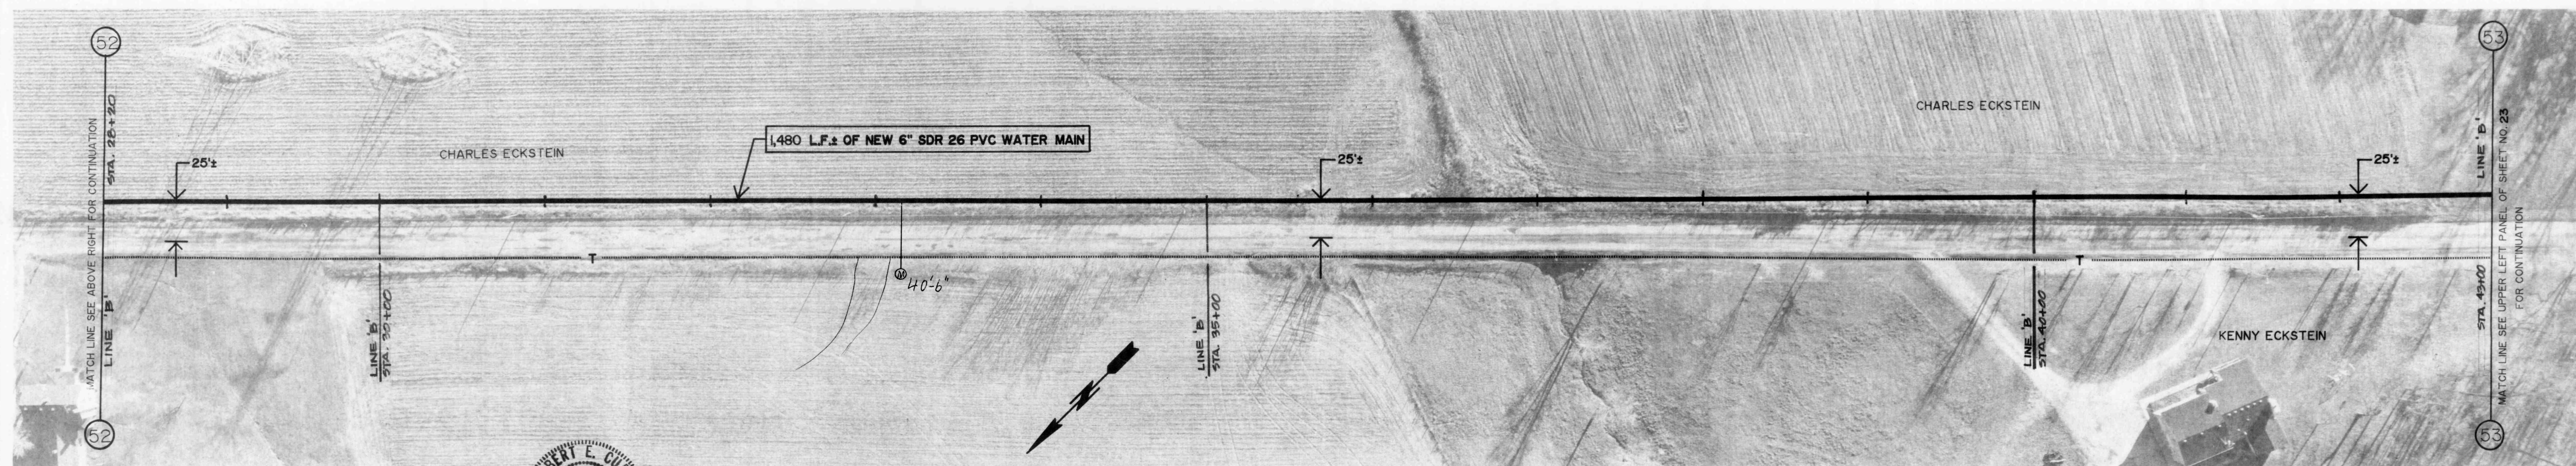

GR. ELEV. 993 ±
MAX. STATIC PRES. 72 PSI

COUNTY ROAD 650 EAST
ST. NICHOLAS RD.

GR. ELEV. 980 ±
MAX. STATIC PRES. 78 PSI

GR. ELEV. 980 ±
MAX. STATIC PRES. 78 PSI



AS BUILT 10-17-88

REVISIONS	DRAWN BY	ROBERT E. CURRY & ASSOCIATES, INC. CONSULTING ENGINEERS 3346 AVON ROAD PLAINFIELD, INDIANA 46168	ELROD WATER COMPANY, INC. RIPLEY COUNTY, INDIANA	WATER MAIN EXTENSIONS TO COMMUNITIES OF CLINTON, SPADES & MORRIS	JOB NO.	SHT. 22
	DATE				SCALE 1" = 50'	OF 24
	CERTIFIED BY					
	DATE					