




GROUND ELEV 990'±
MAX. STATIC PR. 74 PSI±

GROUND ELEV 990'±
MAX. STATIC PR. 78 PSI±

NOTE: Sunman Telephone Company has buried telephone cable on Spades Road right-of-way at various locations. Telephone utility will locate and mark buried cable at time of construction. Contact Hank Miles or Bob Keith at Sunman Telephone Company at 812-623-3822.

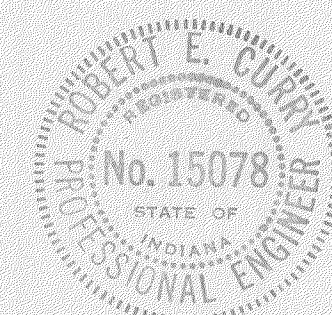

AS - BUILT
9 - 21 - 88

REVISIONS	DRAWN BY	J.T., J.L.	ROBERT E. CURRY & ASSOCIATES, INC. CONSULTING ENGINEERS	ELROD WATER COMPANY, INC. RIPLEY COUNTY, INDIANA	WATER MAIN EXTENSIONS SERVING S.R. 46 & TWIN OAKS AREA	JOB NO.	SHT.
	DATE	6-23-87					14
	CERTIFIED BY	R.E. CURRY				SCALE	OF
	DATE	6-30-87				1" = 50'	16