




GROUND ELEV. 970'±
MAX. STATIC PR. 82 PSI ±

GENE STAUTBERG
3151 ANNISTON DRIVE
CINCINNATI, OHIO 45248
513-922-5837

STATE ROAD 46

GROUND ELEV. 980'±
MAX. STATIC PR. 78 PSI ±

NOTE: Sunman Telephone Company has buried telephone cable on S.R. 46 right-of-way at various locations. Telephone utility will locate and mark buried cable at time of construction. Contact Hank Miles or Bob Keith at Sunman Telephone Company at 812-623-3822.

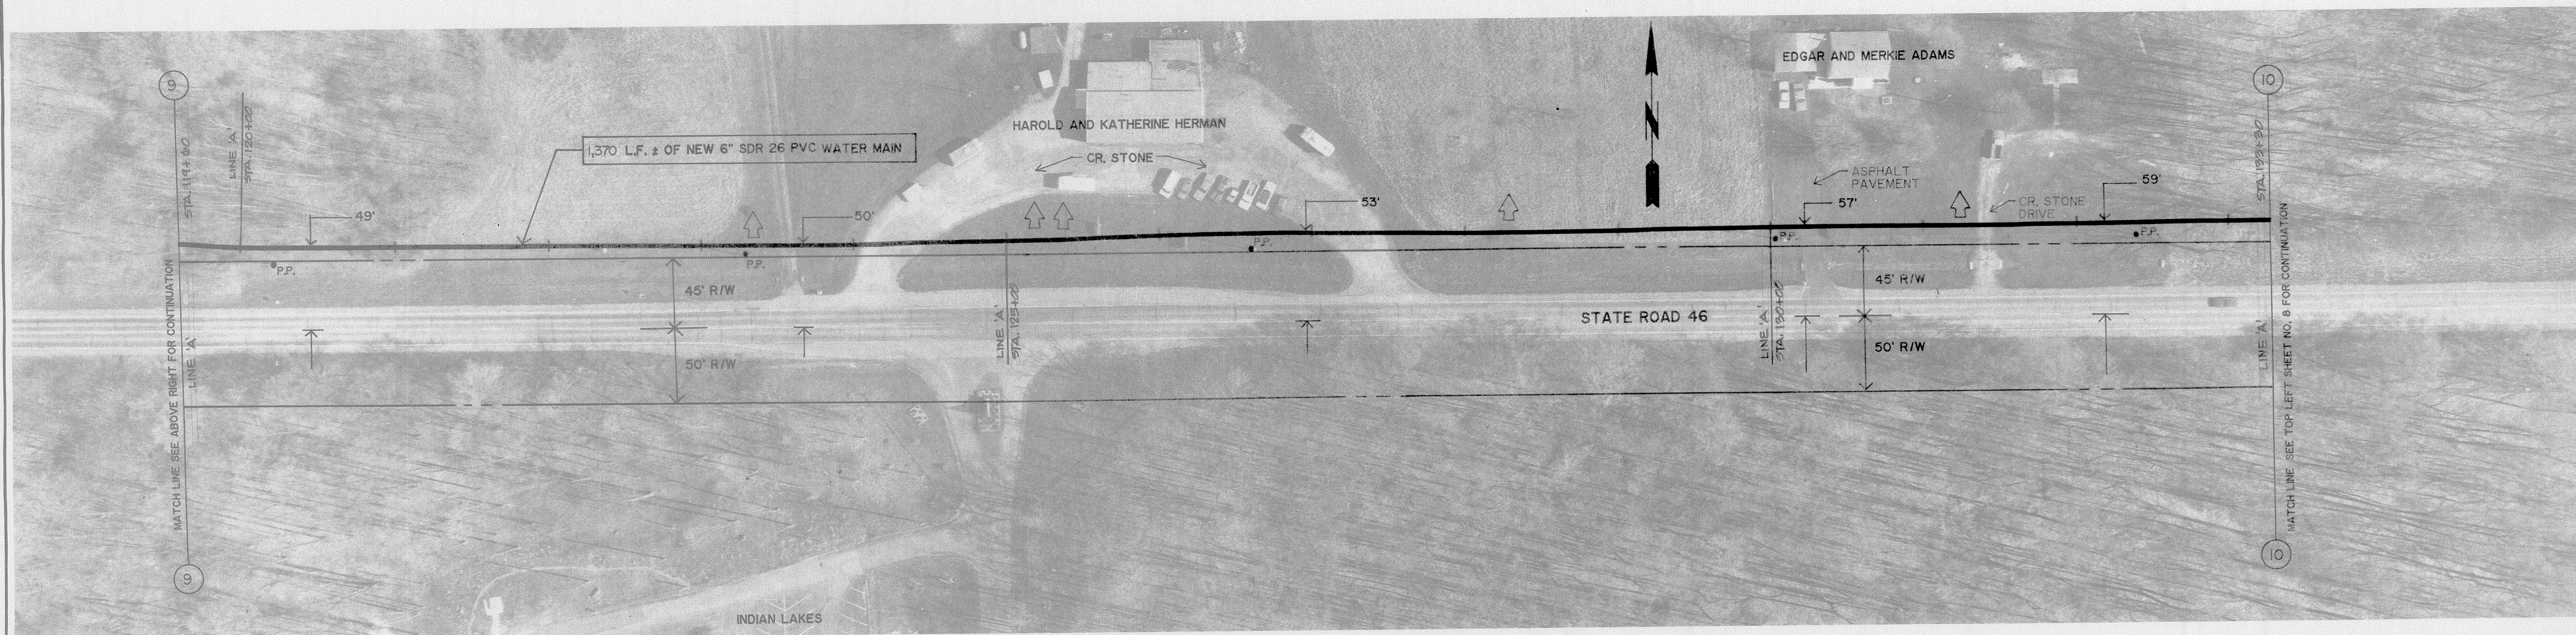

GROUND ELEV. 980'±
MAX. STATIC PR. 78 PSI ±

STATE ROAD 46

GROUND ELEV. 970'±
MAX. STATIC PR. 82 PSI ±

AS - BUILT
9 - 21 - 88

REVISIONS	DRAWN BY	J.T., J.L.	ROBERT E. CURRY & ASSOCIATES, INC. CONSULTING ENGINEERS	ELROD WATER COMPANY, INC. RIPLEY COUNTY, INDIANA	WATER MAIN EXTENSIONS SERVING S.R. 46 & TWIN OAKS AREA	JOB NO.	SHT. 7
	DATE	6-23-87				SCALE 1" = 50'	OF 16
	CERTIFIED BY	RE. CURRY					
	DATE	6-30-87					