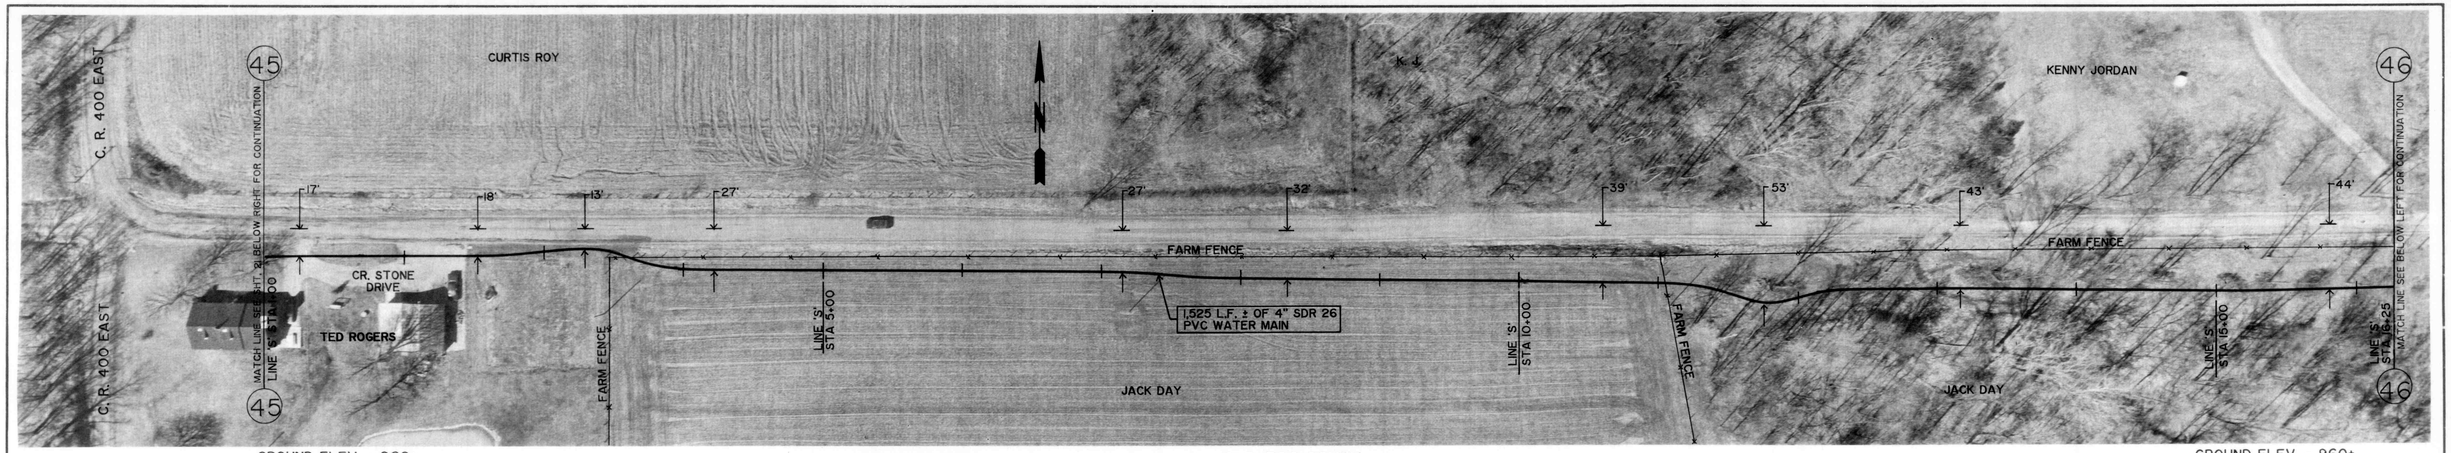

GROUND ELEV. = 960±
MAX STATIC PRESSURE = 78 PSI±

C. R. 300 SOUTH

GROUND ELEV. = 960±
MAX STATIC PRESSURE = 78 PSI±

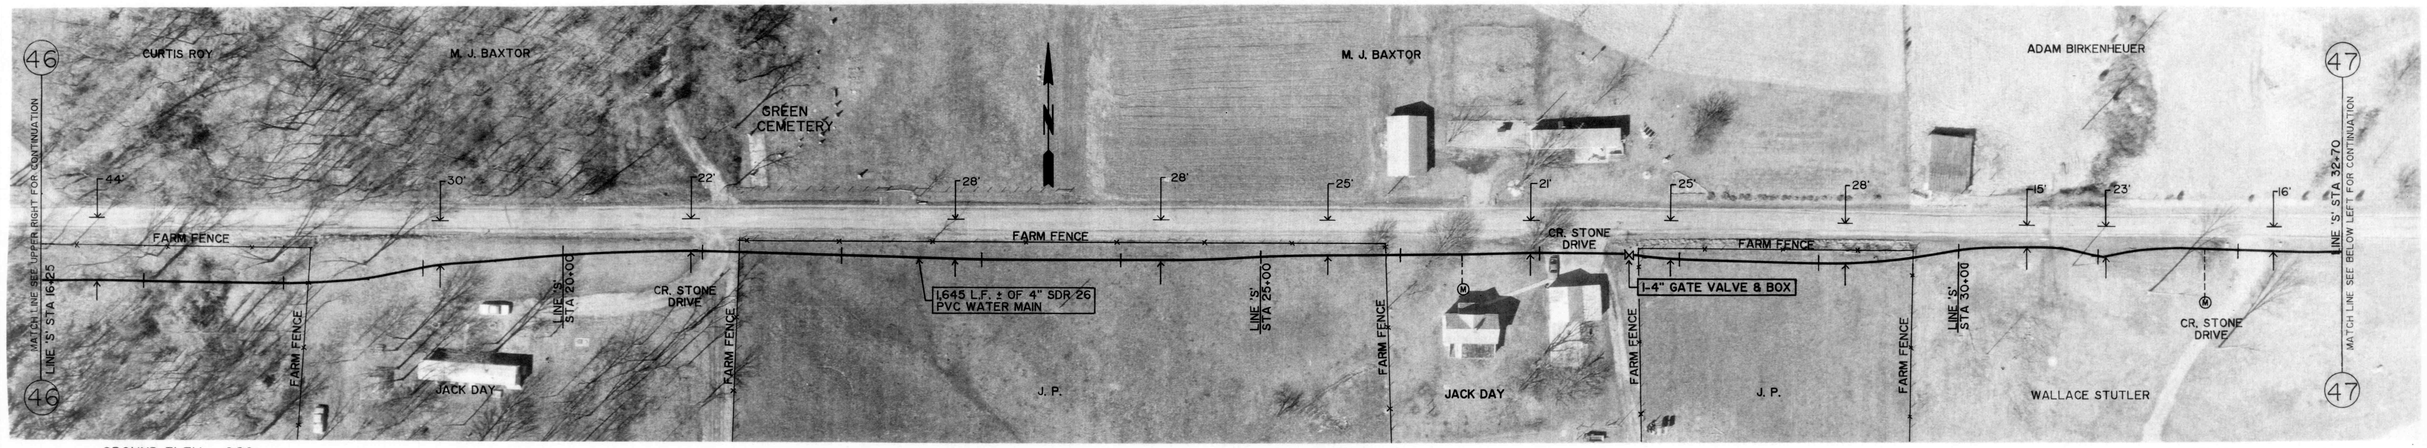

GROUND ELEV. = 960±
MAX STATIC PRESSURE = 78 PSI±

C. R. 300 SOUTH

GROUND ELEV. = 950±
MAX STATIC PRESSURE = 82 PSI±

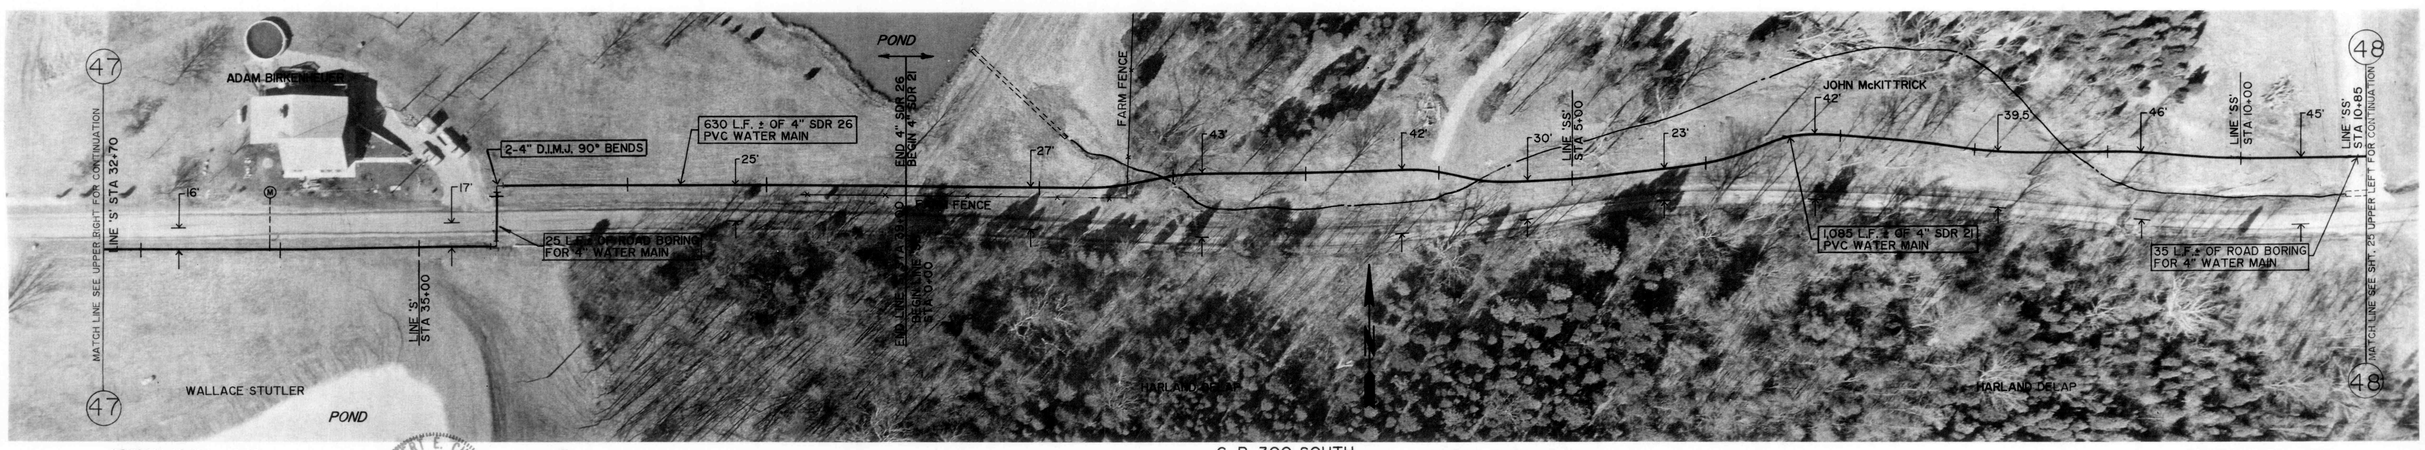

GROUND ELEV. = 950±
MAX STATIC PRESSURE = 82 PSI±

C. R. 300 SOUTH

GROUND ELEV. = 900±
MAX STATIC PRESSURE = 113 PSI±

GROUND ELEV. = 880±
MAX STATIC PRESSURE = 112 PSI±

ROBERT E. CURRY REGISTERED No. 15078 STATE OF INDIANA PROFESSIONAL ENGINEER

Robert E. Curry

AS BUILT 10-17-90

REVISIONS					
DRAWN BY	D. D. E.	ROBERT E. CURRY & ASSOCIATES, INC. CONSULTING ENGINEERS	ELROD WATER COMPANY INC. DIVISION "C" DISTRIBUTION SYSTEM EXTENSIONS	C. R. 300 SOUTH BEGINNING AT C. R. 400 EAST 4" WATER MAIN	JOB NO. / SHT. 24
DATE	7-17-89				SCALE 1" = 50' / OF 31
CERTIFIED BY	ROBERT E. CURRY				
DATE	7-17-89				