


GROUND ELEV. = 896.0 ±
MAX. STATIC PRESS. 114.3 PSI ±


GROUND ELEV. = 890.0 ±
MAX. STATIC PRESS. 116.9 PSI ±

GROUND ELEV. = 890.0 ±
MAX. STATIC PRESS. 116.9 PSI ±

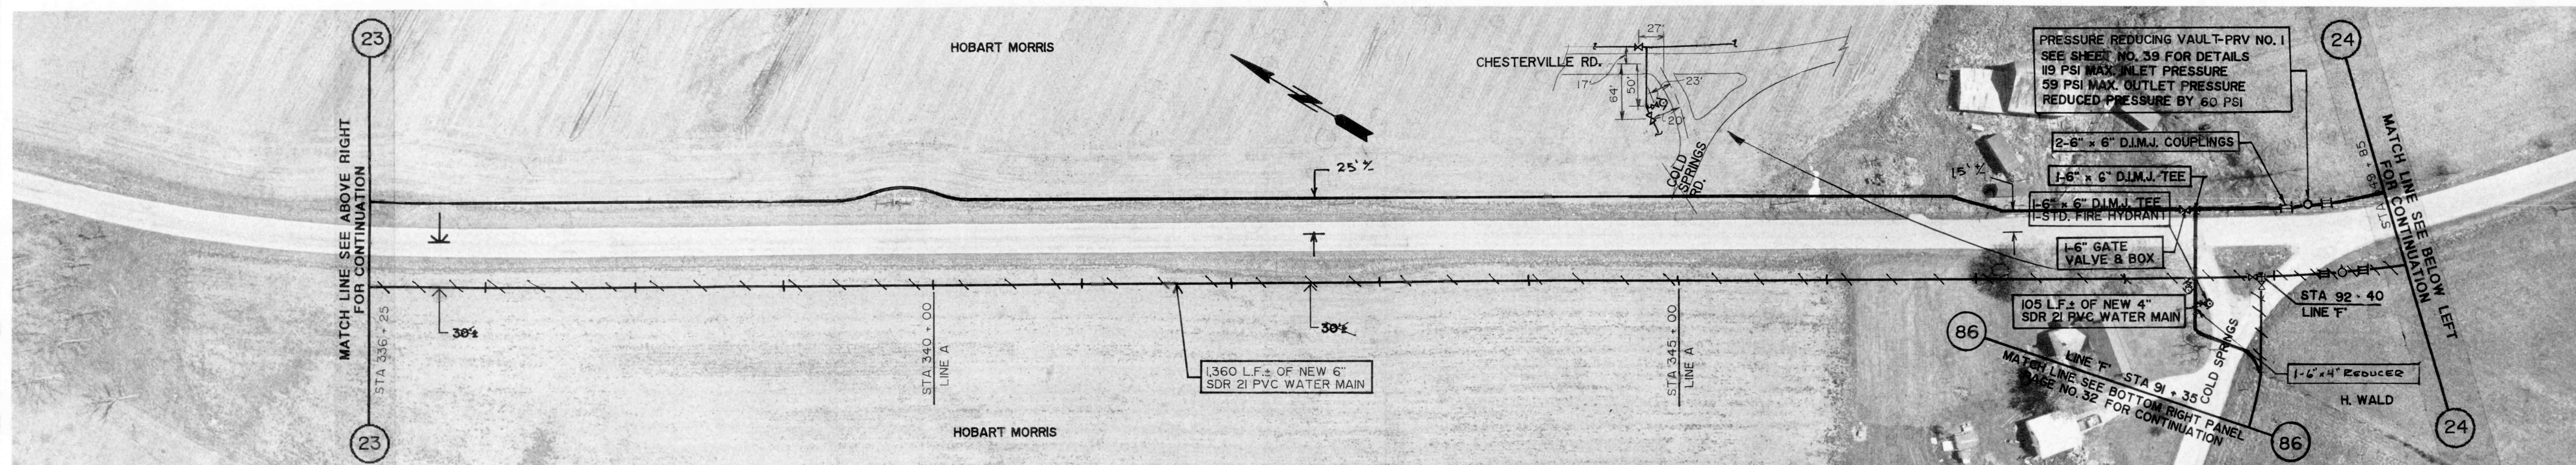

GROUND ELEV. = 890.0 ±
MAX. STATIC PRESS. 116.9 PSI ±

GROUND ELEV. = 885.0 ±
MAX. STATIC PRESS. 119.0 PSI ±
REDUCED PRESS. 59 PSI ±

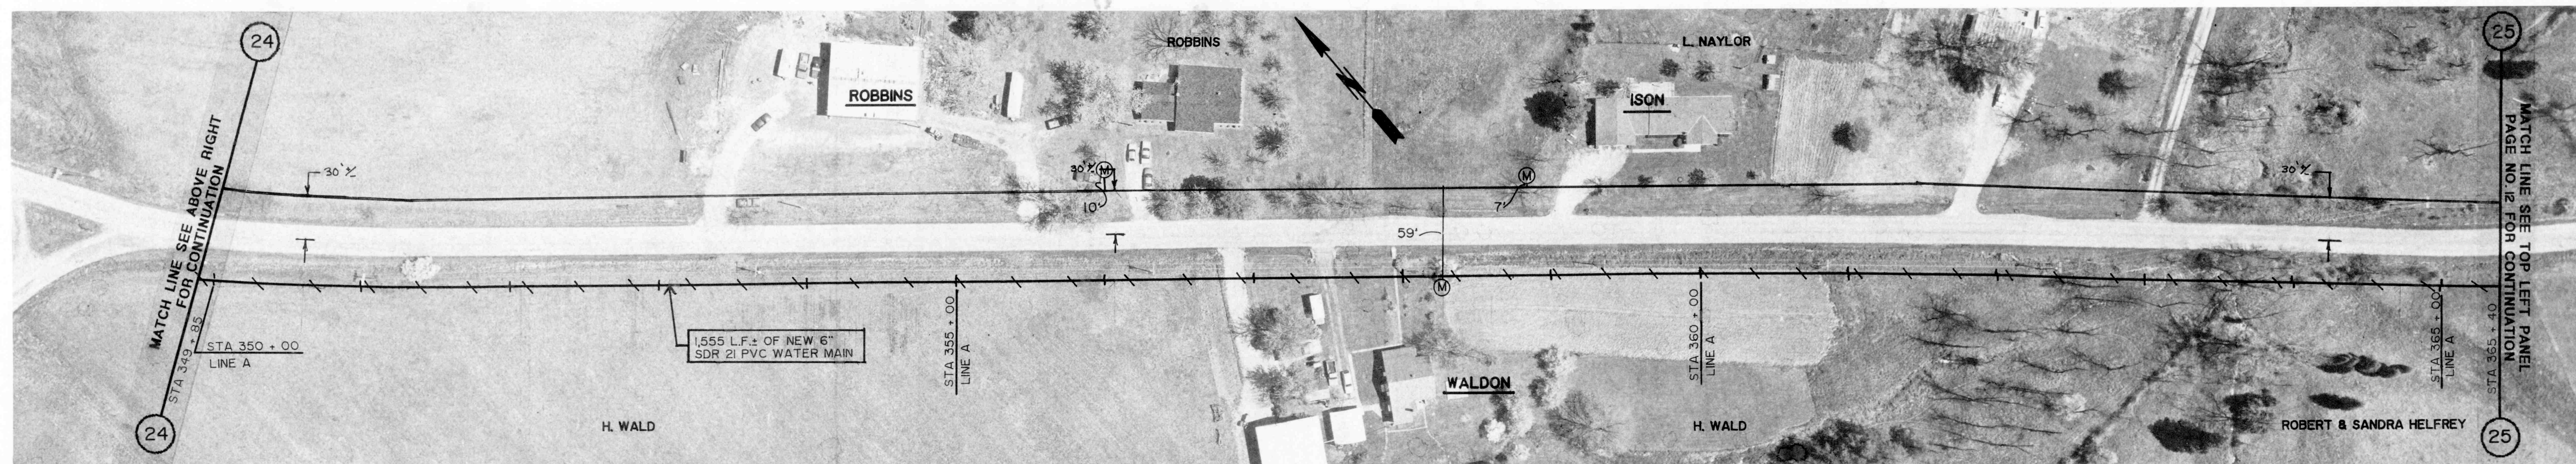

GROUND ELEV. = 885.0 ±
MAX. STATIC PRESS. 119.0 PSI ±
REDUCED PRESS. 59 PSI ±

GROUND ELEV. = 865.0 ±
MAX. STATIC PRESS. 127.7 PSI ±
REDUCED PRESS. 67.7 PSI ±

REVISIONS

ROBERT E. CURRY
No. 15078
REGISTERED PROFESSIONAL ENGINEER
STATE OF OHIO
10/1/91
10/1/91

ROBERT E. CURRY & ASSOCIATES, INC.
CONSULTING ENGINEERS

ELROD WATER COMPANY INC.
DIVISION "D" DISTRIBUTION SYSTEM EXTENSIONS

6" PVC WATER MAIN
EXTENSION ALONG
CHESTERVILLE ROAD

JOB NO. SHT. 11
SCALE OF 1" = 50' 43