


GROUND ELEV. = 860.0 ±
MAX. STATIC PRESS. = 129.9 PSI ±
REDUCED PRESS. 69.9 PSI ±

CHESTERVILLE ROAD


GROUND ELEV. = 856.0 ±
MAX. STATIC PRESS. = 131.6 PSI ±
REDUCED PRESS. 71.6 PSI ±

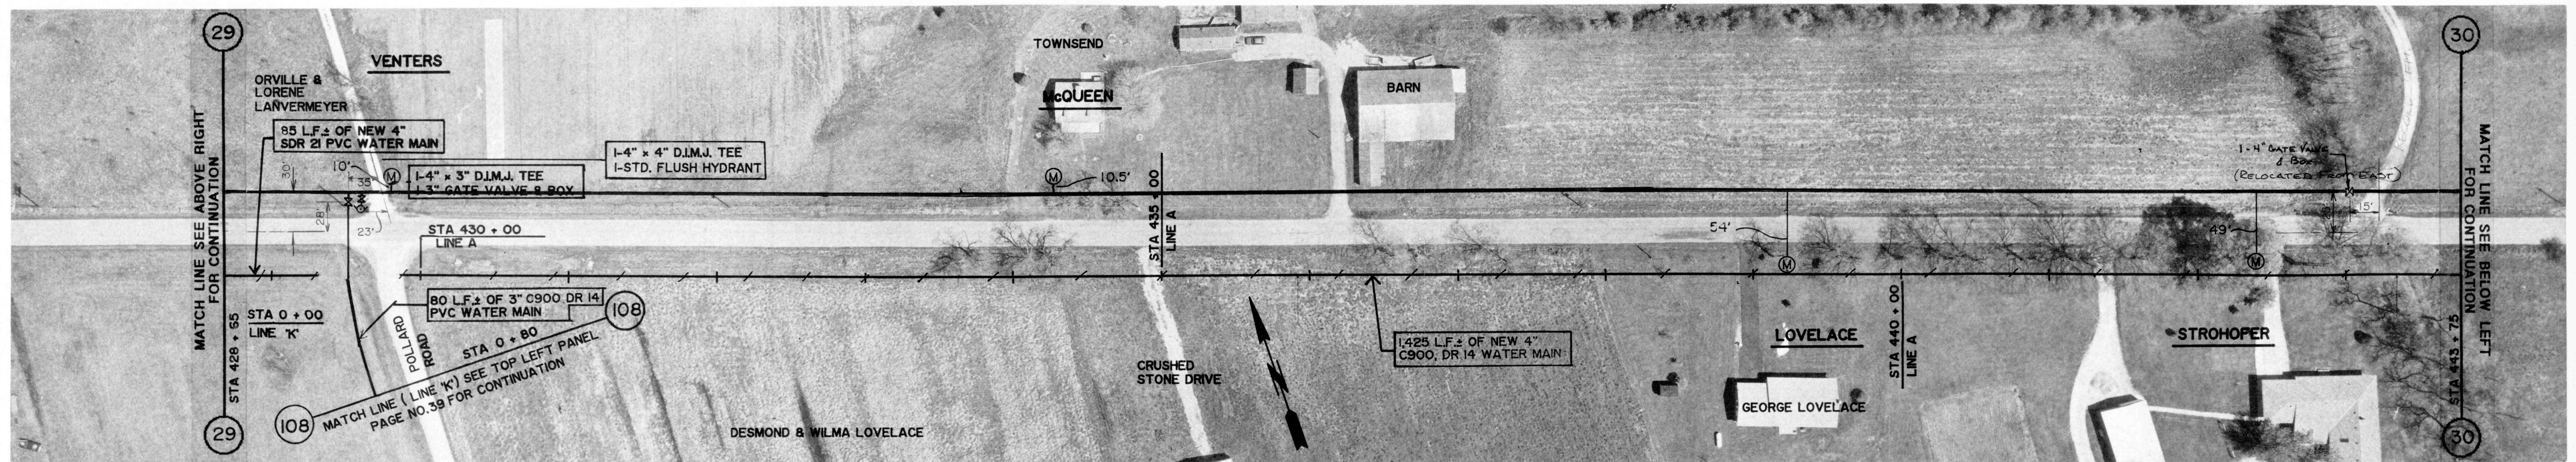

GROUND ELEV. = 856.0 ±
MAX. STATIC PRESS. = 131.6 PSI ±
REDUCED PRESS. 71.6 PSI ±

CHESTERVILLE ROAD

GROUND ELEV. = 845.0 ±
MAX. STATIC PRESS. = 136.4 PSI ±
REDUCED PRESS. 76.4 PSI ±

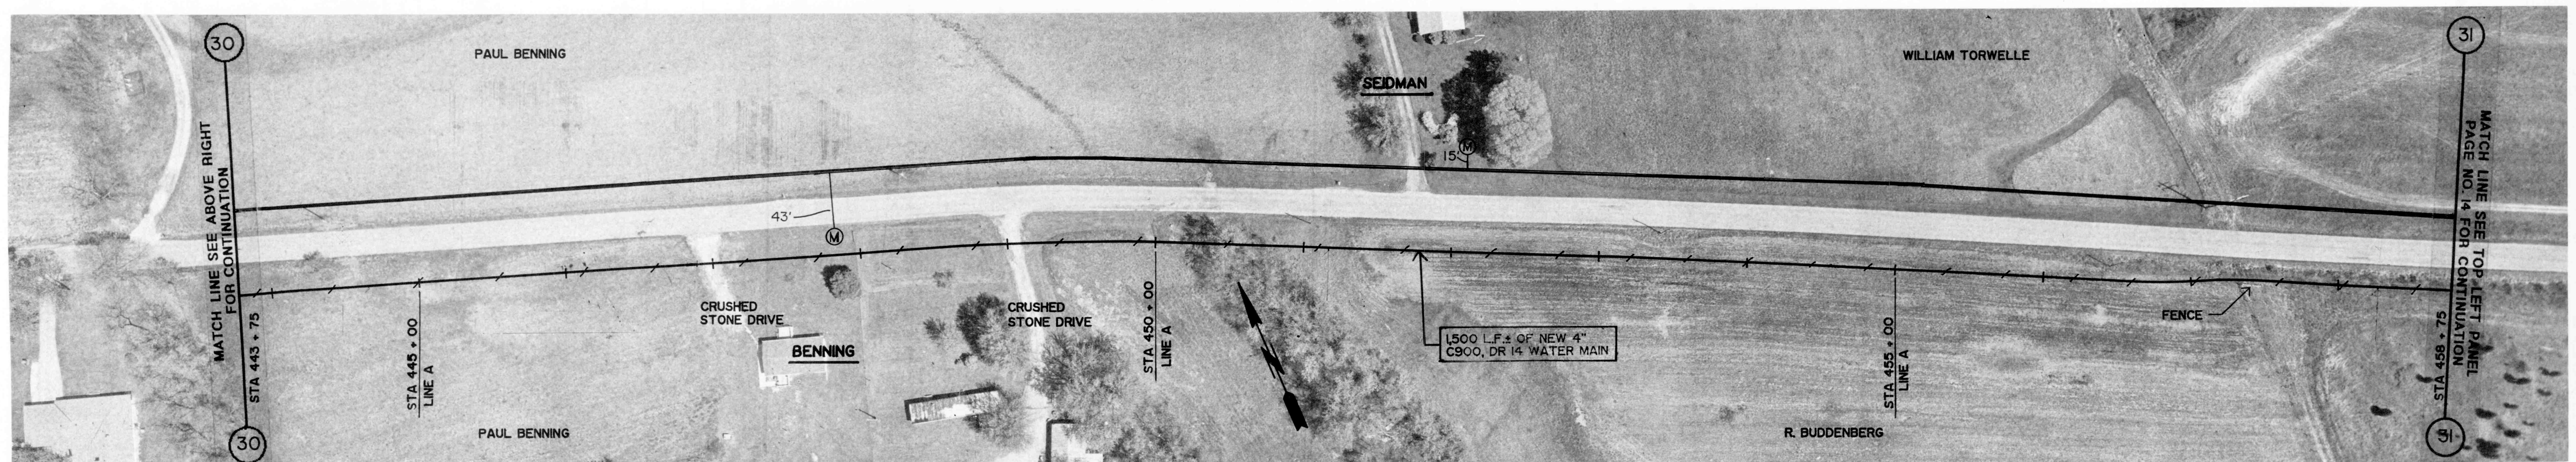

GROUND ELEV. = 845.0 ±
MAX. STATIC PRESS. = 136.4 PSI ±
REDUCED PRESS. 76.4 PSI ±

CHESTERVILLE ROAD

GROUND ELEV. = 830.0 ±
MAX. STATIC PRESS. = 142.9 PSI ±
REDUCED PRESS. 82.9 PSI ±

REVISIONS

DRAWN BY	RL
DATE	10/1/91
CERTIFIED BY	RE
DATE	10/1/91

ROBERT E. CURRY & ASSOCIATES, INC.
CONSULTING ENGINEERS

ELROD WATER COMPANY INC.
DIVISION "D" DISTRIBUTION SYSTEM EXTENSIONS

4" PVC WATER MAIN
EXTENSION ALONG
CHESTERVILLE ROAD

JOB NO.	SHT.
SCALE 1" = 50'	OF 43