


GROUND ELEV. = 780.0±
MAX. STATIC PRESS. = 164.5 PSI±
REDUCED PRESS. 29.5 PSI±

CHESTERVILLE ROAD

GROUND ELEV. = 670.0±
MAX. STATIC PRESS. = 212.0 PSI±
REDUCED PRESS. 77.0 PSI±

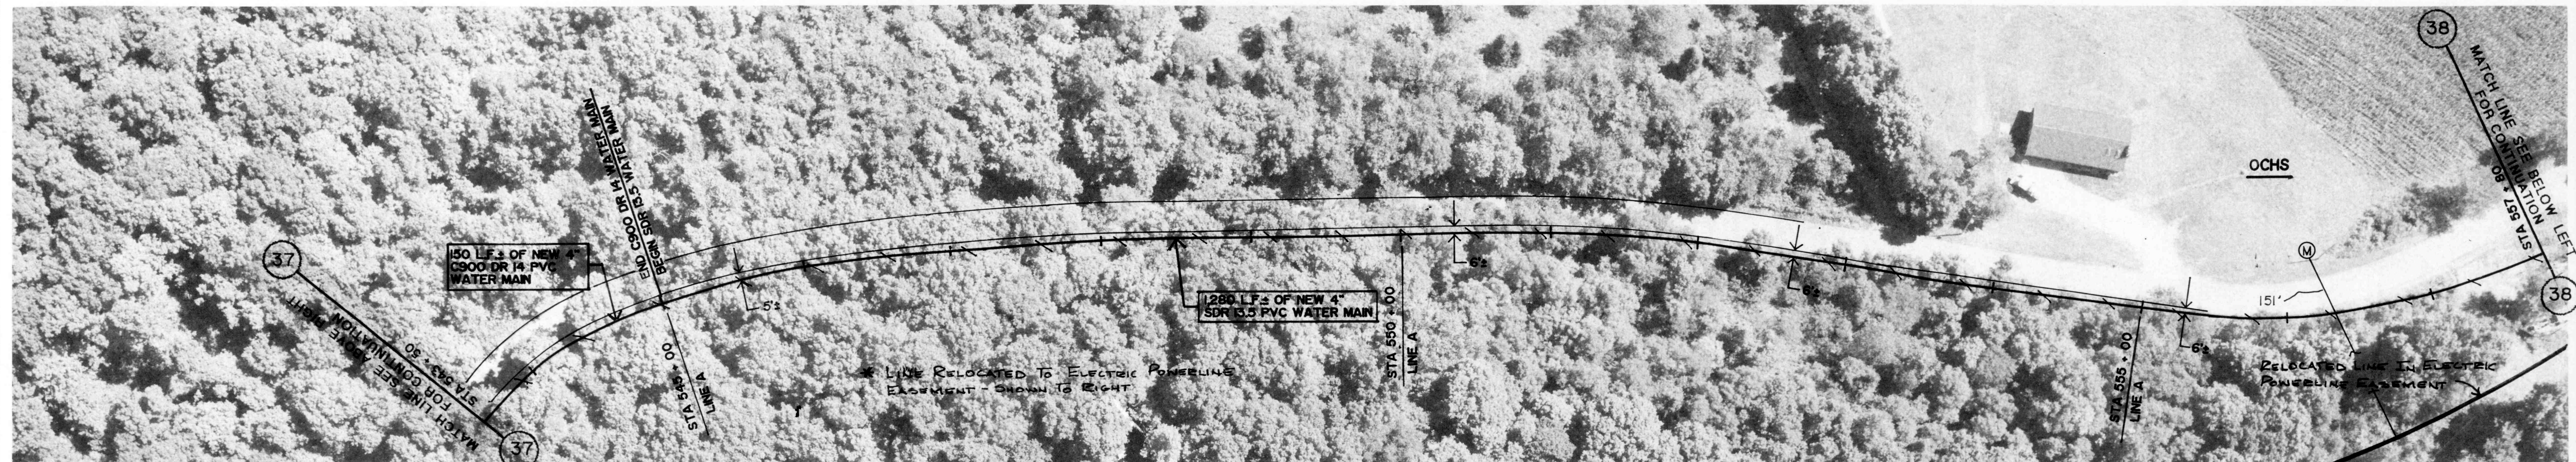

GROUND ELEV. = 670.0±
MAX. STATIC PRESS. = 212.0 PSI±
REDUCED PRESS. 77.0 PSI±

CHESTERVILLE ROAD

GROUND ELEV. = 530.0±
MAX. STATIC PRESS. = 273.0 PSI±
REDUCED PRESS. 138.0 PSI±



GROUND ELEV. = 530.0±
MAX. STATIC PRESS. = 273.0 PSI±
REDUCED PRESS. 138.0 PSI±

GROUND ELEV. = 500.0±
MAX. STATIC PRESS. = 285.7 PSI±
REDUCED PRESS. 150.7 PSI±

CHESTERVILLE ROAD

GROUND ELEV. = 510.0±
MAX. STATIC PRESS. = 282.7 PSI±
REDUCED PRESS. 147.7 PSI±

NOTE: D.N.R. PERMIT REQUIRED TO CROSS STREAM. OWNER TO OBTAIN PERMIT. STREAM CROSSING PER STANDARD STREAM CROSSING DETAIL.



ROBERT E. CURRY & ASSOCIATES, INC.
CONSULTING ENGINEERS

ELROD WATER COMPANY INC.
DIVISION "D" DISTRIBUTION SYSTEM EXTENSIONS

4" PVC WATER MAIN
EXTENSION ALONG
CHESTERVILLE ROAD

JOB NO.	SHT.
SCALE 1" = 50'	OF 43