



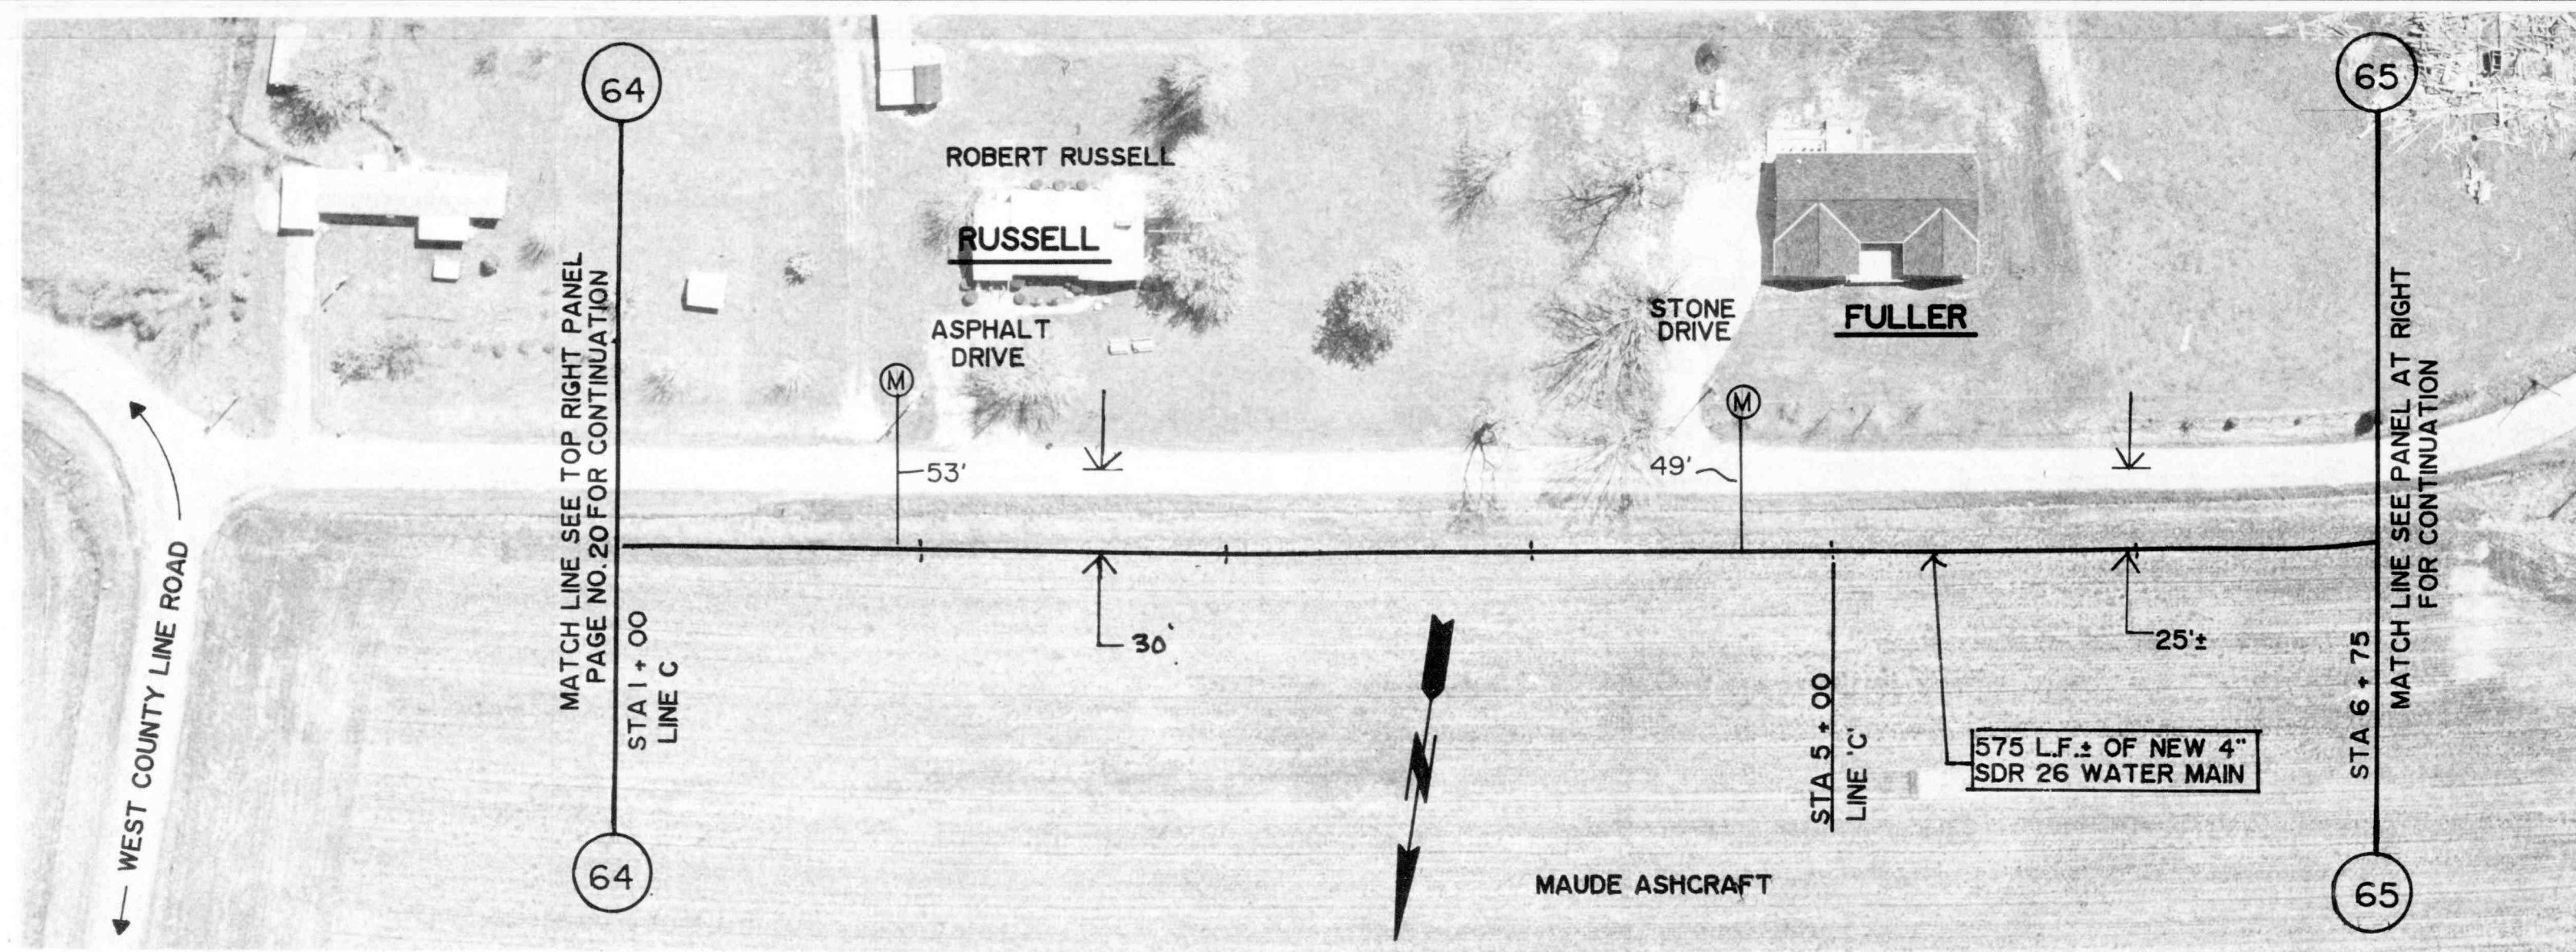


GROUND ELEV. = 993.0 ±
MAX. STATIC PRESS. = 72.3 PSI ±
COUNTY ROAD 50 NORTH

GROUND ELEV. = 1001.0 ±
MAX. STATIC PRESS. = 68.3 PSI ±

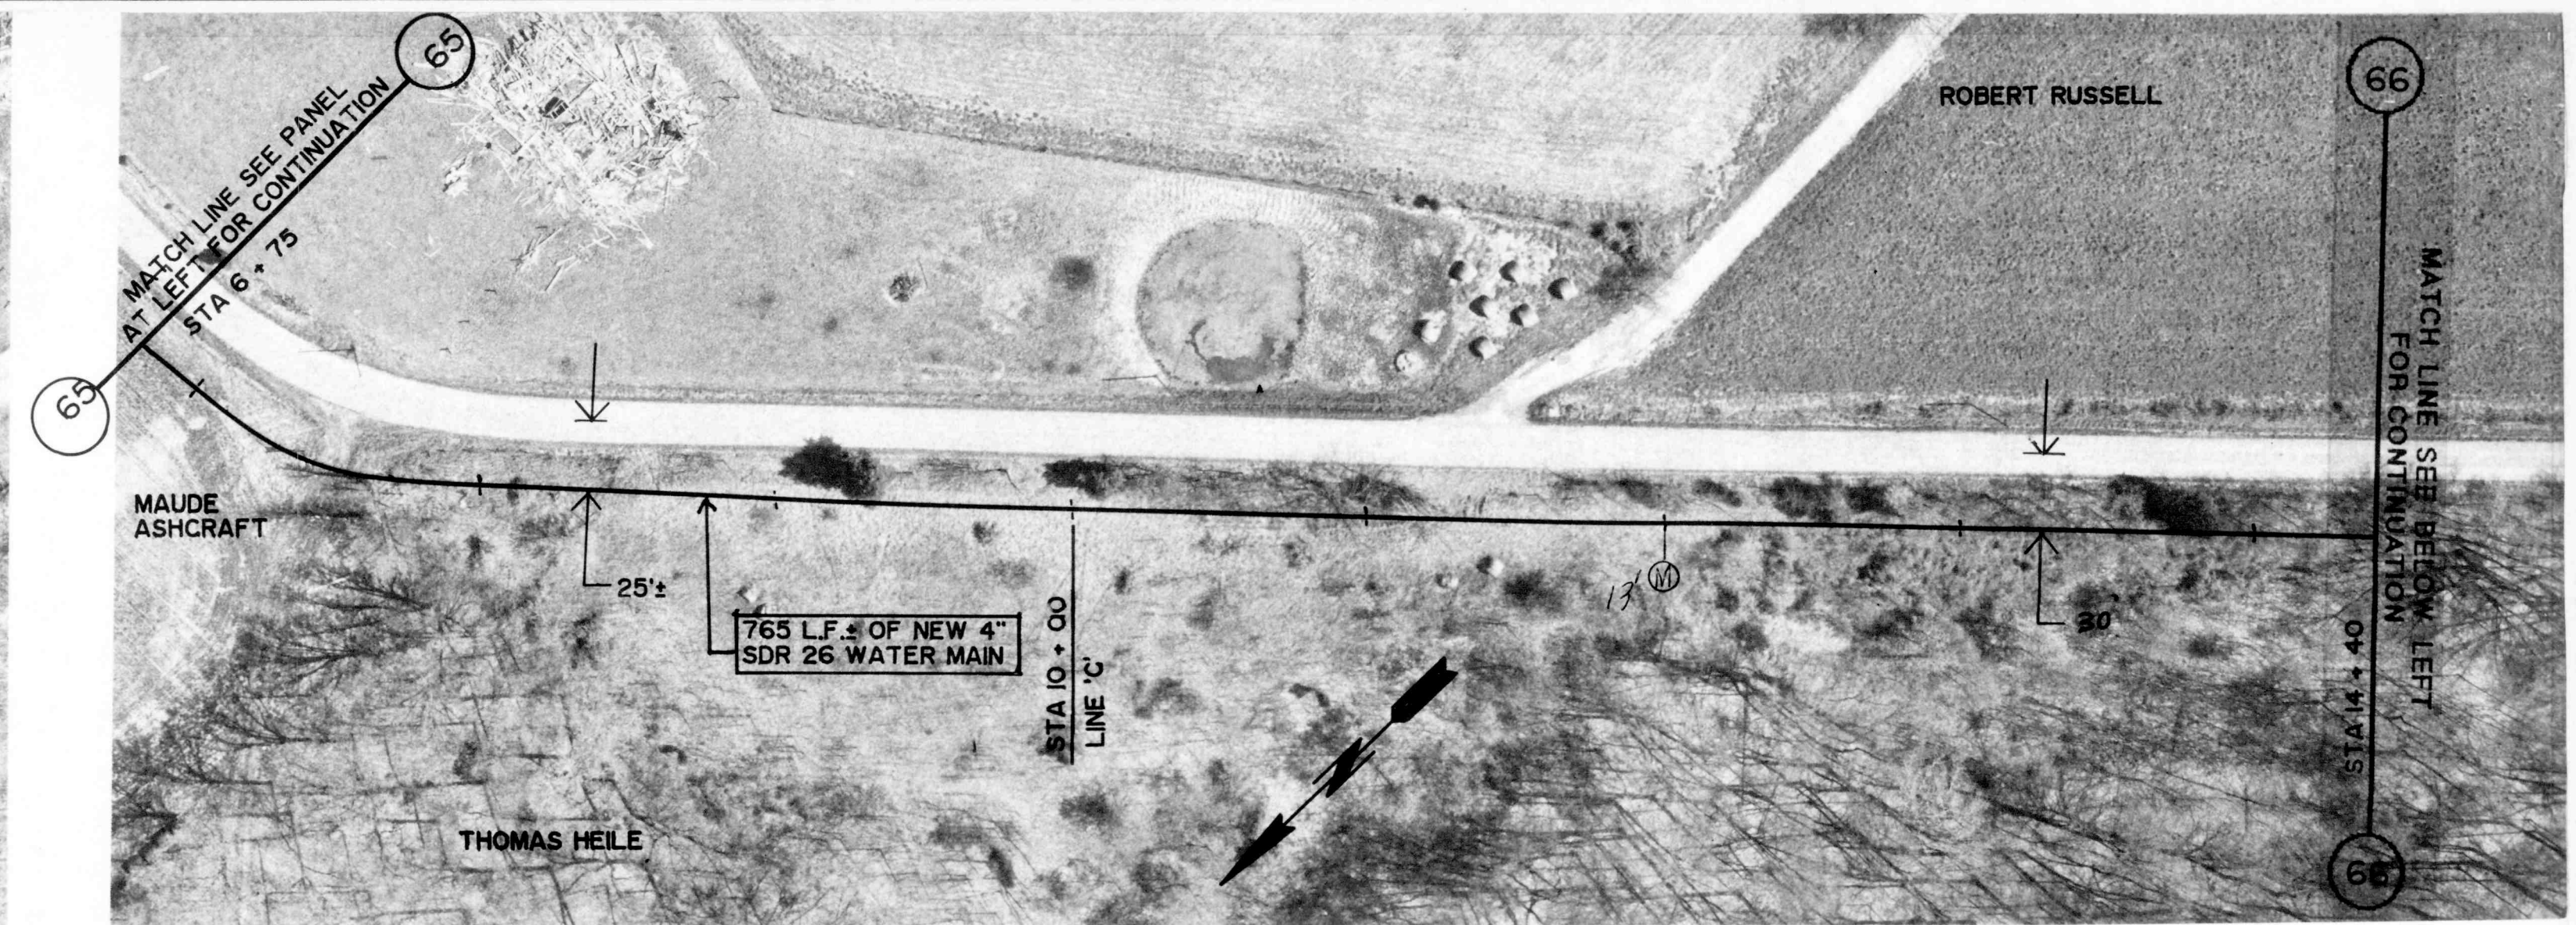


GROUND ELEV. = 1001.0 ±
MAX. STATIC PRESS. = 68.3 PSI ±
COUNTY ROAD 50 NORTH

GROUND ELEV. = 1000.0 ±
MAX. STATIC PRESS. = 69.3 PSI ±

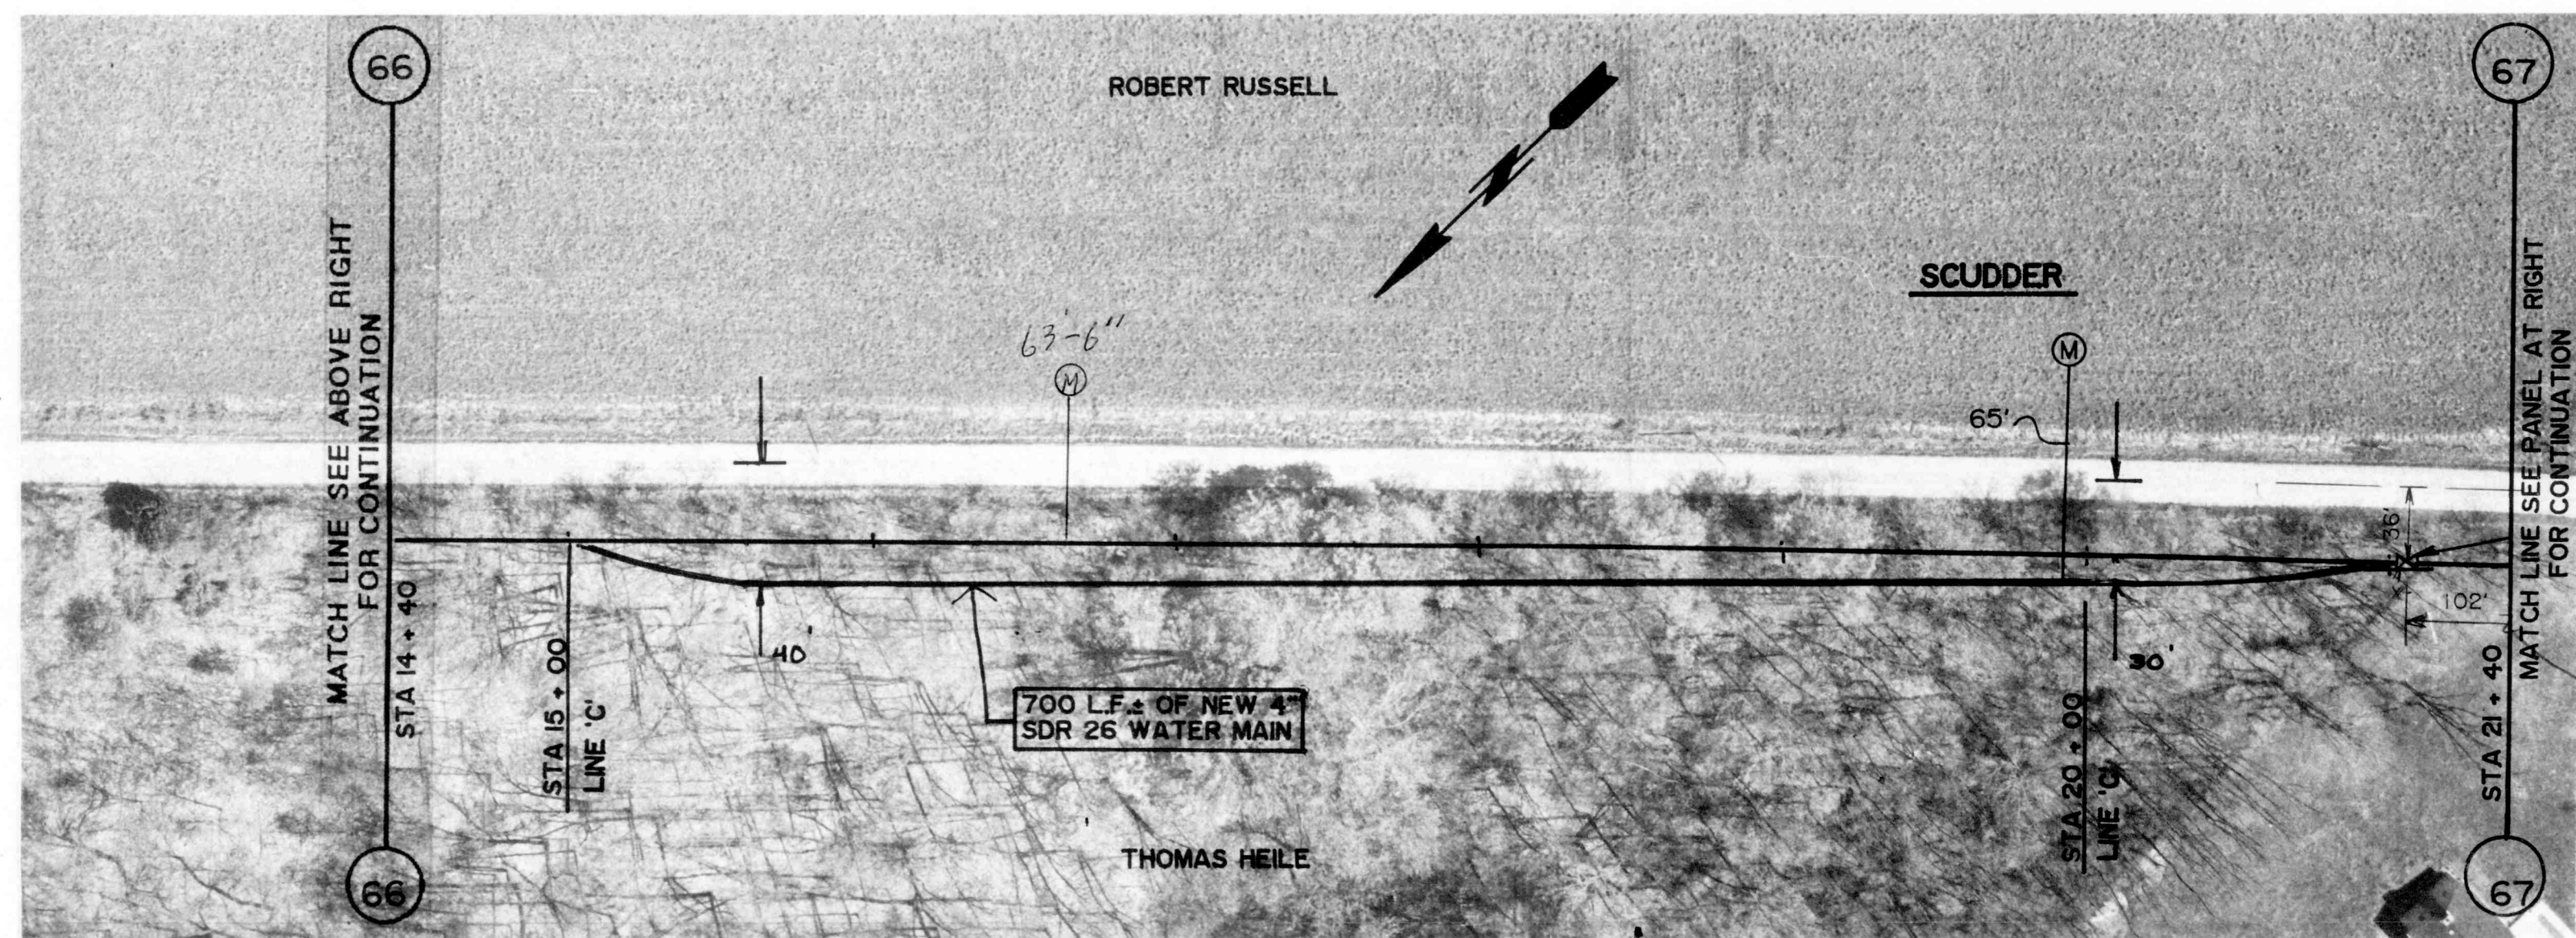

GROUND ELEV. = 1000.0 ±
MAX. STATIC PRESS. = 69.3 PSI ±
COUNTY ROAD 50 NORTH

GROUND ELEV. = 997.0 ±
MAX. STATIC PRESS. = 70.6 PSI ±

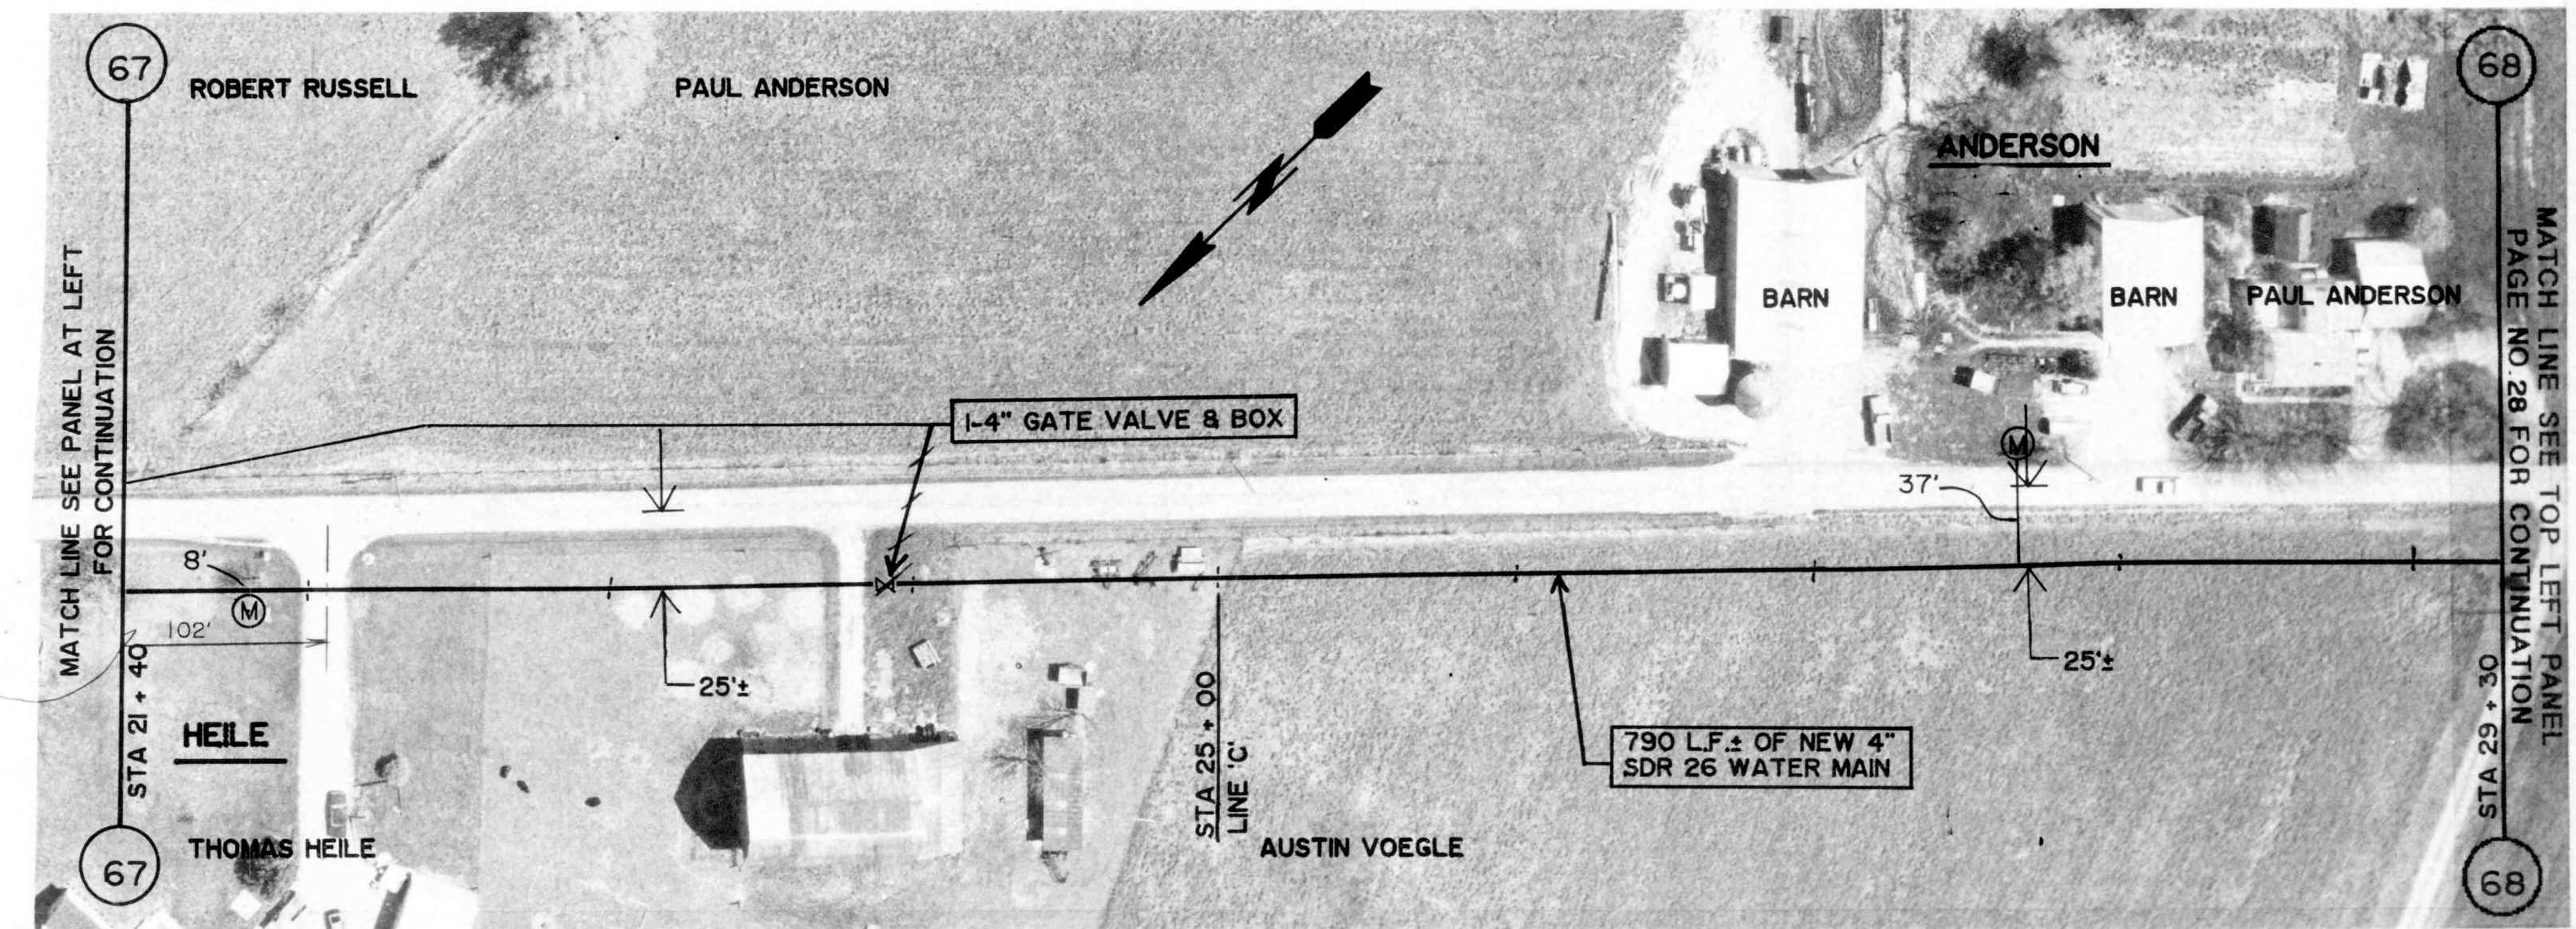

GROUND ELEV. = 997.0 ±
MAX. STATIC PRESS. = 70.6 PSI ±
COUNTY ROAD 50 NORTH

COUNTY ROAD 50 NORTH

GROUND ELEV. = 993.0 ±
MAX. STATIC PRESS. = 72.3 PSI ±



REVISIONS

DRAWN BY
DATE
CERTIFIED BY
DATE

ROBERT E. CURRY & ASSOCIATES, INC.
CONSULTING ENGINEERS

ELROD WATER COMPANY INC.
DIVISION "D" DISTRIBUTION SYSTEM EXTENSIONS

4" PVC WATER MAIN
EXTENSION ALONG
COUNTY ROAD 50 NORTH

JOB NO.
SCALE
SHT.
OF