


GROUND ELEV. = 870.0±
MAX. STATIC PRESS. = 126.0 PSI±

BARRETT ROAD


GROUND ELEV. = 850.0±
MAX. STATIC PRESS. = 134.0 PSI±

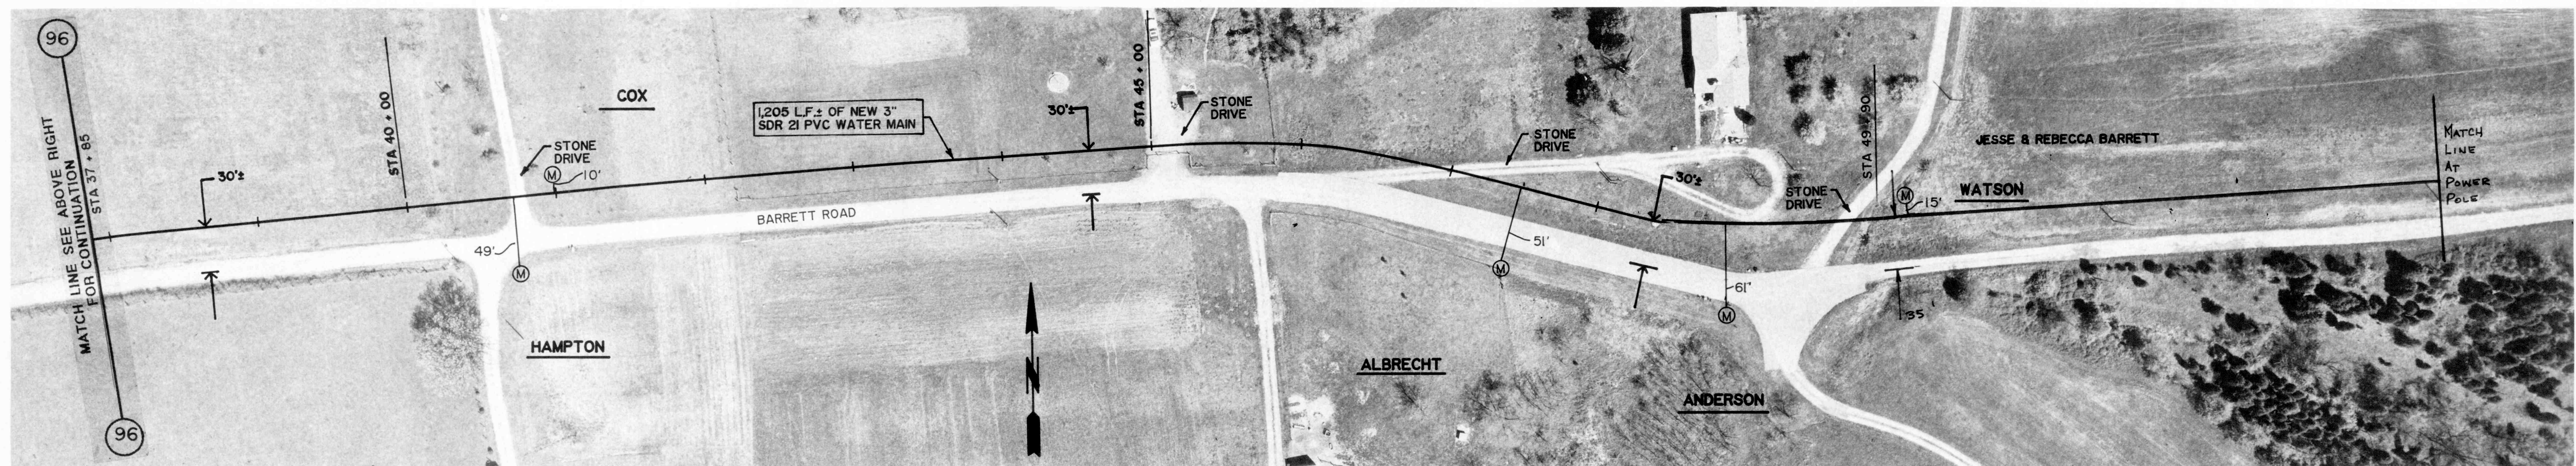

GROUND ELEV. = 850.0±
MAX. STATIC PRESS. = 134.0 PSI±

BARRETT ROAD

GROUND ELEV. = 860.0±
MAX. STATIC PRESS. = 130.0 PSI±

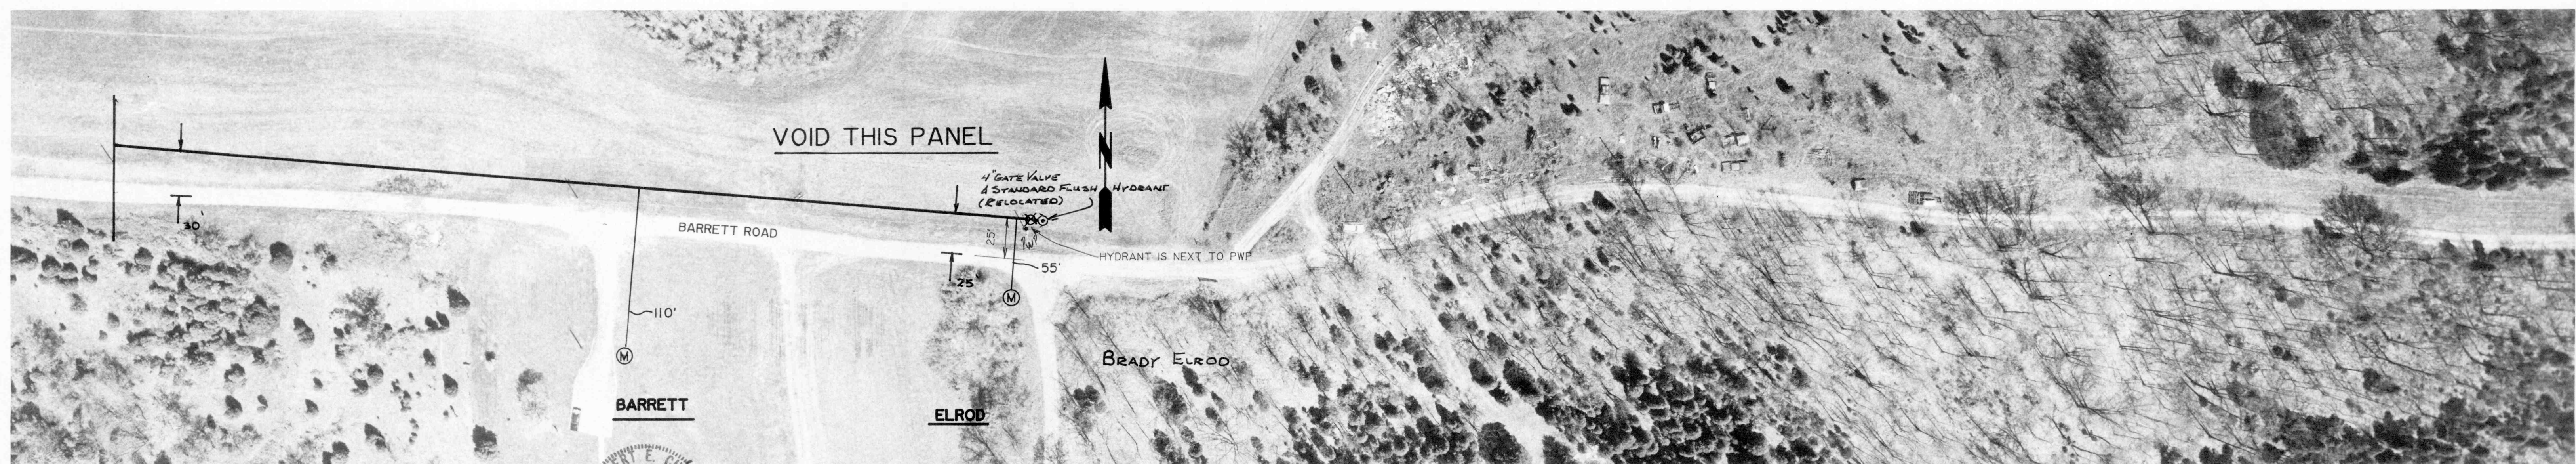

VOID THIS PANEL

BARRETT ROAD

VOID THIS PANEL



Robert E. Curry

REVISIONS

DRAWN BY	
DATE	10/1/91
CERTIFIED BY	REC
DATE	10/1/91

ROBERT E. CURRY & ASSOCIATES, INC.
CONSULTING ENGINEERS

ELROD WATER COMPANY INC.
DIVISION "D" DISTRIBUTION SYSTEM EXTENSIONS

3" PVC WATER MAIN
EXTENSION ALONG
BARRETT ROAD

JOB NO.	SHT. 35 A
SCALE 1" = 50'	OF 43